

GOVERNMENT CORNER RESTORATION FORM

Township 30 & 31S Range 1E Sec. 32 & 5 County DOUGLAS

State OREGON Date APRIL 6, 1983 No. _____

Corner Designation

QUARTER CORNER TO SECTIONS 32, T30S-R1E
AND 5, T31S-R1E.


- Condition Report Only
- Not Found
- Renewed
- Unrecorded
- Surveyed In
- Referenced Out

Previous Renewals

MONUMENT DETAIL

Monument(s) Found: (Condition and Source)

2 FT. D. MOUND OF STONE AND 1" D. IRON POST, 36" LONG,
LYING ON THE GROUND, WITH BRASS CAP MARKED AS
SHOWN SET BY G.L.O. IN 1923.

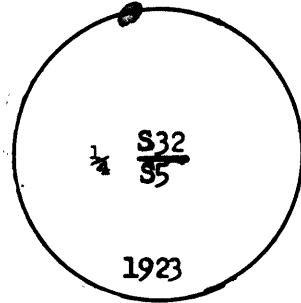

Accessories Found:

ORIGINAL BTs:

- A- 28" D. FIR SNAG, S78°W, 38.3 FT. WITH SCRIBE MARKS "1/4 S5 BT" VISIBLE ON PARTIALLY HEALED BLAZE.
- A- 1.2" D. FIR, N59°W, 17.8 FT. WITH FRAGMENTARY SCRIBE MARKS VISIBLE ON PARTIALLY HEALED BLAZE.

#46 T.30-1E ✓

G.L.O. No. 62/10-18c

RENEWAL

Monument Set (Procedure and Description)

Monument Detail


AT MOUND OF STONE DUG DOWN TO BEDROCK. MARKED "X"
IN BEDROCK AND RESET I.P. 2 1/4" IN 1/4 FT. D. MOUND OF STONE.
I STAMP "RESET 1983 L S 2024" ON BRASS CAP. (5-18-83).

New Accessories

NEW BT MARKED:

A- 6" I. CEDAR, S28°E, 43.3 FT. SCRIBED "1/4 S5 CS BT" ON SINGLE BLAZE.

Sketch of Monument, Accessories, and General Area

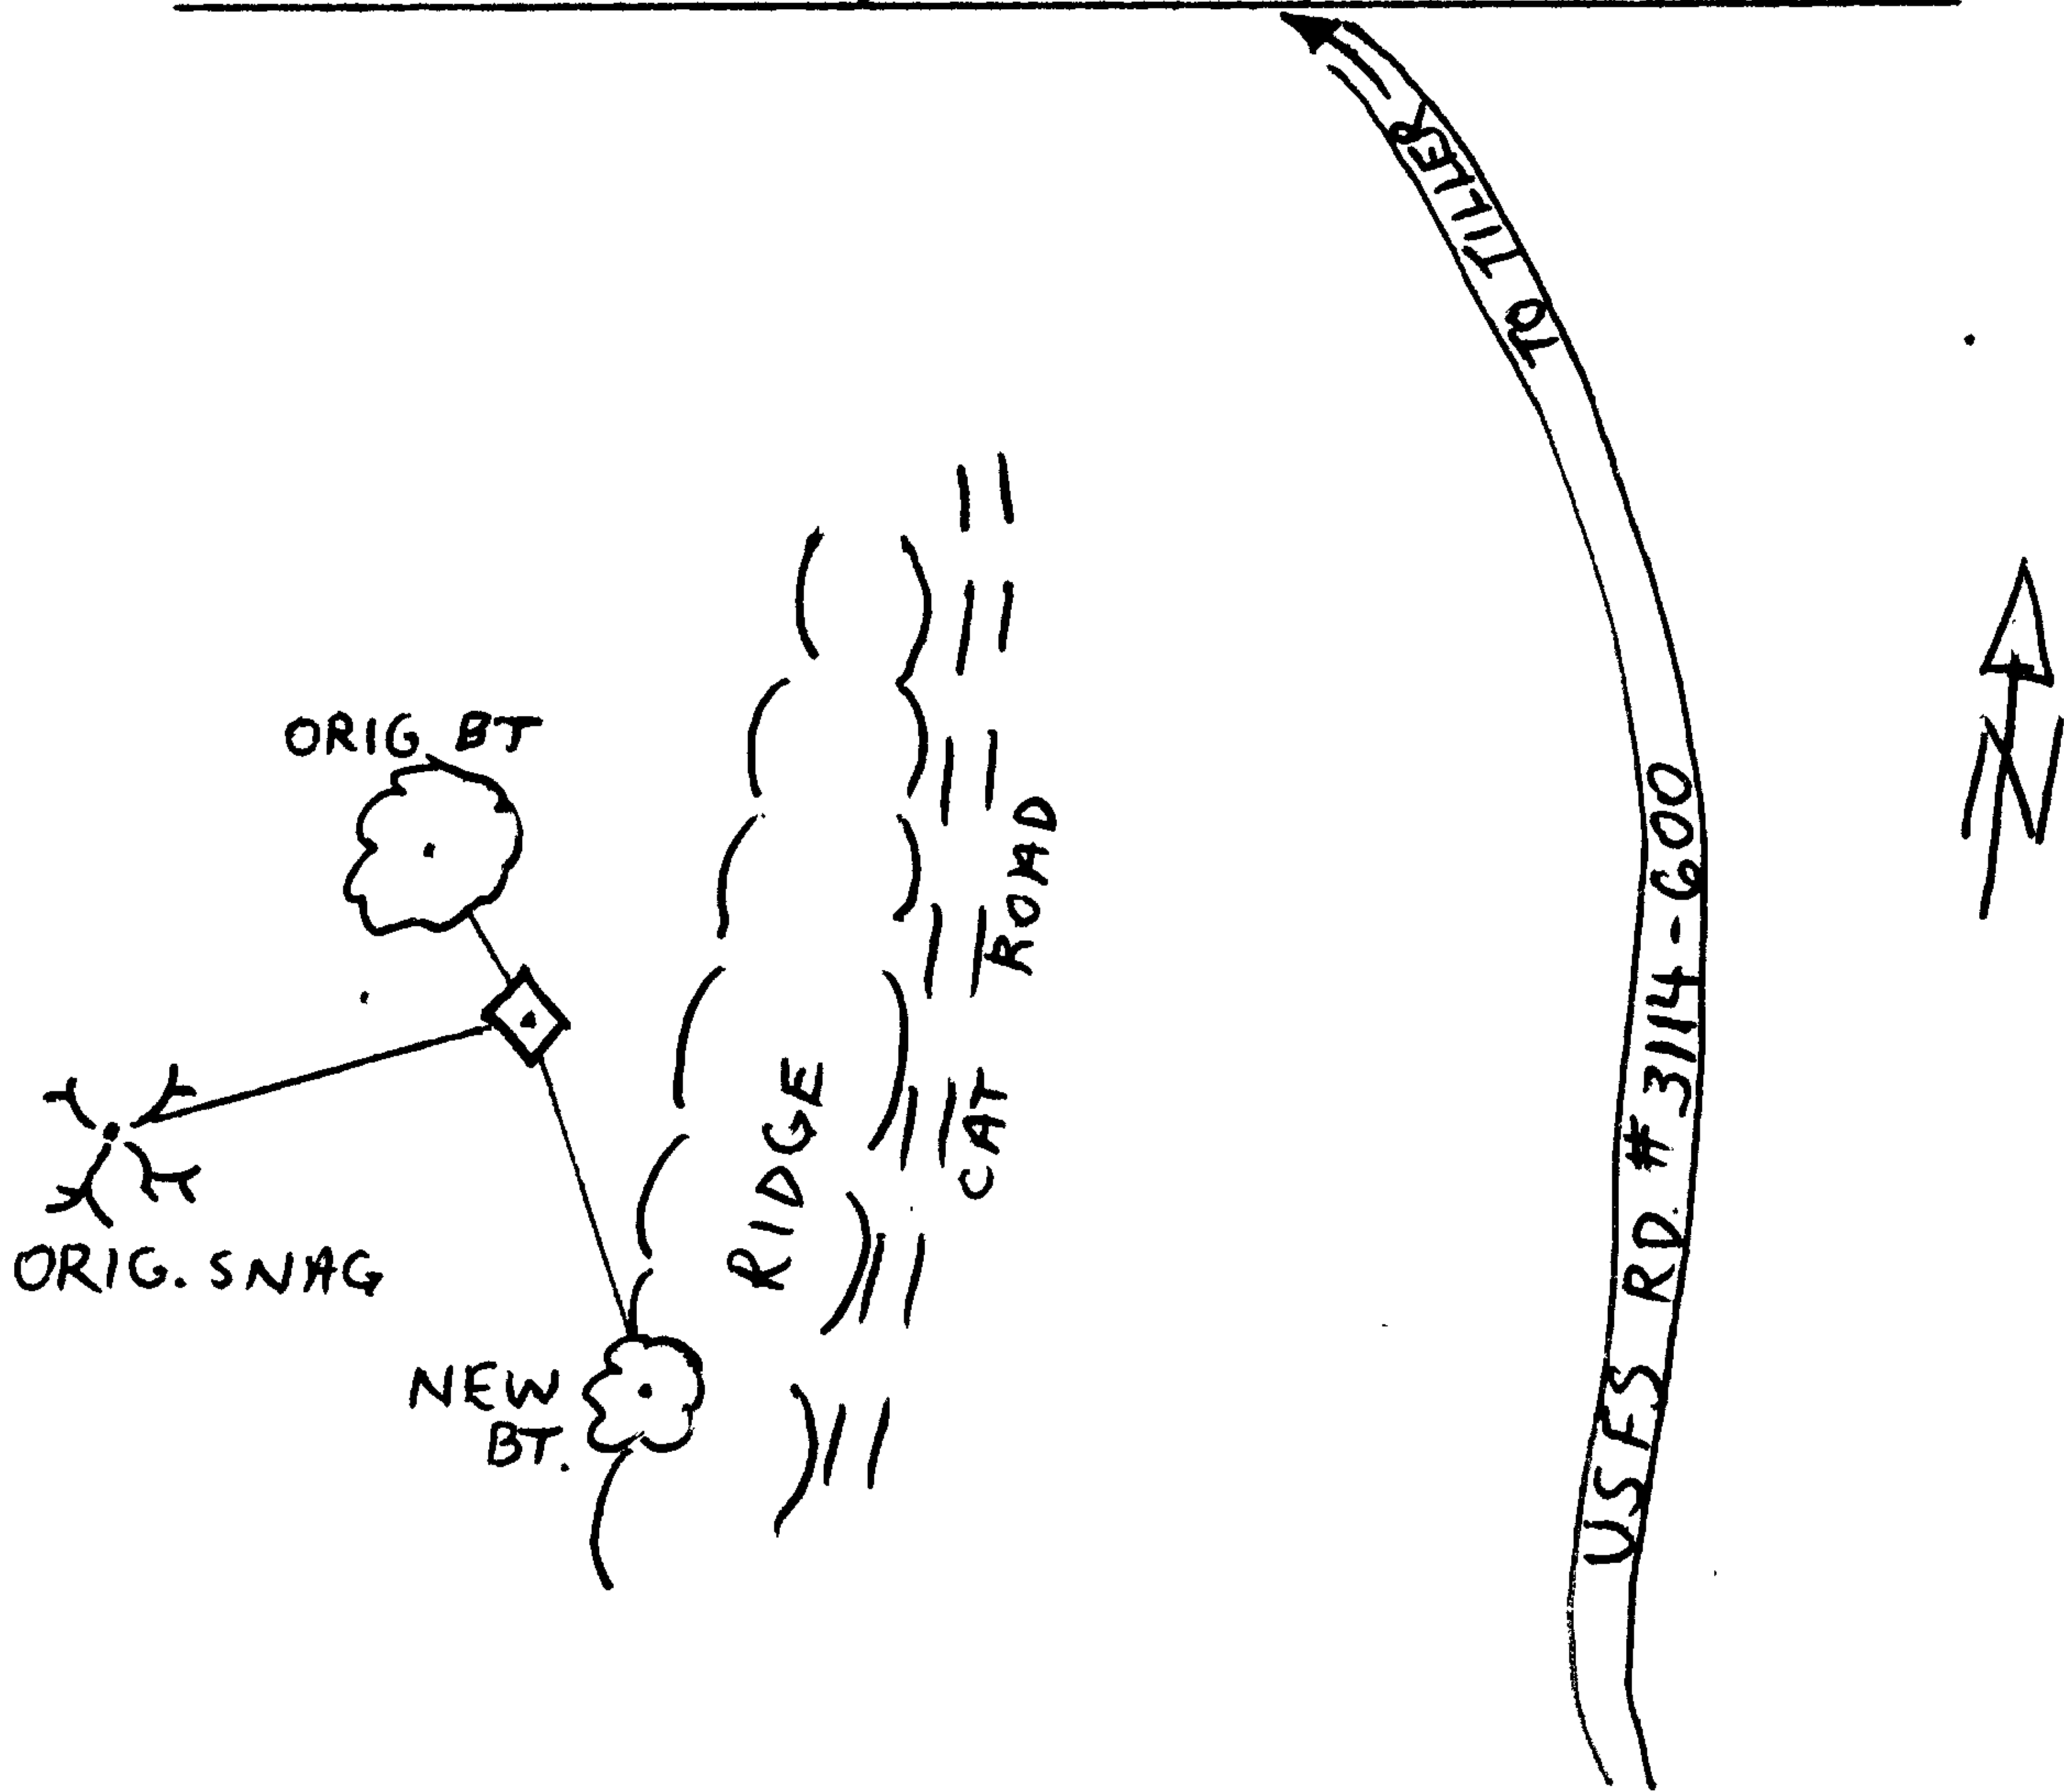

Location & Comments

CORNER IS APPROXIMATELY 140 FT.
WEST OF N-S RIDGE LINE AND 100 FT.
WEST OF USFS ROAD #3114-600.

Comp. Declin. 20°E
Agency U.S. FOREST SERVICE
Party Chief JIM LANDRUM, L S 2024
Notekeeper LEONARD HERZSTEIN
Witnesses LEONARD HERZSTEIN

Surveyor's Seal
REGISTERED
PROFESSIONAL
LAND SURVEYOR

Jim N. Landrum
OREGON
FEBRUARY 4, 1983
JAMES N. LANDRUM
2024