

RENEWAL

Monument Set (Procedure and Description)

Monument Detail

ADDED A 2 FOOT DIAMETER MOUND OF STONE. I.P. NOW PROJECTING 1".


New Accessories

I MARK NEW BTs:

- A 6" D. FIR, S11¹/₂°E, 12.8 FT., SCRIBED "T25S R2E S21 CS BT" ON A SINGLE BLAZE.
- A 6" D. FIR, S25¹/₂°W, 30.2 FT., SCRIBED "T25S R2E S20 CS BT" ON A SINGLE BLAZE.

NO AVAILABLE TREES IN SECTION 16.

Sketch of Monument, Accessories, and General Area

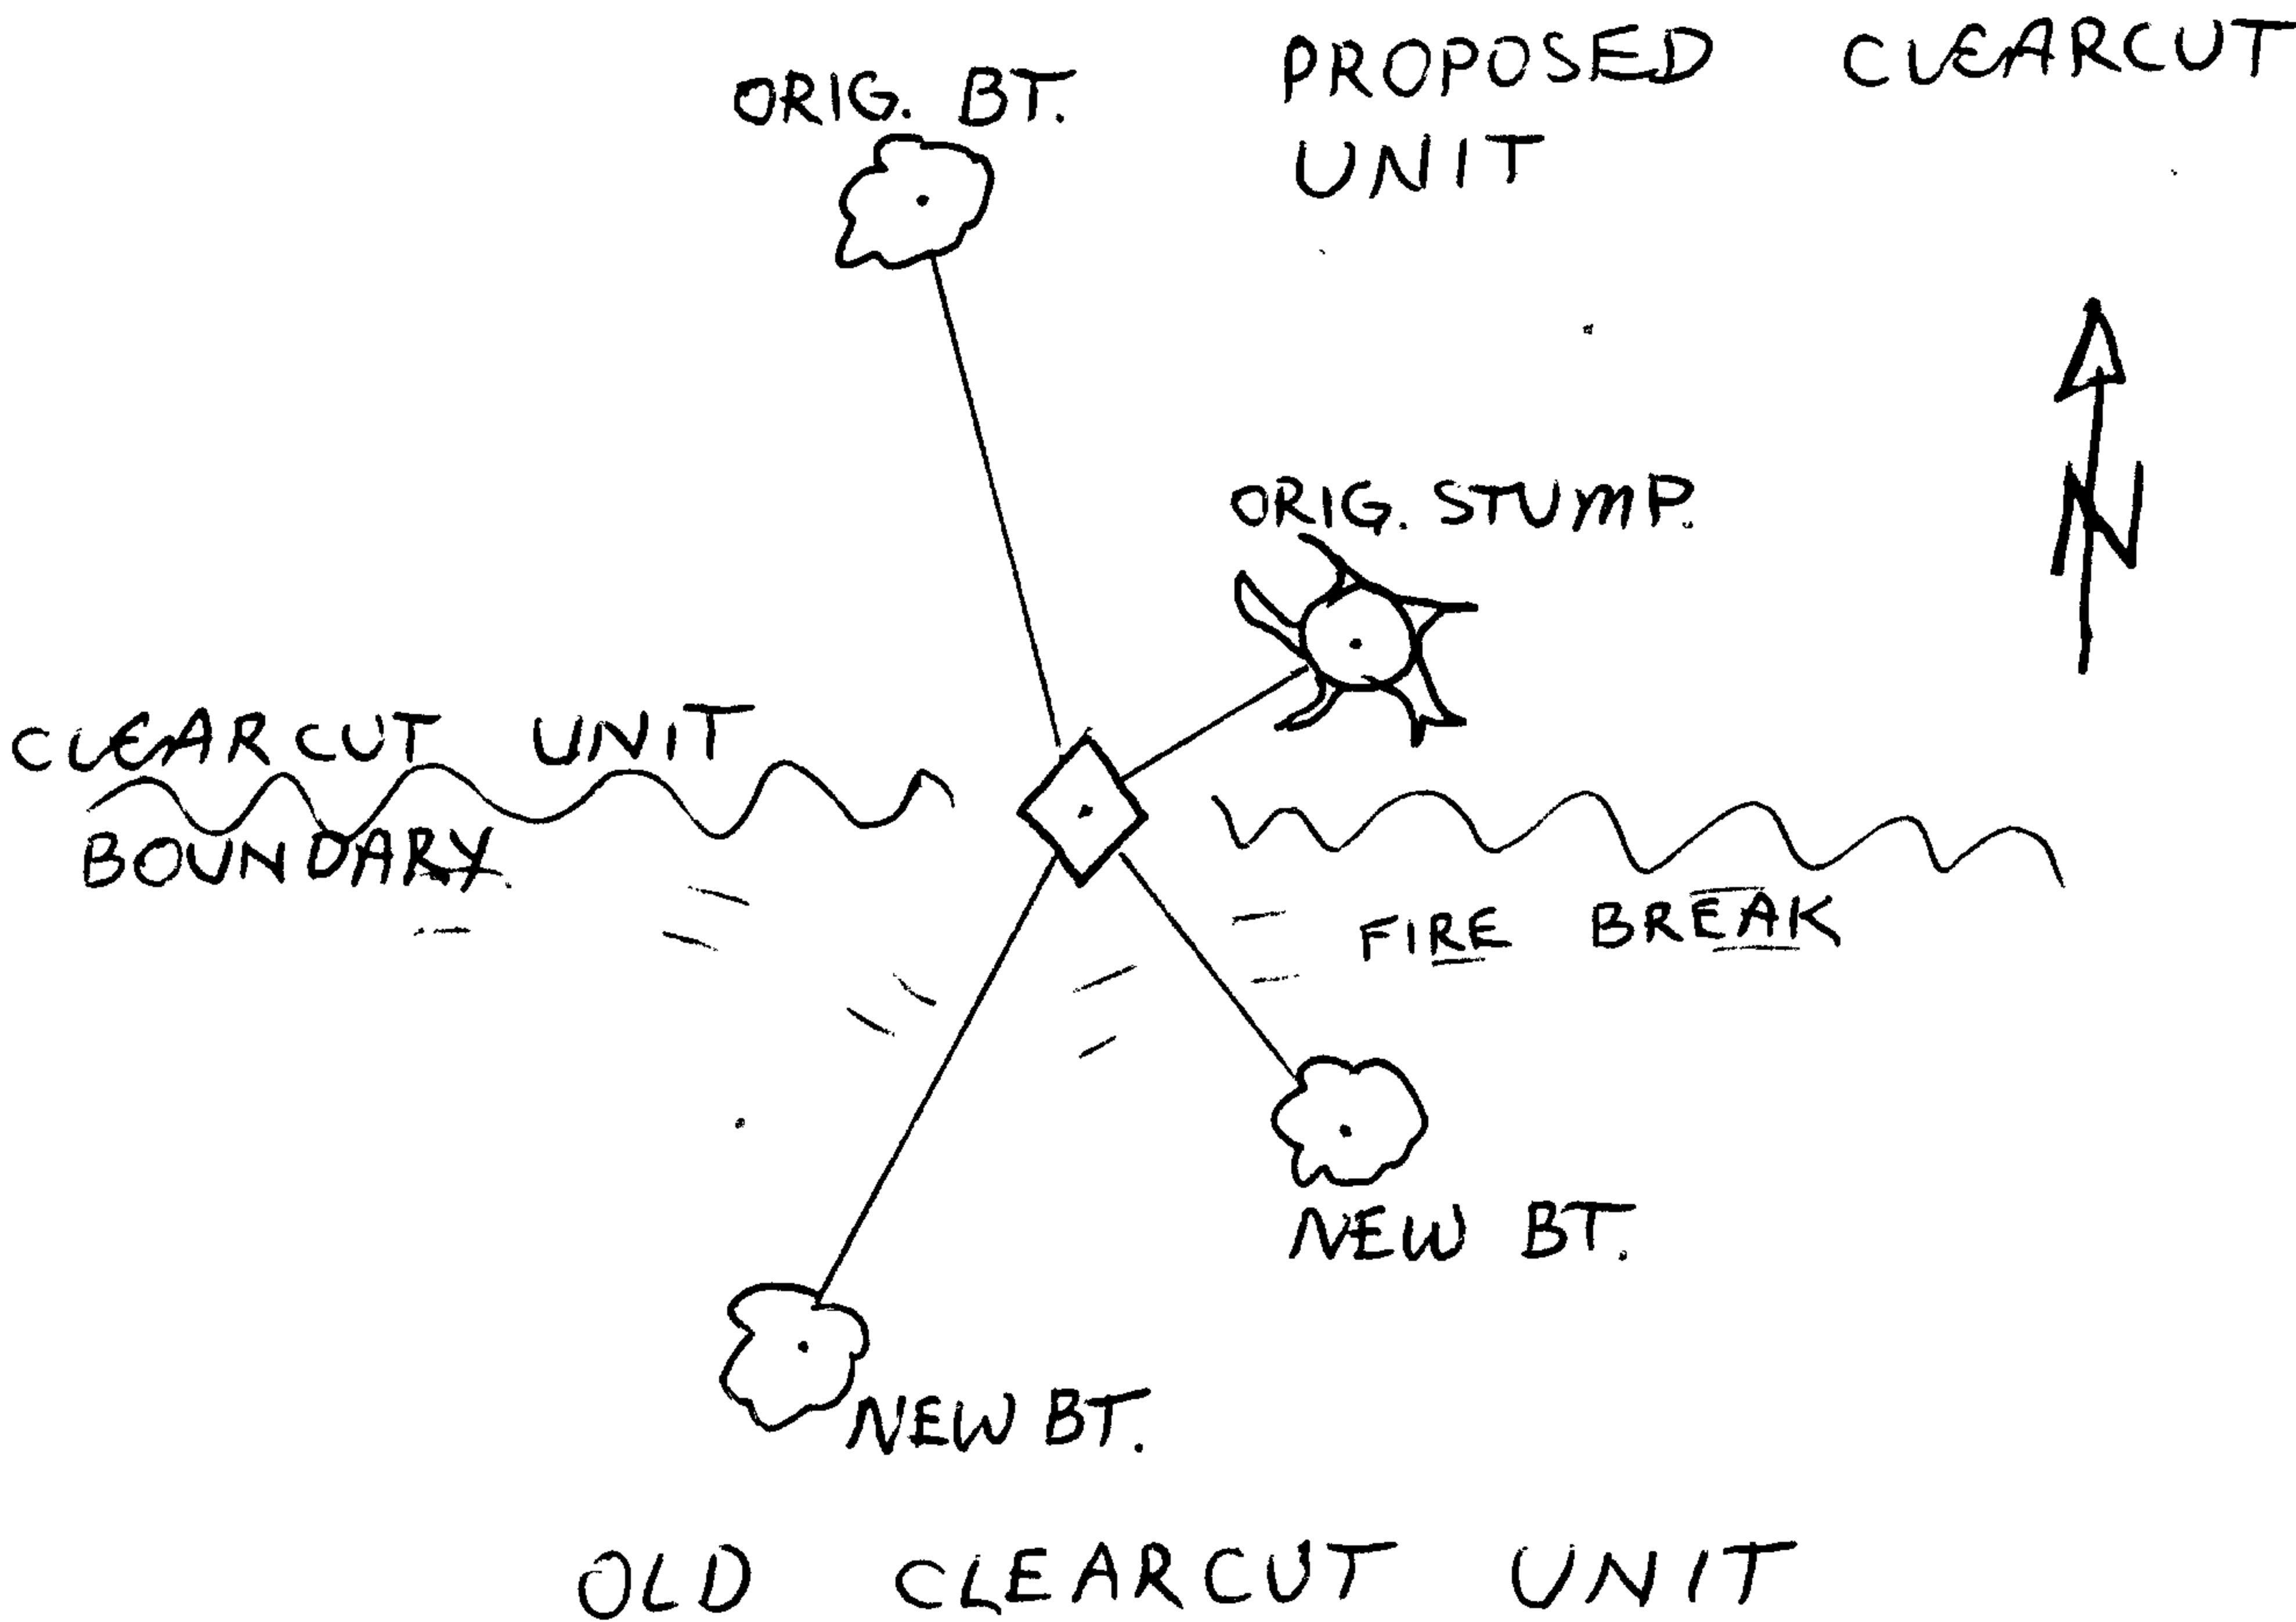

Location & Comments

CORNER IS IN CUTTING LINE OF OLD CLEARCUT UNIT ON STEEP EAST SLOPE. TO REACH CORNER PROCEED UP USFS ROAD #3816 APPROXIMATELY 2 MILES FROM STEAMBOAT CREEK, THEN FOLLOW NORTH BOUNDARY OF CLEARCUT UNIT #25-2E-16-1 APPROXIMATELY 1/2 MILE TO THE CORNER. CORNER IS ABOUT 530' WEST OF 2 SMALL CREEKS.

Comp. Declin. 18°E
 Agency DOUGLAS COUNTY SURVEYOR'S OFF.
 Party Chief JIM LANDRUM, L.S. 2024
 Notekeeper LEONARD HERZSTEIN
 Witnesses LEONARD HERZSTEIN

OK
JLM
Surveyor's Seal

REGISTERED
 PROFESSIONAL
 LAND SURVEYOR

James N. Landrum

OREGON
 FEBRUARY 4, 1983
 JAMES N. LANDRUM
 2024