

GOVERNMENT CORNER RESTORATION FORM

Township 32S Range 3W Sec. 15 County DOUGLAS

State OREGON Date DEC. 15, 1983 No. _____

Corner Designation

SECTION CORNER TO SECTIONS 15 AND 16 ONLY,
T32S R3W, W.M.


- Condition Report Only
- Not Found
- Renewed
- Unrecorded
- Surveyed In
- Referenced Out

Previous Renewals 75, 177

MONUMENT DETAIL

Monument(s) Found: (Condition and Source)

1" DIAMETER IRON PIPE, FIRMLY SET,
PROJECTING 12" ABOVE GROUND, WITH
A BRASS CAP MARKED AS SHOWN, SET BY
JOHN POWELL, DEPUTY COUNTY SURVEYOR,
IN 1969.

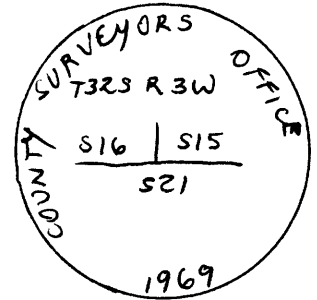

Accessories Found:

ORIG. B.T.S.:
A 18" D. FIR STUMP, N50°E, 9 1/2 FT., WITH HEALED DOUBLE BLAZE.
A 20" D. FIR, N64°W, 13 1/2 FT., WITH HEALED DOUBLE BLAZE.

AND BT MARKED BY POWELL IN 1969:
A 20" D. FIR STUMP, S37°W, 9 1/2 FT., WITH HEALED DOUBLE BLAZE.

AND BT MARKED BY GLEN BAUGHMAN, L.S. 536, IN 1979:
A 14" D. FIR SNAG, N2 1/2°E, 97 1/2 FT., WITH SCRIBE MARKS "T32S R3W
S15 BT" AND A BRASS WASHER STAMPED "L.S. 536" VISIBLE ON A
PARTIALLY HEALED DOUBLE BLAZE.

FILED
 RECEIVED *ll*
 JAN 16 1984
 COUNTY SURVEYOR
 DOUGLAS COUNTY, ORE.

RENEWAL

Monument Set (Procedure and Description)


Monument Detail

NONE

New Accessories

NONE, NO AVAILABVE TREES IN S15.

Sketch of Monument, Aecessories, and General Area

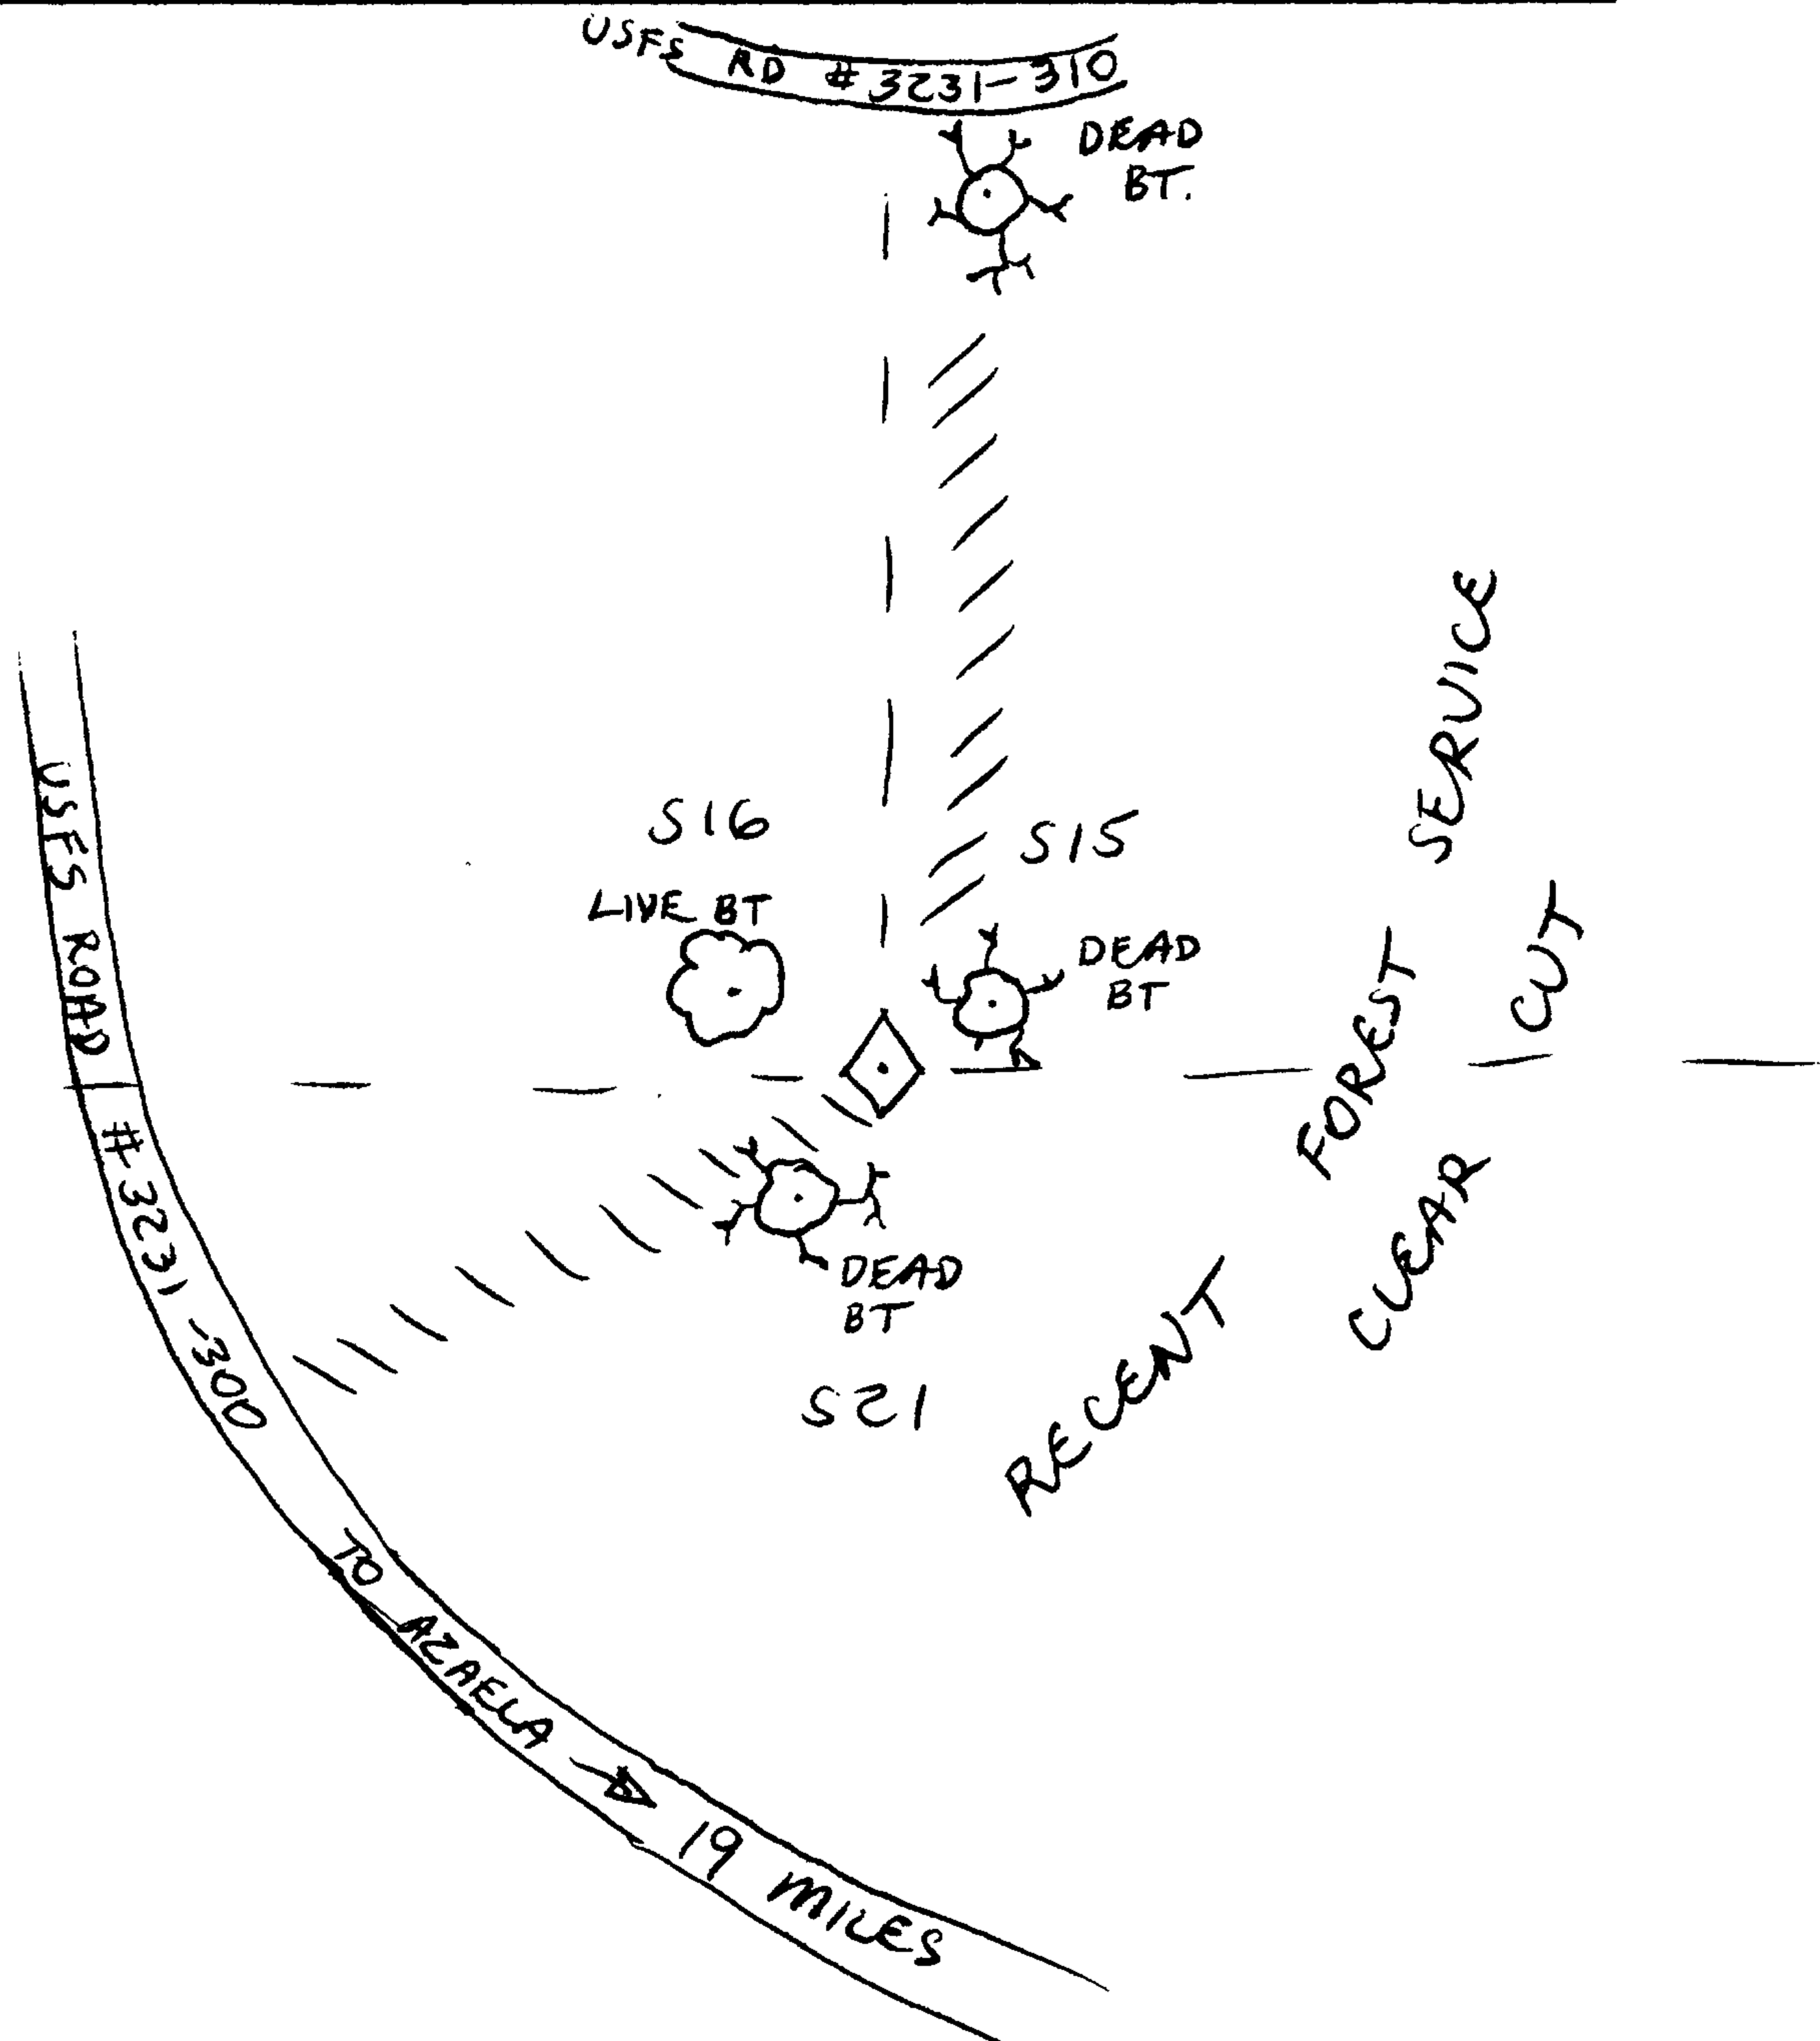

Location & Comments

CORNER IS 110 FT. EAST OF USFS ROAD # 3231-300, APPROXIMATELY 19 MILES FROM AZAELA.

Comp. Declin. 20°E
Agency U.S. FOREST SERVICE
Party Chief LEONARD HERTSTEIN
Notekeeper LEONARD HERTSTEIN
Witnesses RANDY LOPEZ

alt

Surveyor's Seal