

GOVERNMENT CORNER RESTORATION FORM

Township 30S Range 1E Sec. 33 County DOUGLAS

State OREGON Date DEC. 22, 1983 No. _____

Corner Designation

QUARTER CORNER TO SECTION 33, T30S, R1E
AND SECTION 4, T31S, R1E, W.M.

- Condition Report Only
- Not Found
- Renewed
- Unrecorded
- Surveyed In
- Referenced Out


Previous Renewals Vol. 26 Pg. 11195 1923 ESTABLISHMENT

MONUMENT DETAIL

Monument(s) Found: (Condition and Source)

1" DIAMETER IRON POST, FIRMLY
SET, ~~RESET~~ WITH BRASS CAP MARKED
AS SHOWN, ESTABLISHED BY G.L.O.
IN 1923.

THIS CORNER POSITION APPEARS TO
BE LOST. ORIG. BTS WERE DESTROYED
DURING ROAD CONSTRUCTION AND MONU-
MENT WAS RESET FOLLOWING CONSTRUCTION
WITHOUT BEING REFERENCED OUT.

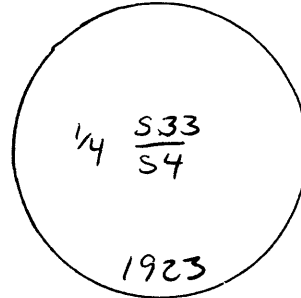

Accessories Found:

NONE

FILED
RECEIVED *zh*
JAN 16 1984
COUNTY SURVEYOR
DOUGLAS COUNTY, ORE.

