

FILED  
RECEIVED

OREGON CORNER RESTORATION FORM

MAY 18 1984

Section 21 Township 25S Range 2E

County DOUGLAS Date MAY 8, 1984

COUNTY SURVEYOR  
DOUGLAS COUNTY, ORE.

Corner Designation

1/4 CORNER OF SECTIONS 21 & 22,  
TESS RIZE, WILAMETTE MERIDIAN.

Condition Report Only  
 Not Found  
 Renewed  
 Unrecorded  
 Surveyed In  
 Referenced Out


Previous Renewals/Surveys, etc. ORIGINALLY SET BY  
G.L.O. IN 1928.

Monument(s) & Accessories Found: (Condition and Source)

ORIGINAL 1" d. IRON POST BENT FLUSH WITH GROUND,  
WITH BRASS MARKED AS SHOWN BELOW, SET IN 1928  
BY JOHN COLLINS U.S. CADASTRAL ENGINEER. DUG UP I.P.,  
NOW 30" LONG, AND FOUND TOP 12" BENT OVER 60° WITH BOTTOM 18"  
STILL VERTICALLY SET IN GROUND. I USE THE VERTICAL  
POSITION OF THE BASE AS THE ORIGINAL POSITION OF THE CORNER  
FROM WHICH THE REMAINS OF THE ORIGINAL BTS:

A 18" D. FIR STUMP WITH LOG ALONGSIDE, S62°E, 38 1/2 FT (CAL. 38 1/2 FT.) WITH HEADED BLAZE.  
A 12" D. FIR SNAG, WITH S30°W, 7 1/2 FT. WITH HEADED BLAZE.

Monument Detail

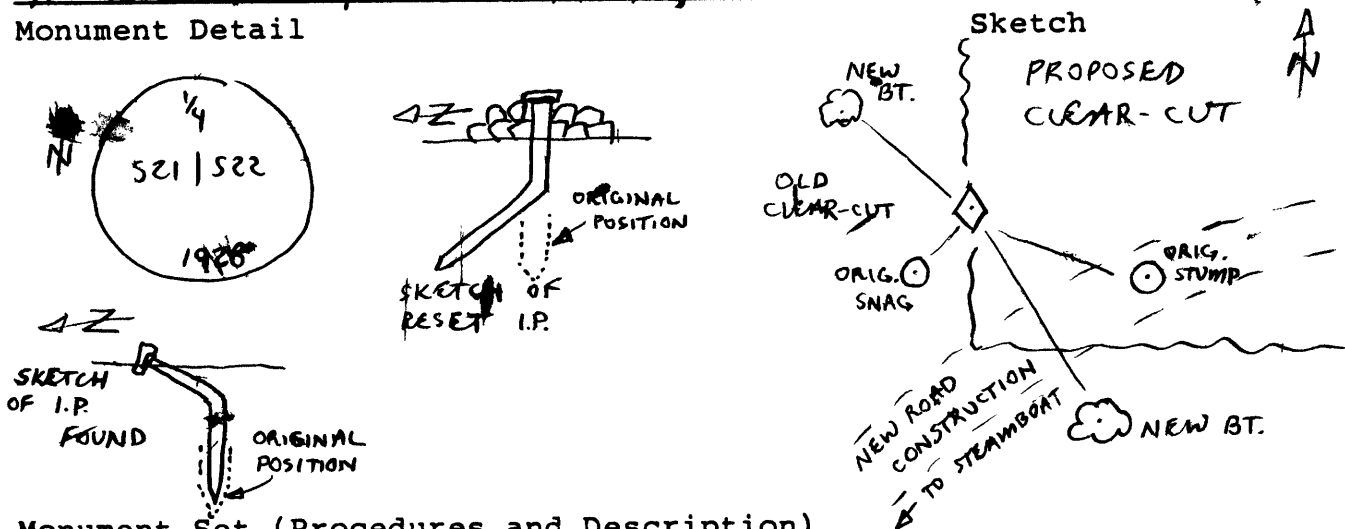

Monument Set (Procedures and Description)

I RESET ORIGINAL MONUMENT OVER ORIGINAL VERTICAL POSITION  
SINCE I COULD NOT STRAIGHTEN BENT I.P., I BURIED THE BASE, BENT  
TO NORTH, & THE TOP IS SET VERTICAL AND FLUSH IN A 3 FT. d.  
MOUND OF STONE. SET 6' STEEL FENCE POST ABOUT 2 1/2 FT. NORTH  
OF CORNER WITH USFS SIGN #54-4 ATTACHED.

New Accessories

I SCRIBED NEW BTS:  
A 20" D. CEDAR, S39 3/4°E, 75 1/2 FT., SCRIBED "1/4 522 BT"  
ON SINGLE BLAZE.  
A 4" W. FIR, N54 3/4°W, 48 1/2 FT., SCRIBED "1/4 522 BT"  
ON SINGLE BLAZE.

Location & Comments

CORNER <sup>IS 40 FT.</sup> NORTH OF NEW Compass Declination 18°  
RD (USES RD. # 2816-150) Firm/Agency U.S.F.S.  
0.3 MILES FROM ICT.  
WITH USFS RD. # 2816-100 Address P.O. BOX 1008  
NEW BTS ARE MARKED ROSEBURG, OR., 97470  
OUTSIDE NEW ROAD Party Chief LEONARD HERZSTEIN  
CLEARING AND PROPOSED Notes LEONARD HERZSTEIN  
CLEAR-CUT AREA. Witness RANDY LOPEZ.

Surveyor's Seal

REGISTERED  
PROFESSIONAL  
LAND SURVEYOR

Maurice E. Farr

OREGON  
SEPT. 23, 1977  
MAURICE E. FARR  
1181

Ren. # 10

C.S. File No. 62/15-3

of Jim

C