

FILED
RECEIVED

OREGON CORNER RESTORATION FORM

Section 27 Township 30S Range 1W

OCT 30 1984

County DOUGLAS Date SEPT. 18, 1984 COUNTY SURVEYOR
DOUGLAS COUNTY, ORE.

Corner Designation

SECTION CORNER TO SECTIONS
27, 28, 33 & 34, T30S, R1W,
W.M.

Condition Report Only
 Not Found
 Renewed
 Unrecorded
 Surveyed In
 Referenced Out

Previous Renewals/Surveys, etc. #19, M69-4

Monument(s) & Accessories Found: (Condition and Source)

1 1/2" O.D. IRON PIPE WITH BRASS CAP ATTACHED, FIRMLY SET, PROJECTING
12" ABOVE A 3' DIAMETER MOUND OF STONE. I.P. IS LEANING SLIGHTLY
NORTHERLY AND BRASS CAP IS ROTATED 45° CLOCKWISE. I USE
POINT WHERE THE I.P. PROJECTS FROM THE MOUND OF STONE
AS THE CORNER POINT. B.C. WAS SET BY VERNON TRACY, DEPUTY CO. SURVEYOR, IN 1967.


FROM WHICH REMAINING ORIGINAL BTS:

A 13" D. FIR, S87°E (REC. S82°E), 29 1/2 FT. WITH SCRIBE MARKS "S3"
VISIBLE ON PREVIOUSLY OPENED BLAZE.
A 32" D. FIR STUMP, N32°W, 15 1/2 FT. WITH NO MARKS VISIBLE.

Monument Detail Sketch

AND BTS MARKED BY TRACY IN 1967:

- ✓ A 12" D. FIR, N74°E, 19 1/2 FT., WITH HEALED DOUBLE BLAZE.
- ✓ A 14" I. CEDAR, S72°E, 31 1/2 FT. (REC. 31 1/2 FT.), WITH PARTIALLY HEALED DOUBLE BLAZE.
- ✓ A 10" D. FIR SNAG, S19°W, 28 1/2 FT., WITH SCRIBE MARKS "T30S R1W S33 CS BT" VISIBLE ON PARTIALLY HEALED DOUBLE BLAZE.
- ✓ A 36" D. FIR, N72°W, 17 1/2 FT. (REC. 18° FT.), WITH HEALED BLAZE.

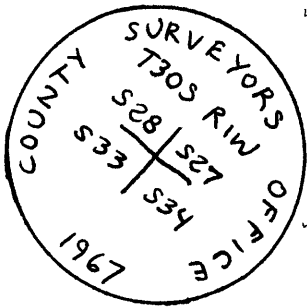

Monument Set (Procedures and Description)

NONE.

New Accessories

I MARKED A NEW BT:

A 13" MADRONE, S55°W, 26 1/2 FT., ~~WITH~~ SCRIBED "T30S R1W S33"
ON UPPER BARK BLAZE AND "BT" ON LOWER ^{POST} ~~FACE~~ BLAZE
WITH A BRASS WASHER STAMPED "LS 1181" NAILED TO FACE OF
LOWER BLAZE.

Location & Comments

STEEL FENCE POST SET Compass Declination 17°E

37 FT. SOUTH WITH Firm/Agency USFS

USFS SIGNS #54-2 &

#54-4 ATTACHED. Address 2900 STEWART PKWY.

CORNER IS 40 FT. NW. ROSEBURG, OR, 97470

OF NEW USFS ROAD Party Chief LEONARD HERZSTEIN

NOW UNDER CONSTRUCTION. Notes LEONARD HERZSTEIN

AND 300 FT. FROM ITS JUNCTION WITH USFS ROAD #31.
Witness RANDY LOPEZ.

Surveyor's Seal

REGISTERED
PROFESSIONAL
LAND SURVEYOR

Maurice E. Farr

OREGON
SEPT. 23, 1977
MAURICE E. FARR
1181

9-26-84

OK
JLM

C.S. File No. 62/15-6

#220 X