

FILED
RECEIVED

OREGON CORNER RESTORATION FORM

OCT 30 1984

Section 34 Township 30S Range 1E

County DOUGLAS Date SEPT. 25, 1984

COUNTY SURVEYOR
DOUGLAS COUNTY, ORE.

Corner Designation

SECTION CORNER TO SECTIONS 34
& 35, T30S, R1E AND SECTIONS 2
& 3, T31S, R1E, WILLAMETTE
MERIDIAN.

- Condition Report Only
- Not Found
- Renewed
- Unrecorded
- Surveyed In
- Referenced Out

Previous Renewals/Surveys, etc. _____

Monument(s) & Accessories Found: (Condition and Source)


DID NOT FIND ORIGINAL IRON POST. THE CORNER POINT, AS
DETERMINED FROM THE RECORD BEARINGS AND DISTANCES FROM ALL
ORIGINAL BTS, FALLS IN THE CENTER OF A 4' WIDE CREEK, WHICH BEARS
DOWN N35°W.

FROM WHICH ORIGINAL BTS:

- A 32" D. FIR, N44°E, 100³ FT., WITH HEALED BLAZE. 15'
- A 47" D. FIR, S39°E, 57⁴ FT., WITH HEALED BLAZE. 17'
- A 38" D. FIR STUMP, S25¹/₂°W, 38⁹ FT., WITH HEALED BLAZE. 5'

Monument Detail

- A 40" D. FIR, N61°W, 49⁵ FT., WITH HEALED BLAZE. ~~Sketch~~ 75'

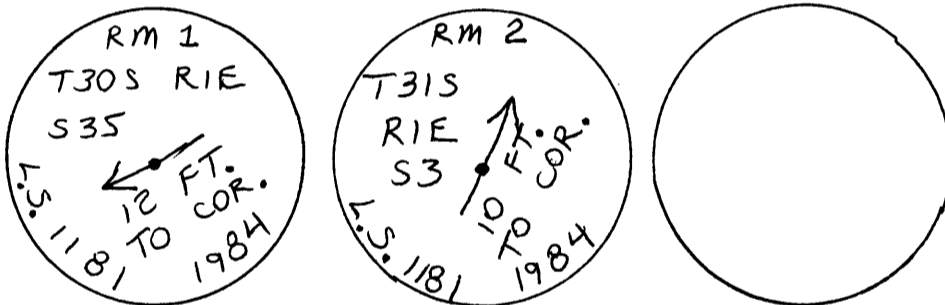

Monument Set (Procedures and Description)

AT CORNER POINT I SET A 5/8" d REBAR, 12" LONG,
DRIVEN 10" TO BEDROCK. ALSO SET A 6' STEEL FENCE POST, 2 FT
IN THE GROUND, NS2°E, 4 1/2 FT. AS A GUARD POST, WITH USFS
SIGN #54-4 ATTACHED.

New Accessories I SET 2 REFERENCE MONUMENTS:

RM 1, N80°E, 12° FT. A 2 1/4" O.D. IRON PIPE WITH BRASS CAP, 30"
LONG, SET 28" IN GROUND WITH 2' d. MOUND OF STONE TO TOP.
BRASS CAP MARKED AS SHOWN ABOVE.

RM 2, S10°W, 10° FT. A 2 1/4" O.D. IRON PIPE WITH BRASS CAP, 30"
LONG, SET 26" IN GROUND WITH 2' d. MOUND OF STONE TO 4" FROM

Location & Comments TOP OF IR BRASS CAP MARKED AS
SHOWN ABOVE.

CORNER IS IN SMALL CREEK, WHICH BEARS
DOWN N35°W, AND IS 100 FT. N.E. OF USFS
RD. # 2925-600

Compass Declination 19 1/2° E

Firm/Agency USFS

Address 2900 STEWART PKWY.
ROSEBURG, OR, 97470

Party Chief LEONARD HERZSTEIN

Notes LEONARD HERZSTEIN

Witness RANDY LOPEZ

Surveyor's Seal

REGISTERED
PROFESSIONAL
LAND SURVEYOR

Maurice E. Farr

OREGON
SEPT. 23, 1977
MURICE E. FARR
1181

9-26-84

#48 T 30-1E ✓ -
#3 T 31-1E ✓ -

C.S. File No. 62/15-7