

FILED
RECEIVED

NOV 15 1984

OREGON CORNER RESTORATION FORM

COUNTY SURVEYOR
DOUGLAS COUNTY, ORE.

Section 1 Township 31S Range 2W

County DOUGLAS Date OCT. 31, 1984

Corner Designation

NORTH SIXTEENTH CORNER OF
SECTION 1 AND 2, TOWNSHIP 31
SOUTH, RANGE 2 WEST, WILLAMETTE
MERIDIAN

Condition Report Only
 Not Found
 Renewed
 Unrecorded
 Surveyed In
 Referenced Out

Previous Renewals/Surveys, etc. M-65-68, M 65-79

Monument(s) & Accessories Found: (Condition and Source)

2 3/4" O.D. IRON PIPE, FIRMLY SET, PROJECTING 2" ABOVE
A 2' DIAMETER MOUND OF STONE WITH 3" BRASS CAP
MARKED AS SHOWN BELOW, SET BY GLEN BAUGHMAN,
L.S. 536, IN 1978.


AND BTS BY BAUGHMAN IN 1978:

A 10" D. FIR SNAG, N62°E, 22' FT., WITH SCRIBE MARKS
"N 1/6 S1 BT" VISIBLE ON PARTIALLY HEALED DOUBLE BLAZE.

A 9" D. FIR, N10°30'W, 40' FT., WITH SCRIBE MARKS "N 1/6 S2 BT"

MONUMENT DETAIL VISIBLE ON PARTIALLY HEALED
DOUBLE BLAZE. BOTH BTS HAVE A BRASS WASHER STAMPED "LS 536"
NAILED FLUSH TO LOWER BLAZES.

2 STEEL FENCE POSTS ARE SET:
SOUTH, 4 1/2 FT., WITH USFS SIGNS # 54-2 & 54-9
ATTACHED.
AND EAST, 1 1/2 FT., WITH USFS SIGN # 54-2
ATTACHED.

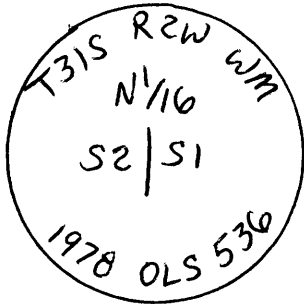

Monument Set (Procedures and Description)

NONE

New Accessories

MARKED A NEW BT:
A 2 1/2" P. PINE, S73°E, 16 1/2 FT., SCRIBED "N 1/6 S1 BT"
ON A SINGLE BLAZE, WITH A BRASS WASHER STAMPED "LS 1181"
NAILED FLUSH TO BASE OF BLAZE.

Location & Comments

COMPASS DECLINATION DUE TO LOCAL ATTRACTION OF STEEL FENCE POSTS. COMPASS DECLINATION 35 1/2°E
FIRM/AGENCY U.S. FOREST SERVICE
CORNER IS AT N.W. CORNER OF STANDING TIMBER ABOUT 600 FT, N45°W OF SWITCHBACK IN USFS RD # 1610-100. Address 2900 STEWART PKWY, ROSEBURG, OR, 97470
Party Chief LEONARD HERZSTEIN Notes LEONARD HERZSTEIN
Witness RANDY LOPEZ

Surveyor's Seal

REGISTERED
PROFESSIONAL
LAND SURVEYOR

Maurice E. Farr
OREGON
SEPT. 23, 1977
MAURICE E. FARR
1181

11-13-84

C.S. File No. 6215-8