

GOVERNMENT CORNER RESTORATION FORM

Township T26S Range 2W Sec. 13 County DOUGLAS

State OREGON Date JAN. 13, 1984 No. _____

Corner Designation


QUARTER CORNER TO SECTION 13 ONLY,
T26S, R2W, W.M.

- Condition Report Only
- Not Found
- Renewed
- Unrecorded
- Surveyed In
- Referenced Out

Previous Renewals 60 T.26-1 #99 T26-2

Monument(s) Found: (Condition and Source)

3" d, BRASS CAP, FIRMLY SET, BURIED 4"
IN GROUND, MARKED AS SHOWN, SET BY
DON GARRETT, L.S. # 544, IN 1972.

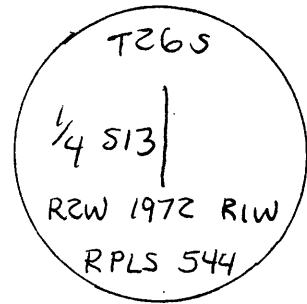

Accessories Found:

ACCESSORIES ESTABLISHED BY GARRETT
IN 1972:

A 13" D. FIR, S2°W, 128± FT., WITH HEALED DOUBLE BLAZE.
A STEEL FENCE POST, PROJECTING 4 FT. ABOVE GROUND, N3°W, 5± FT., WITH
U.S.F.S. SIGNS #542 & #544 ATTACHED.

#109 T26-1 X
#130 T26-2 X

C.S. File No. 62/15-17

