

GOVERNMENT CORNER RESTORATION FORM

Township 31S Range 1W Sec. 7 County DOUGLAS
 State OREGON Date JAN. 17, 1984 No. _____

Corner Designation


- Condition Report Only
- Not Found
- Renewed
- Unrecorded
- Surveyed In
- Referenced Out

Previous Renewals 29, M65-60

MONUMENT DETAIL

Monument(s) Found: (Condition and Source)

1" DIAMETER IRON PIPE, FIRMLY SET, PROJ-
ECTING 12" ABOVE 1FT. MOUND OF STONE,
SET BY JOHN POWELL, DEPUTY COUNTY
SURVEYOR, IN 1966.

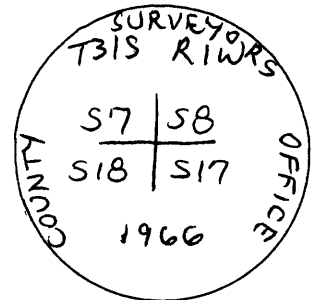

Accessories Found:

REMAINS OF ORIGINAL BTS:
A- 28" B. OAK, S55°W, 65³/₄ FT., WITH NO MARKS VISIBLE ON PREVIOUSLY
OPENED BLAZE.
A- ROOTHOLE, N12°W, 73¹/₂ FT. WITH OAK STUMP ALONGSIDE WITH NO MARKS
VISIBLE ON DECAYED BLAZE

AND BTS MARKED BY POWELL IN 1966:
A- 14" D. FIR, N47°E, 25³/₄ FT. (PER M65-60) WITH HEALED DOUBLE BLAZE
A- 14" D. FIR STUMP, S50°E, 51⁵/₈ FT. (PER M65-60) WITH HEALED DOUBLE BLAZE
A- 14" D. FIR, S37°W, 30¹/₂ FT. (PER M65-60) WITH HEALED DOUBLE BLAZE (WITH
RECENT LOGGING SCAR OVER HEALED BLAZE).
A- 14" MADRONE, N62°W, 17⁰/₈ FT. WITH HEALED DOUBLE BLAZE.

RENEWAL

Monument Set (Procedure and Description)

Monument Detail

NONE

New Accessories

NONE. NO SUITABLE TREES IN S17 DUE TO RECENT LOGGING.
BT MARKED BY POWELL IN 1966 FOR S17 IS NOW HIGH STUMPED.

Sketch of Monument, Accessories, and General Area

Location & Comments

CORNER IS NEXT TO OLD FENCE
CORNER (NOW DOWN). LOGGING ROAD
BEARING N40°W & S60°E, BEARS
S W 20 FT.
CORNER IS APPROXIMATELY S80°W, 1000'
FROM THE END OF USFS RD.#
1610-215

Comp. Declin. 19³/₄°E
Agency U.S.F.S.
Party Chief LEONARD HERTSTEIN
Notekeeper
Witnesses RANDY LOPEZ

[Handwritten signature]

Surveyor's Seal