

GOVERNMENT CORNER RESTORATION FORM

Township 31S Range 1W Sec. 7 County DOUGLAS

State OREGON Date JAN. 17, 1984 No. _____

Corner Designation

CENTER SOUTH $\frac{1}{16}$ CORNER OF SECTION 7,
T31S R1W, W. M.


- Condition Report Only
- Not Found
- Renewed
- Unrecorded
- Surveyed In
- Referenced Out

Previous Renewals M 65-60

MONUMENT DETAIL

Monument(s) Found: (Condition and Source)

2 1/2" DIAMETER IRON PIPE, FIRMLY SET,
FLUSH WITH 3 FT. MOUND OF STONE,
WITH BRASS CAP MARKED AS SHOWN,
SET BY WILLIAM RUPPERT, L.S. # 866,
IN 1977.

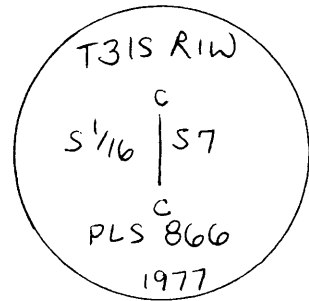

Accessories Found:

- B.T.s MARKED BY RUPPERT IN 1977:
- A - 12" D. FIR, S25°30'E, 12 1/2 FT., WITH FRAGMENTARY SCRIBE MARKS VISIBLE
ON PARTIALLY HEAVED DOUBLE BLAZE. (BLAZE FACING FOR
S80°E BT.)
 - A - 17" P. PINE (RECORD: D. FIR), S59°20'W, 60 3/4 FT., WITH FRAGMENTARY
SCRIBE MARKS VISIBLE ON PARTIALLY HEAVED DOUBLE BLAZE.
(BLAZE FACING FOR S28°W BT.)
 - A - 9" D. FIR, N78°30'W, 4 1/2 FT., WITH FRAGMENTARY SCRIBE MARKS
VISIBLE ON PARTIALLY HEAVED DOUBLE BLAZE

RENEWAL

Monument Set (Procedure and Description)

Monument Detail

NONE

New Accessories

NONE

Sketch of Monument, Accessories, and General Area

Location & Comments

CORNER IS APPROXIMATELY
500 FT., N15°E. FROM THE
END OF U.S.F.S. RD. #1610-205
IN RECENT PARTIAL CUT.

Comp. Declin. 19°E
Agency U.S.F.S.
Party Chief LEONARD HERCSTEIN
Notekeeper _____
Witnesses RANDY LOPEZ

ck
flm

Surveyor's Seal