


GOVERNMENT CORNER RESTORATION FORM

Township 20S Range 9W Sec. 26 County DOUGLAS

State OR Date 3/22/84 No. _____

Corner Designation

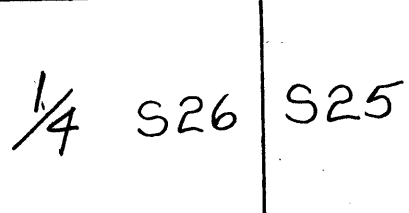

- Condition Report Only
- Not Found
- Renewed
- Unrecorded
- Surveyed In
- Referenced Out


Previous Renewals 1954 BLM DEP. RESURVEY, 1967 BLM REN., REN #12, M96-20 MONUMENT DETAIL

Monument(s) Found: (Condition and Source)

1" I.P. WITH BRASS CAP PROTRUDING

6" ABOVE GROUND (1954 BLM DEP. RESURVEY) MARKED AS NOTED.

U.S. GENERAL LAND OFFICE SURVEY

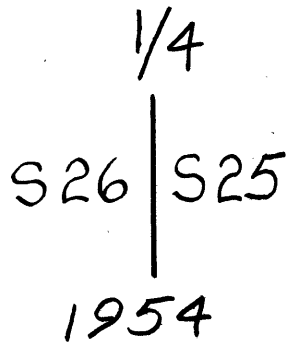

Accessories Found:

A 36 IN. FIR NOW A 48 IN. STUMP 5 FT HIGH WITH A BURNT SINGLE BLAZE, BEARS N49°W, 16.1 FT PER. M96-20 (REC. N51°W, 13.2 FT). ORIG. BT.

A 42 IN. FIR NOW A 57 IN. STUMP 5 FT HIGH WITH A BURNT SINGLE BLAZE, BEARS N83°E, 30.6 FT PER. M96-20 (REC 29.7 FT) ORIG. BT.

A 8 IN. HEMLOCK NOW A 1 FT HIGH SHATTERED STUMP WITH ROTTED OUT BLAZE, BEARS S73 1/2°E, 7.6 FT (PER 1954 BLM DEP. RESURVEY.)

NO OTHER BT FOUND FROM 1954 BLM DEP. RESURVEY.

A 12 IN. CEDAR NOW A 17 IN. DIAM. 2 FT HIGH STUMP WITH A WELL HEALED DOUBLE BLAZE, BEARS N79°W, 98.5 FT PER REN #12

#52 X

