

GOVERNMENT CORNER RESTORATION FORM

Township 23 S Range 4 W Sec. 4 County DOUGLAS

State OR Date 12-30-83 No. _____

Corner Designation

~~SOUTH QUARTER CORNER~~
1/4 CORNER S. 4
S. 9

- Condition Report Only
- Not Found
- Renewed
- Unrecorded
- Surveyed In
- Referenced Out

Previous Renewals #5, #6B

MONUMENT DETAIL

Monument(s) Found: (Condition and Source)

1" x 1" T IRON W/ BRASS CAP ATTACHED
SET INSIDE 1 1/2" IRON PIPE (O.D.)

1 1/4" O.D. PIPE BEARS S 30° E 37 ± FT.
FROM ABOVE T IRON. (THIS PIPE WAS
SET BY A B.L.M. ADMINISTRATIVE
SURVEY WHICH IS NOT OF RECORD AND
IS BLM'S UNOFFICIAL POSITION FOR
THE CORNER)

Accessories Found: FROM 1" x 1" T IRON IN 1 1/2" IRON PIPE W/ BRASS CAP

1 1/2" DIAM. D. FIR BEARS S 59° W 13 3/4 FT. TO CENTER AT BREAST
HEIGHT, 13 1/2 TO CENTER OF ROOT CROWN.
(REC. 16" D. FIR S 60° W 13 3/4 FT. - RENEWAL # 6B)

16" DIAM. D. FIR BEARS N 3° W 19 1/2 FT. TO CENTER AT BREAST HEIGHT,
19 1/2 FT. TO CENTER OF ROOT CROWN.
(REC. 14" D. FIR N 3° W 20 3/4 FT. - RENEWAL # 6B)

LOOKED FOR STUMPS OF ORIGINAL BTS AS MENTIONED IN RENEWAL # 5:

NOT FOUND - STUMP OF 10" FIR BEARING N 39° E 26.40 FT
NOT FOUND - STUMP OF 8" FIR BEARING S 19° W 17.16 FT. WE DID FIND
A 60" DIAM. FIR S 19° W 18 1/2 FT - SEE COMMENTS

FROM BLM 1 1/4" PIPE WE FIND:

10" W. FIR S 19° W 20.7 FT TO CENTER ROOT CROWN
24" T. CEDAR N 19 1/2° W 21.3 FT TO CENTER ROOT CROWN

NOTE: WE FIND EVIDENCE OF BARK SCRIBE ON CEDAR
" L , HOWEVER, KEVIN CARSON WHO WAS INVOLVED
WITH THE 1979 ADMINISTRATIVE SURVEY DID NOT
NOTICE THE SCRIBING AND HAS NO KNOWLEDGE
OF IT.

#174X

B.S. File No. 62/16-5 v

RENEWAL

Monument Set (Procedure and Description)

NONE


Monument Detail

New Accessories

NONE

Sketch of Monument, Accessories, and General Area

N
1"=20'

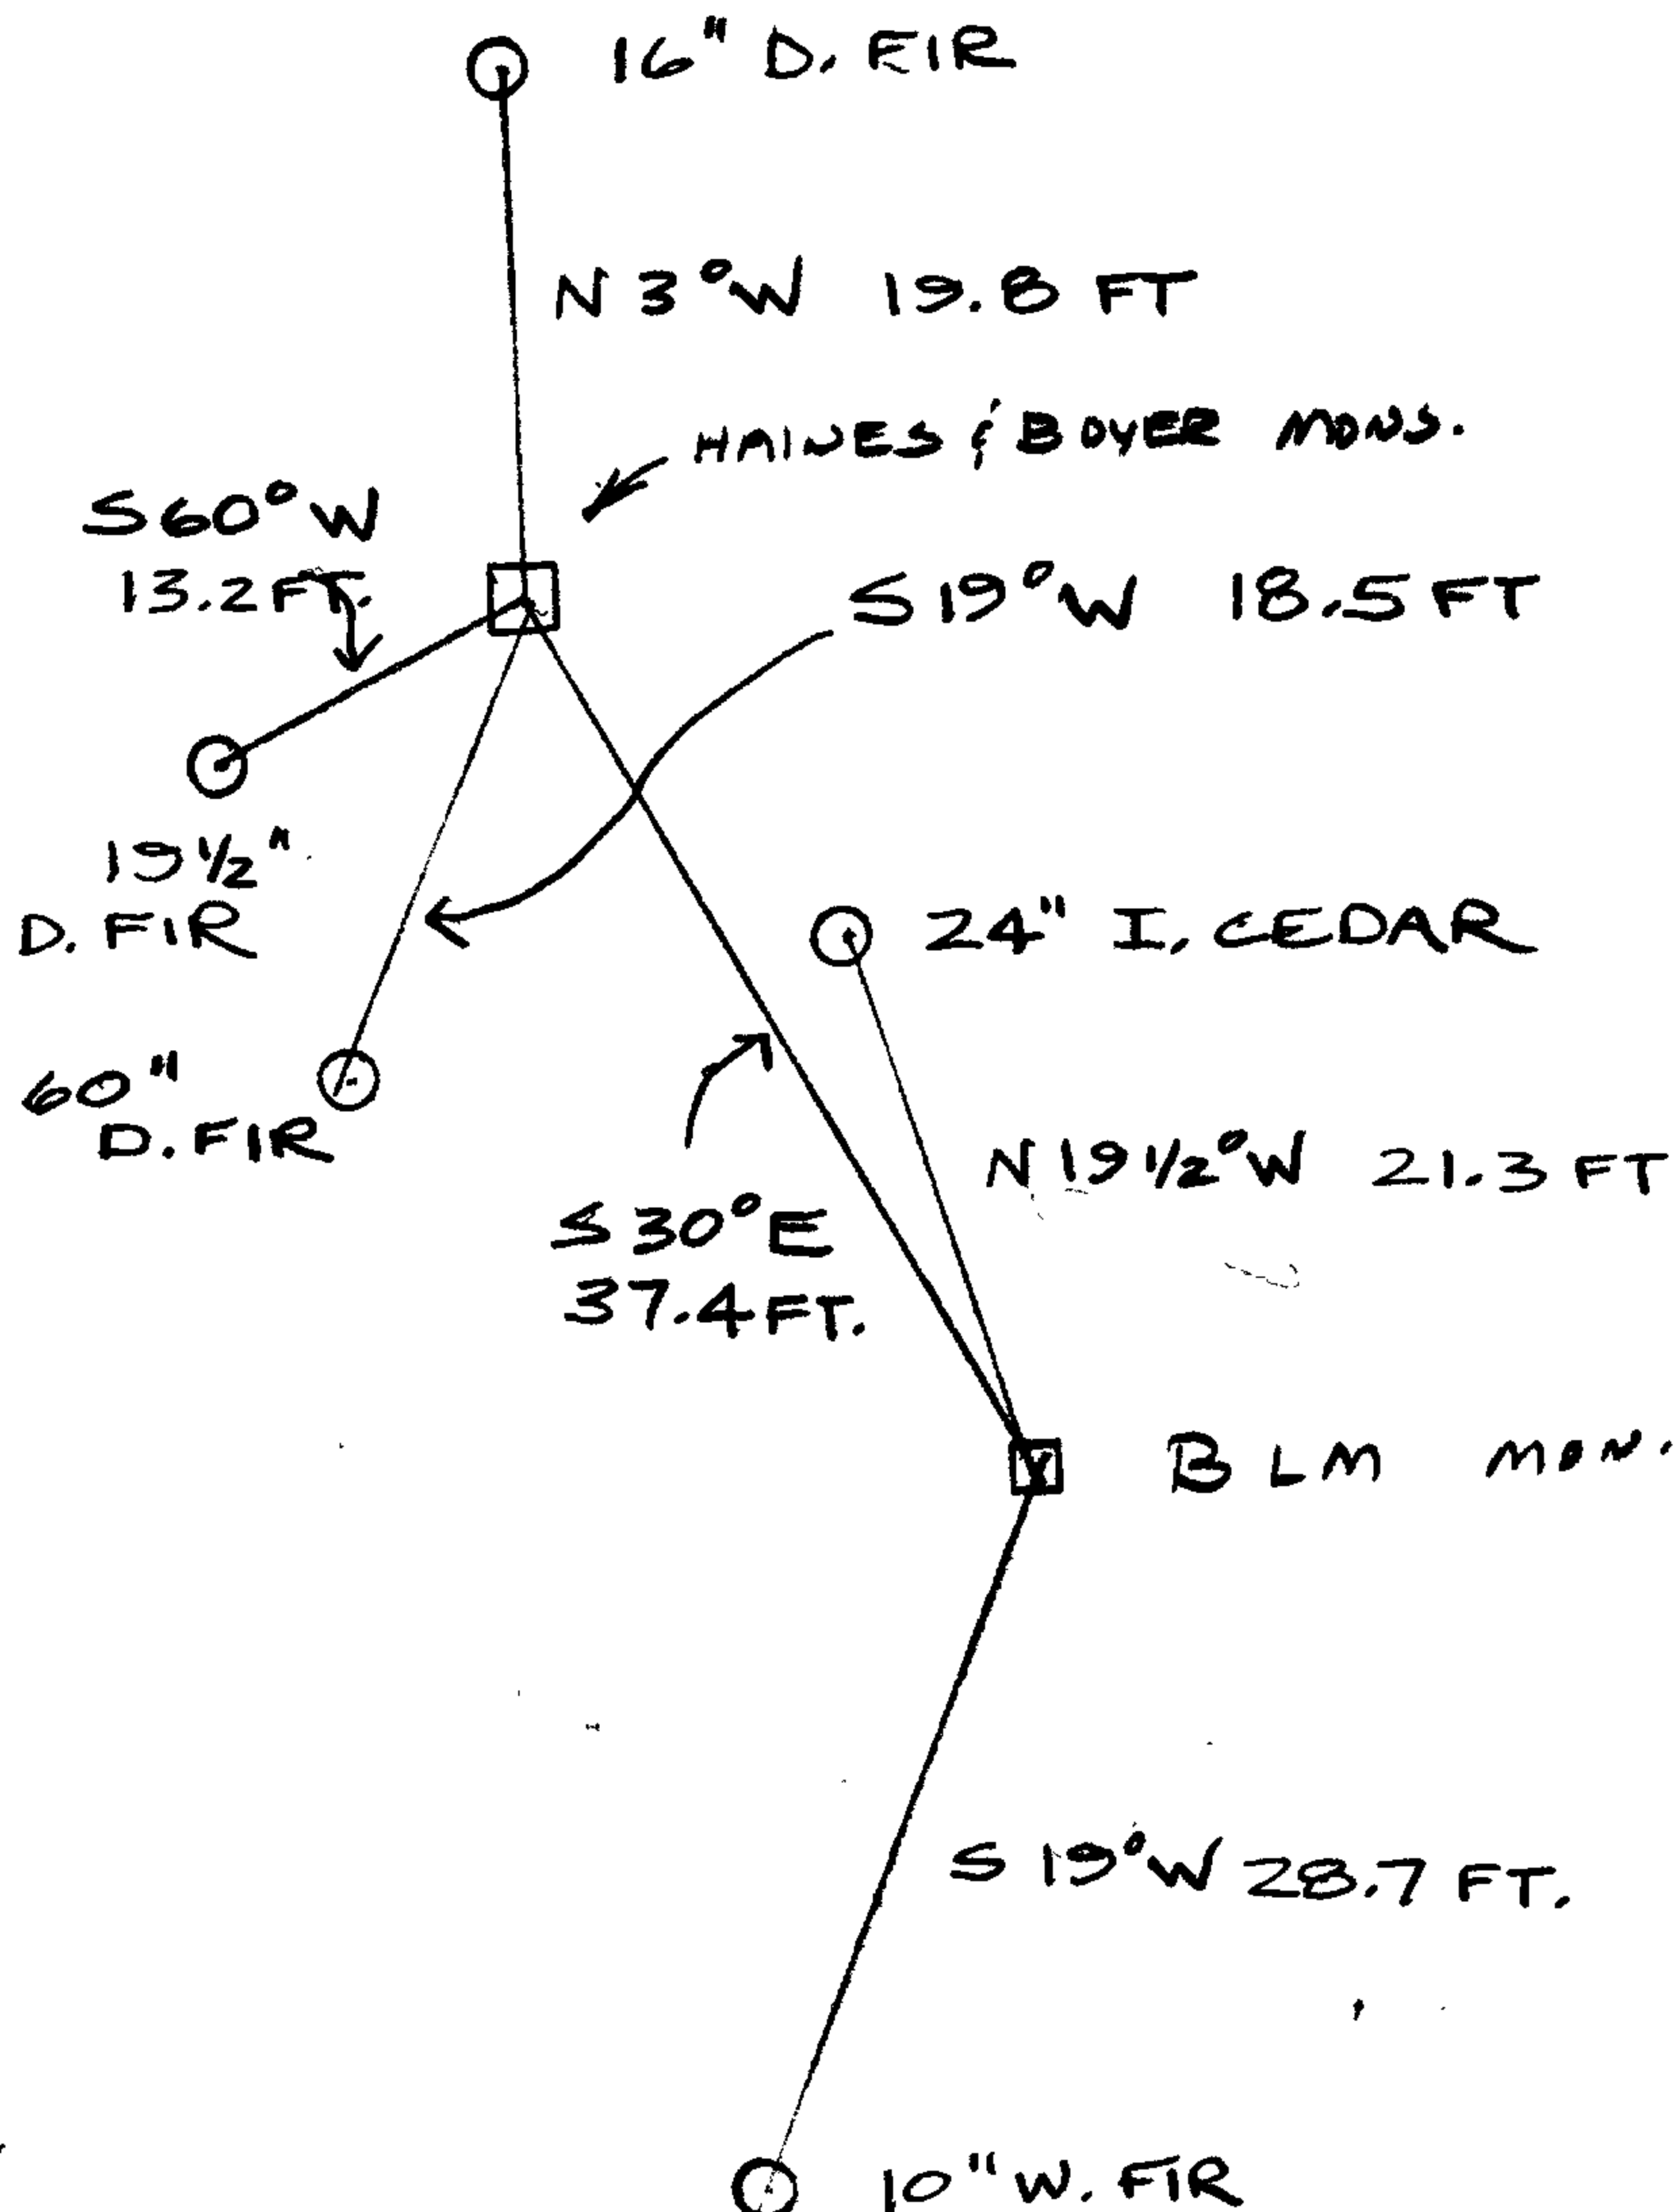

Location & Comments

NOTE: WE CUT INTO 60" FIR 14" I AND COUNT 130 YEARS OF GROWTH RINGS I, WHICH INDICATES THIS TREE WAS ± 32" IN DIAM. AT THE TIME OF THE ORIGINAL 1855 G.L.O. SURVEY (NOT B")

Comp. Declin. 19° E
Agency DOUGLAS CO. SURVEYOR
Party Chief ED MONREAN
Notekeeper JANET LUNDEEN
Witnesses RANDY SMITH

Surveyor's Seal

REGISTERED
PROFESSIONAL
LAND SURVEYOR

Larry E. Monrean

OREGON
JULY 13, 1979
LARRY E. MONREAN
#1830

R

GOVERNMENT CORNER RESTORATION FORM

Township 23 S Range 4 W Sec. 4 County DOUGLAS

State OR Date 2-7-84 No. _____

Corner Designation

$\frac{1}{4} \begin{matrix} S & 4 \\ \hline S & 9 \end{matrix}$

- Condition Report Only
- Not Found
- Renewed
- Unrecorded
- Surveyed In
- Referenced Out

ADDITIONAL COMMENT

~~Previous Renewals~~

~~Monument(s) Found: (Condition and Source)~~

WE DO NOT FIND SUFFICIENT EVIDENCE TO DISPROVE THE FOUND MONUMENTS BY BOYER AND HAINES (REN. # 5 & #68) NOR DO WE FIND SUFFICIENT EVIDENCE TO SUPPORT THE POSITION OF THE UNOFFICIAL BLM MONUMENT FOR THE QUARTER CORNER POSITION

REGISTERED
PROFESSIONAL
LAND SURVEYOR

Larry E. Monrean

OREGON
JULY 13, 1979
LARRY E. MONREAN
#1830

Accessories Found: