

GOVERNMENT CORNER RESTORATION FORM

Township 23 S Range 9 W Sec. 24 County DOUGLAS

State OREGON Date 1-25-84 No. _____

Corner Designation

T 23 S
R
9 C C 524
W 525

- Condition Report Only
- Not Found
- Renewed
- Unrecorded
- Surveyed In
- Referenced Out

Previous Renewals 1967 REN. #26 T.23-9 #67 T.23-8

Monument(s) Found: (Condition and Source)

ORIGINAL MONUMENT NOT FOUND.

FOUND 1" X 30" IRON PIPE WITH BRASS CAP (REN. #26)
LYING LOOSE ON TOP OF GROUND.

COUNTY SURVEYORS OFFICE

T 23 S

R
9
W

S 24	R
S 25	B

W

NOTE:

AS TRACY (REN #26) FOUND THE ORIGINAL BT'S
TO BE REFERENCED BY SLOPE DISTANCES, WE
DETERMINE A POINT USING RECORD BEARINGS AND
SLOPE DISTANCES TO THE FACE OF THE ORIGINAL
BEARING TREES, HOLDING RECORD DISTANCES AS

C.C.

1967

Accessories Found:

HORIZONTAL DOES NOT AGREE WELL WITH BEARINGS,
NOR DOES HOLDING SLOPE DISTANCES TO THE CENTER OF THE ROOT CROWN

FROM THE POINT DETERMINED THE ORIGINAL BEARING TREES WERE FOUND AS
FOLLOWING.

1. A 48" NOW 65" FIR BARK SCRIBED "T2 S R W 25 BT" BEARS S 73 1/2° W
38 1/2 SLOPE DISTANCE TO FACE (HORIZONTAL DIST = 34° FT. TO FACE AND 37° FEET
TO CENTER OF ROOT CROWN).

2. A 12" NOW 28" CEDAR WITH RESCRIBING "BT" VISIBLE IN PARTIALLY HEALED
BLAZE BEARS N 50° W 20° FEET SLOPE DIST. TO FACE (HORIZONTAL DIST. =
14° TO FACE AND 15° FEET TO CENTER OF ROOT CROWN WHICH AGREES WITH
DISTANCE PER RENEWAL #26).

BT FROM RENEWAL NO. 26

3. A 5" NOW 8" DIA. TRUNK OF A 4 TRUNK MAPLE WITH WELL HEALED BLAZE
BEARS S 79 1/2° W 11° FEET HORIZONTAL TO CENTER OF SCRIBED TRUNK
(REC. S 74 1/2° W 11° FEET). CENTER OF ROOT CROWN IS 12° FEET.

#129 T23-8
#91 T.23-9

RENEWAL

Monument Detail


Monument Set (Procedure and Description)

AT POINT PREVIOUSLY DESCRIBED WE DIG DOWN TO
 BED ROCK AND CHISEL A "+", 7" X 7" IN BEDROCK,
 OVER THIS POINT IN A MOUND OF STONE AND SOIL
 WE SET THE 1" X 30" IRON PIPE WITH BRASS CAP AS
 NOTED. WE ADD THE MARKS "RESET 1984" TO
 BRASS CAP.

New Accessories

A 10" DIA. HEMLOCK DOUBLE BLAZED AND SERIATED " X CS BT" BEARS S 66° E 17 2/3 FEET
 TO CENTER OF ROOT CROWN.

Sketch of Monument, Accessories, and General Area

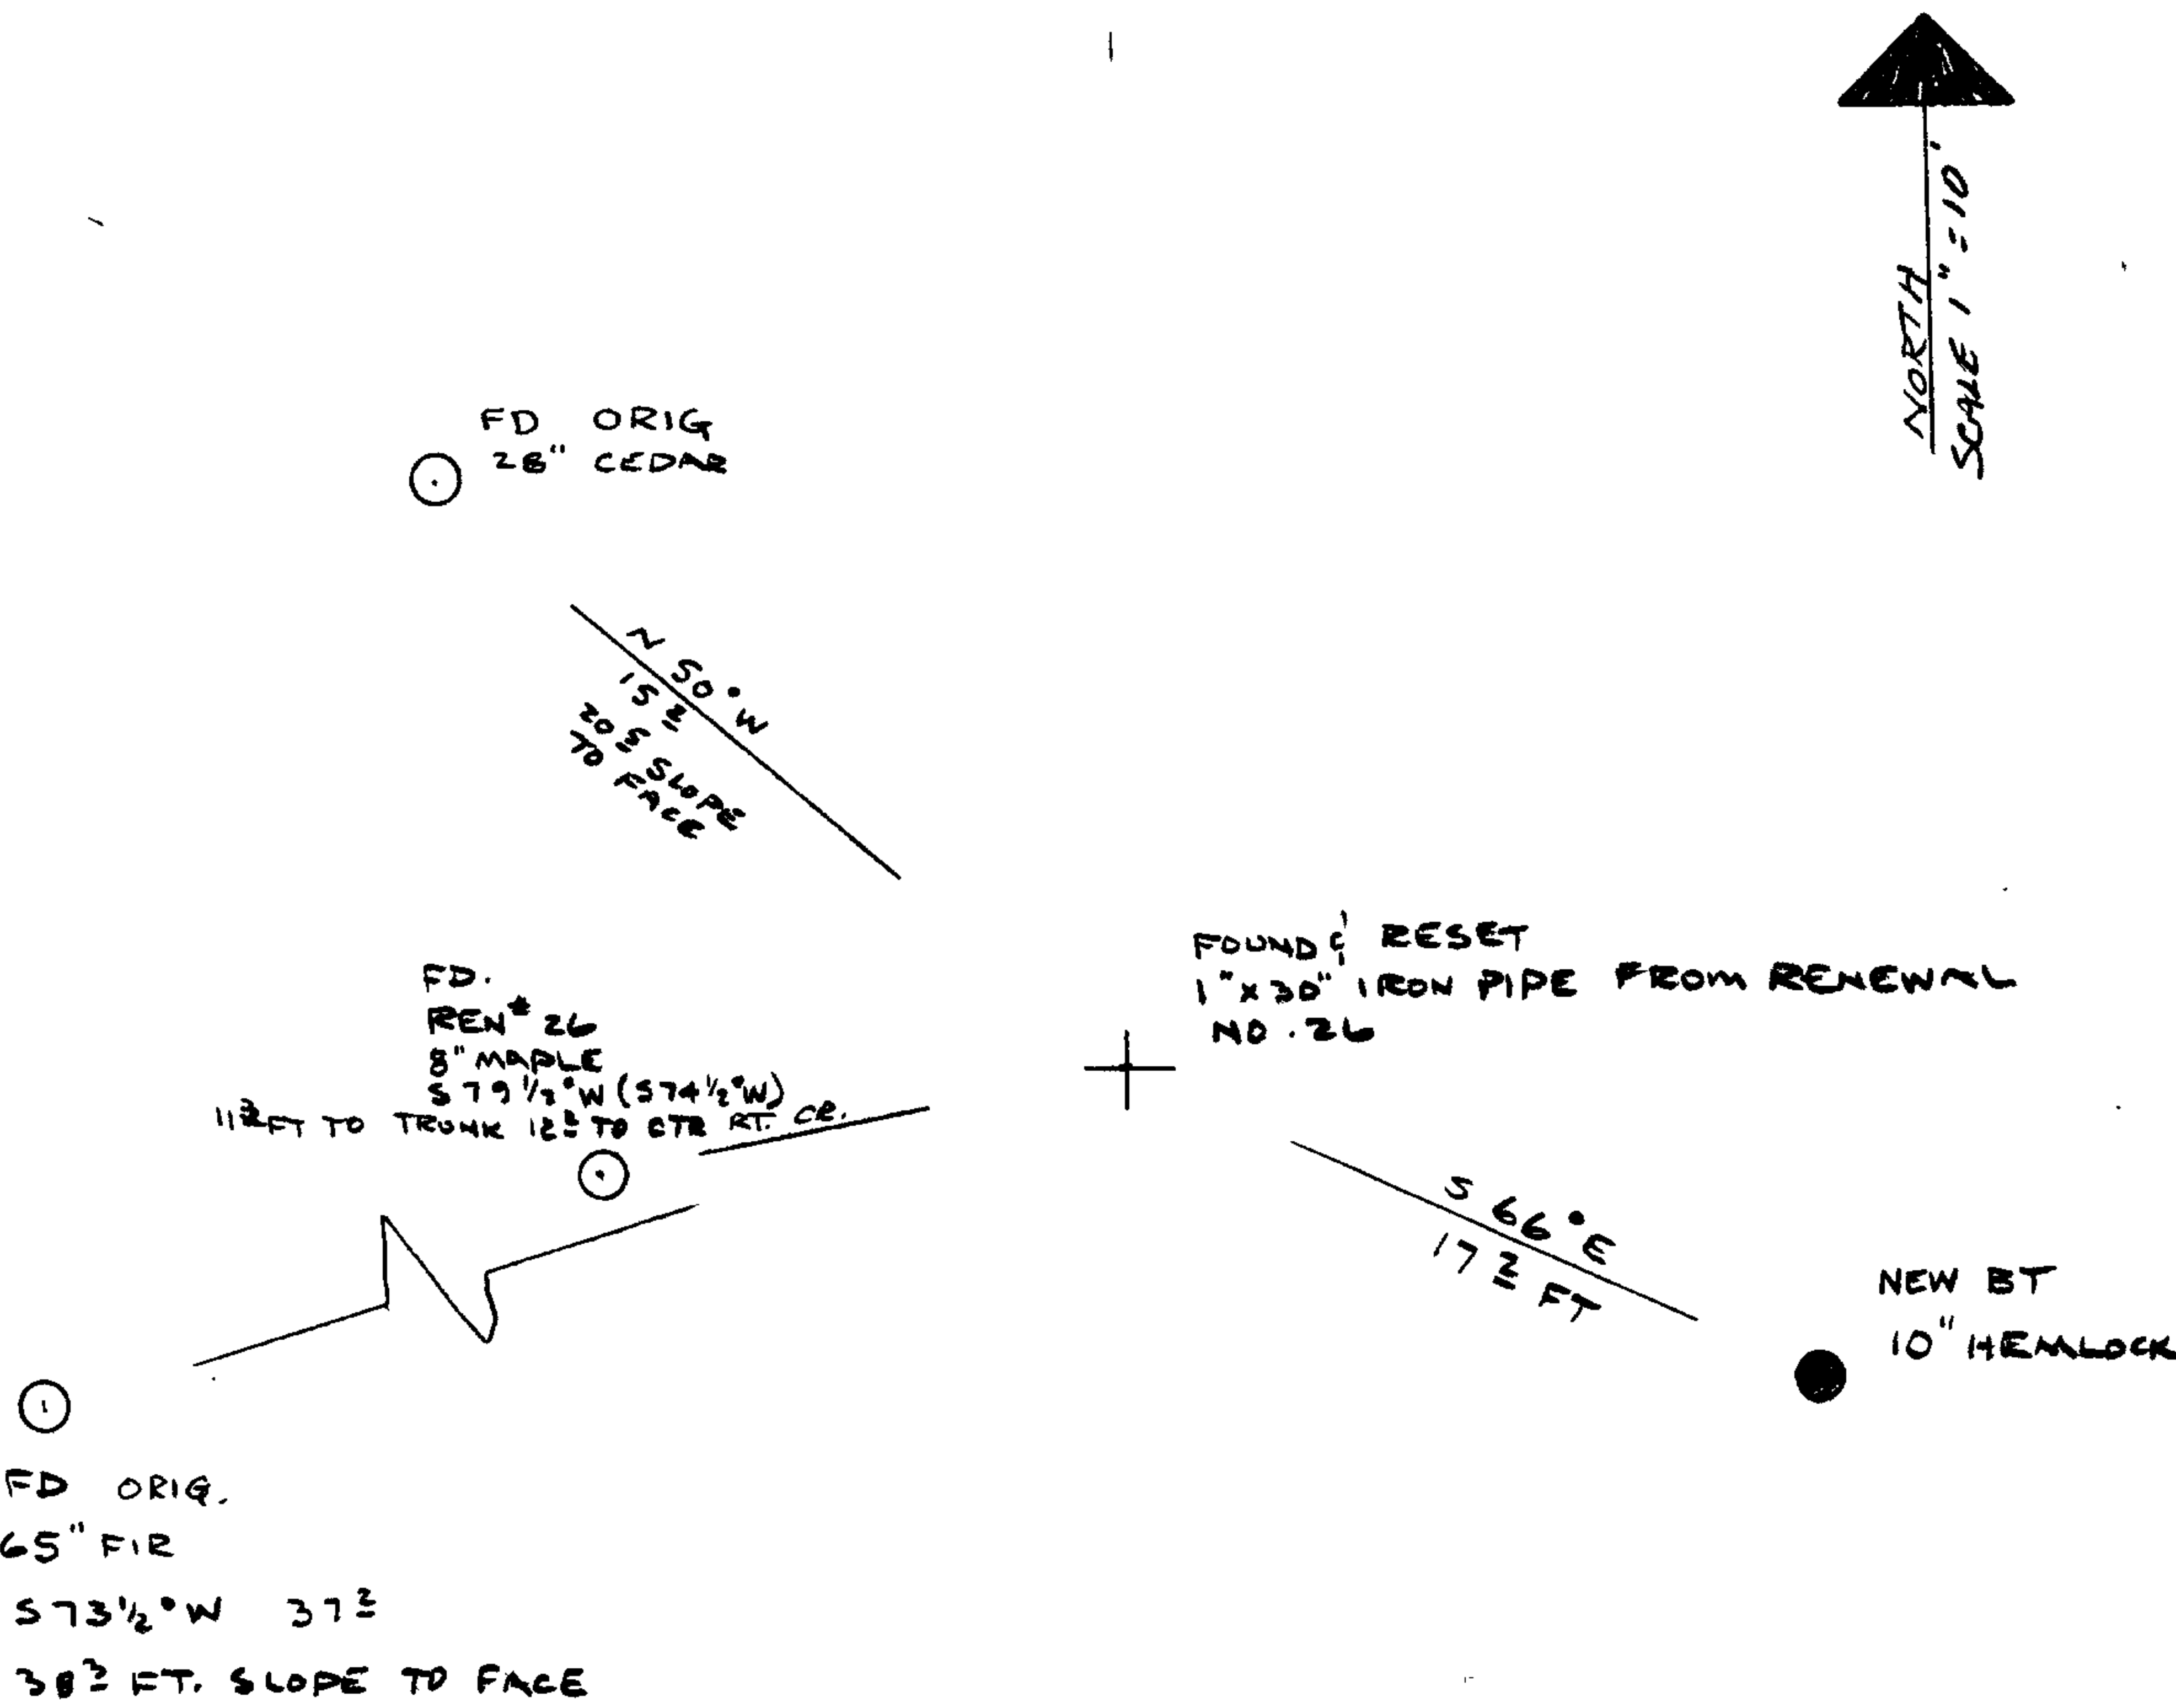

Location & Comments

THIS CORNER LIES ON A STEEP EASTEELY SLOPE.

Comp. Declin. 19° EAST
 Agency DOUGLAS CO. SURVEYOR'S OFFICE
 Party Chief LARRY E. MONREAN
 Notekeeper " " "
 Witnesses R. W. SMITH SJ. FRAUSE

Surveyor's Seal

REGISTERED
 PROFESSIONAL
 LAND SURVEYOR

Larry E. Monrean

OREGON
 JULY 13, 1979
 LARRY E. MONREAN
 #1830