

GOVERNMENT CORNER RESTORATION FORM

Township 24S Range 7W Sec. 6 County DOUGLAS
State OR Date 3/5/84 No. _____

Corner Designation

S36

S 1 | 56

- Condition Report Only
- Not Found
- Renewed
- Unrecorded
- Surveyed In
- Referenced Out

Previous Renewals #79, #98, #133

Monument(s) Found: (Condition and Source)

FOUND IRON PIPE WITH BRASS CAP
PROTRUDING 12" ABOVE GROUND PER.
REN. #79. MARKED AS NOTED.

FOUND IRON PIPE WITH BRASS CAP
PROTRUDING 8" ABOVE GROUND PER.
REN. #133 MARKED AS NOTED.

Accessories Found:

DCSO AM PER. REN. #98

A 8" NOW A 17" W. FIR, WELL HEALED DOUBLE BLAZE
BEARS EAST, 32.8 FT.

A 6" NOW A 11" D. FIR, WELL HEALED SINGLE BLAZE
BEARS S53°W, 74.2 FT.

PLS 1039 CORNER PER. REN#133

A 12" FIR, PARTIALLY HEALED DOUBLE BLAZE WITH VISIBLE SCRIBING "T24"
BEARS S62°W, 64.1 FT.

A 8" FIR, PARTIALLY HEALED DOUBLE BLAZE WITH VISIBLE SCRIBING "BT"
BEARS S55°E, 11.2 FT.

MONUMENT DETAIL

COUNTY SURVEYORS OFFICE

T23S
 R AM R
 8 C.C. 7
 W S1 | 56 W
 T24S
 1960

PLS 1039
 T23S R8W
 S36
 S1 | 56 T24S
 R8W R7W
 1979

#130 T.23-8
#155 T.24-7
#105 T.24-8

C.S. File No. 62/16-7

✓

RENEWAL


Monument Detail

Monument Set (Procedure and Description)

THE LETTERS "AM" WERE ADDED
TO THE DCSSO CLOSING CORNER CAP

New Accessories

Sketch of Monument, Accessories, and General Area

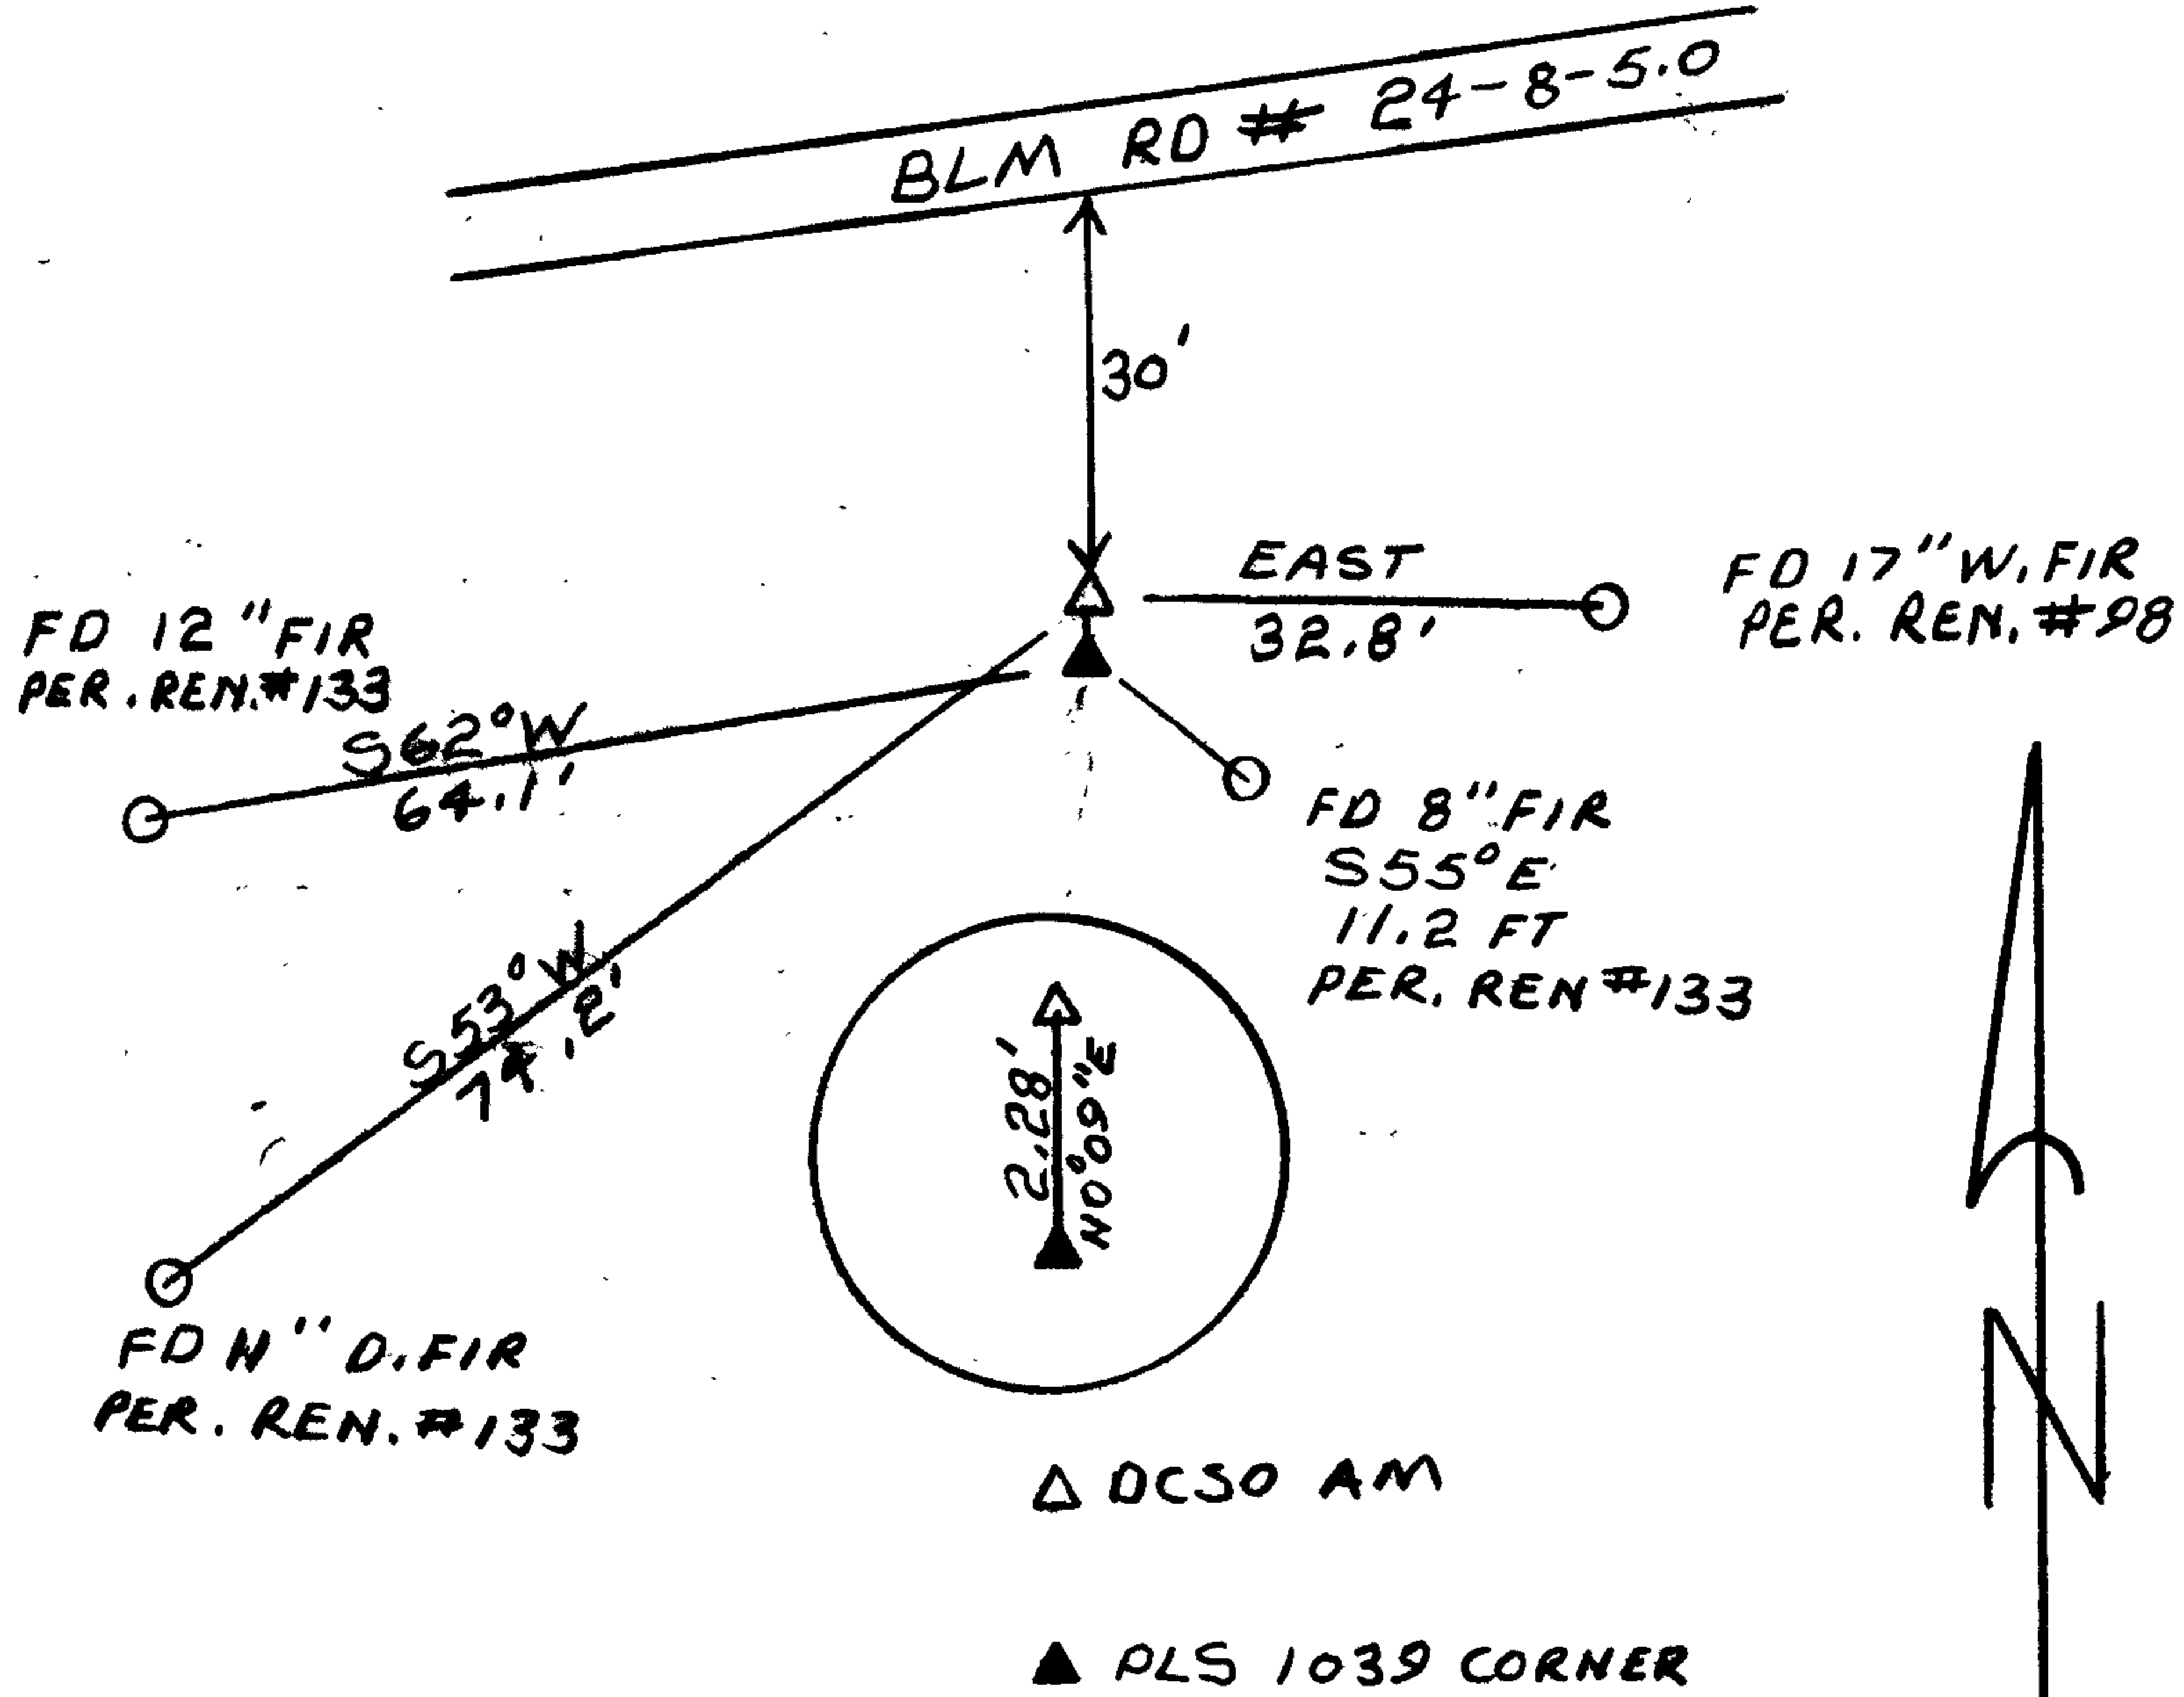

Location & Comments

~~AM WAS STAMPED ON DCSSO~~
~~CROSS CAP.~~

Comp. Declin. 19° EAST
Agency DCSSO
Party Chief RANDALL W. SMITH
Notekeeper Randall W. Smith
Witnesses STEPHEN FLAUSE

Surveyor's Seal

REGISTERED
PROFESSIONAL
LAND SURVEYOR

Larry E. Monrean

OREGON
JULY 13, 1979
LARRY E. MONREAN
#1830