

GOVERNMENT CORNER RESTORATION FORM

Township 27S Range 4W Sec. 23 County DOUGLAS

State OR Date 2/10/84 No. _____

Corner Designation

$\frac{14}{23}$

- _____ Condition Report Only
- _____ Not Found
- Renewed
- _____ Unrecorded
- _____ Surveyed In
- _____ Referenced Out

Previous Renewals # 53

Monument(s) Found: (Condition and Source)
USBLM CADASTRAL SURVEY CAP ON
2 1/2" IRON PIPE PROTRUDING 5" ABOVE GROUND
AND STAMPED →

COUNTY SURVEYOR CAP ON 1 1/4" IRON PIPE
PROTRUDING 9" ABOVE GROUND
STAMPED

$\frac{1}{4}$ S14
 $\frac{1}{4}$ S23

T27S R4W
1959

T27S R4W
 $\frac{1}{4}$ S14
S23
1975

Accessories Found:

BYRON'S C.S. CAP FOUND PER BLM RECORD, N10°10'W 19.1 FT
FROM BLM MONUMENT.

BYRON'S 4" FIR (NOW 13" FIR WITH WELL HEALED DOUBLE BLAZE)
FOUND PER BYRON'S RECORD, N1°30'E 40.6 FT. - ALSO BEARS
N3°W 59.5 FT. FROM BLM MONUMENT.

BYRON'S 12" B. OAK (NOW 17" WITH WELL HEALED DOUBLE BLAZE)
FOUND PER BYRON'S RECORD, S83°W 26.0 FT. - ALSO BEARS
N61°W 33.0 FT FROM BLM MONUMENT. NOTE: THIS TREE'S
SCRIBING IS FOR THE WRONG SECTION.

A 10" OAK WITH NEARLY HEALED BLAZE BEARS N74°W 30.6 FT
(BLM REC. N74°W 30.4 FT.)

AN 8" OAK WITH PARTIALLY HEALED BLAZE BEARS
S47 1/2°W 31.5 FT (BLM RECORD S42°W 31.0 FT)

NO EVIDENCE OF ORIGINAL CORNER OR ACCESSORIES
FOUND.

✓
#141

File No. 62/16-120 ✓

RENEWAL

Monument Set (Procedure and Description)


Monument Detail

WE CUT CAP OFF BYRON'S 1/4" I.P.
 AND PLACE YELLOW PLASTIC CAP
 INSIDE PIPE WHICH IS STAMPED
 "DOUG. CO. SUNEYOR" (SIC)

New Accessories COMMENTS

BYRON CLEARLY STATES ON SURVEY M14-42 THAT HE SINGLE PROPORTIONED
 IN ⁵¹⁴/₂₁₂₃. THIS POSITION FOR THE S.W. COR S.14 CONTROLLED HIS
 POSITIONS FOR S 1/4 S.14 AND W 1/4 S.23. BLM PROPERLY PROPORTIONED THESE
 CORNERS IN 1975.

Sketch of Monument, Accessories, and General Area

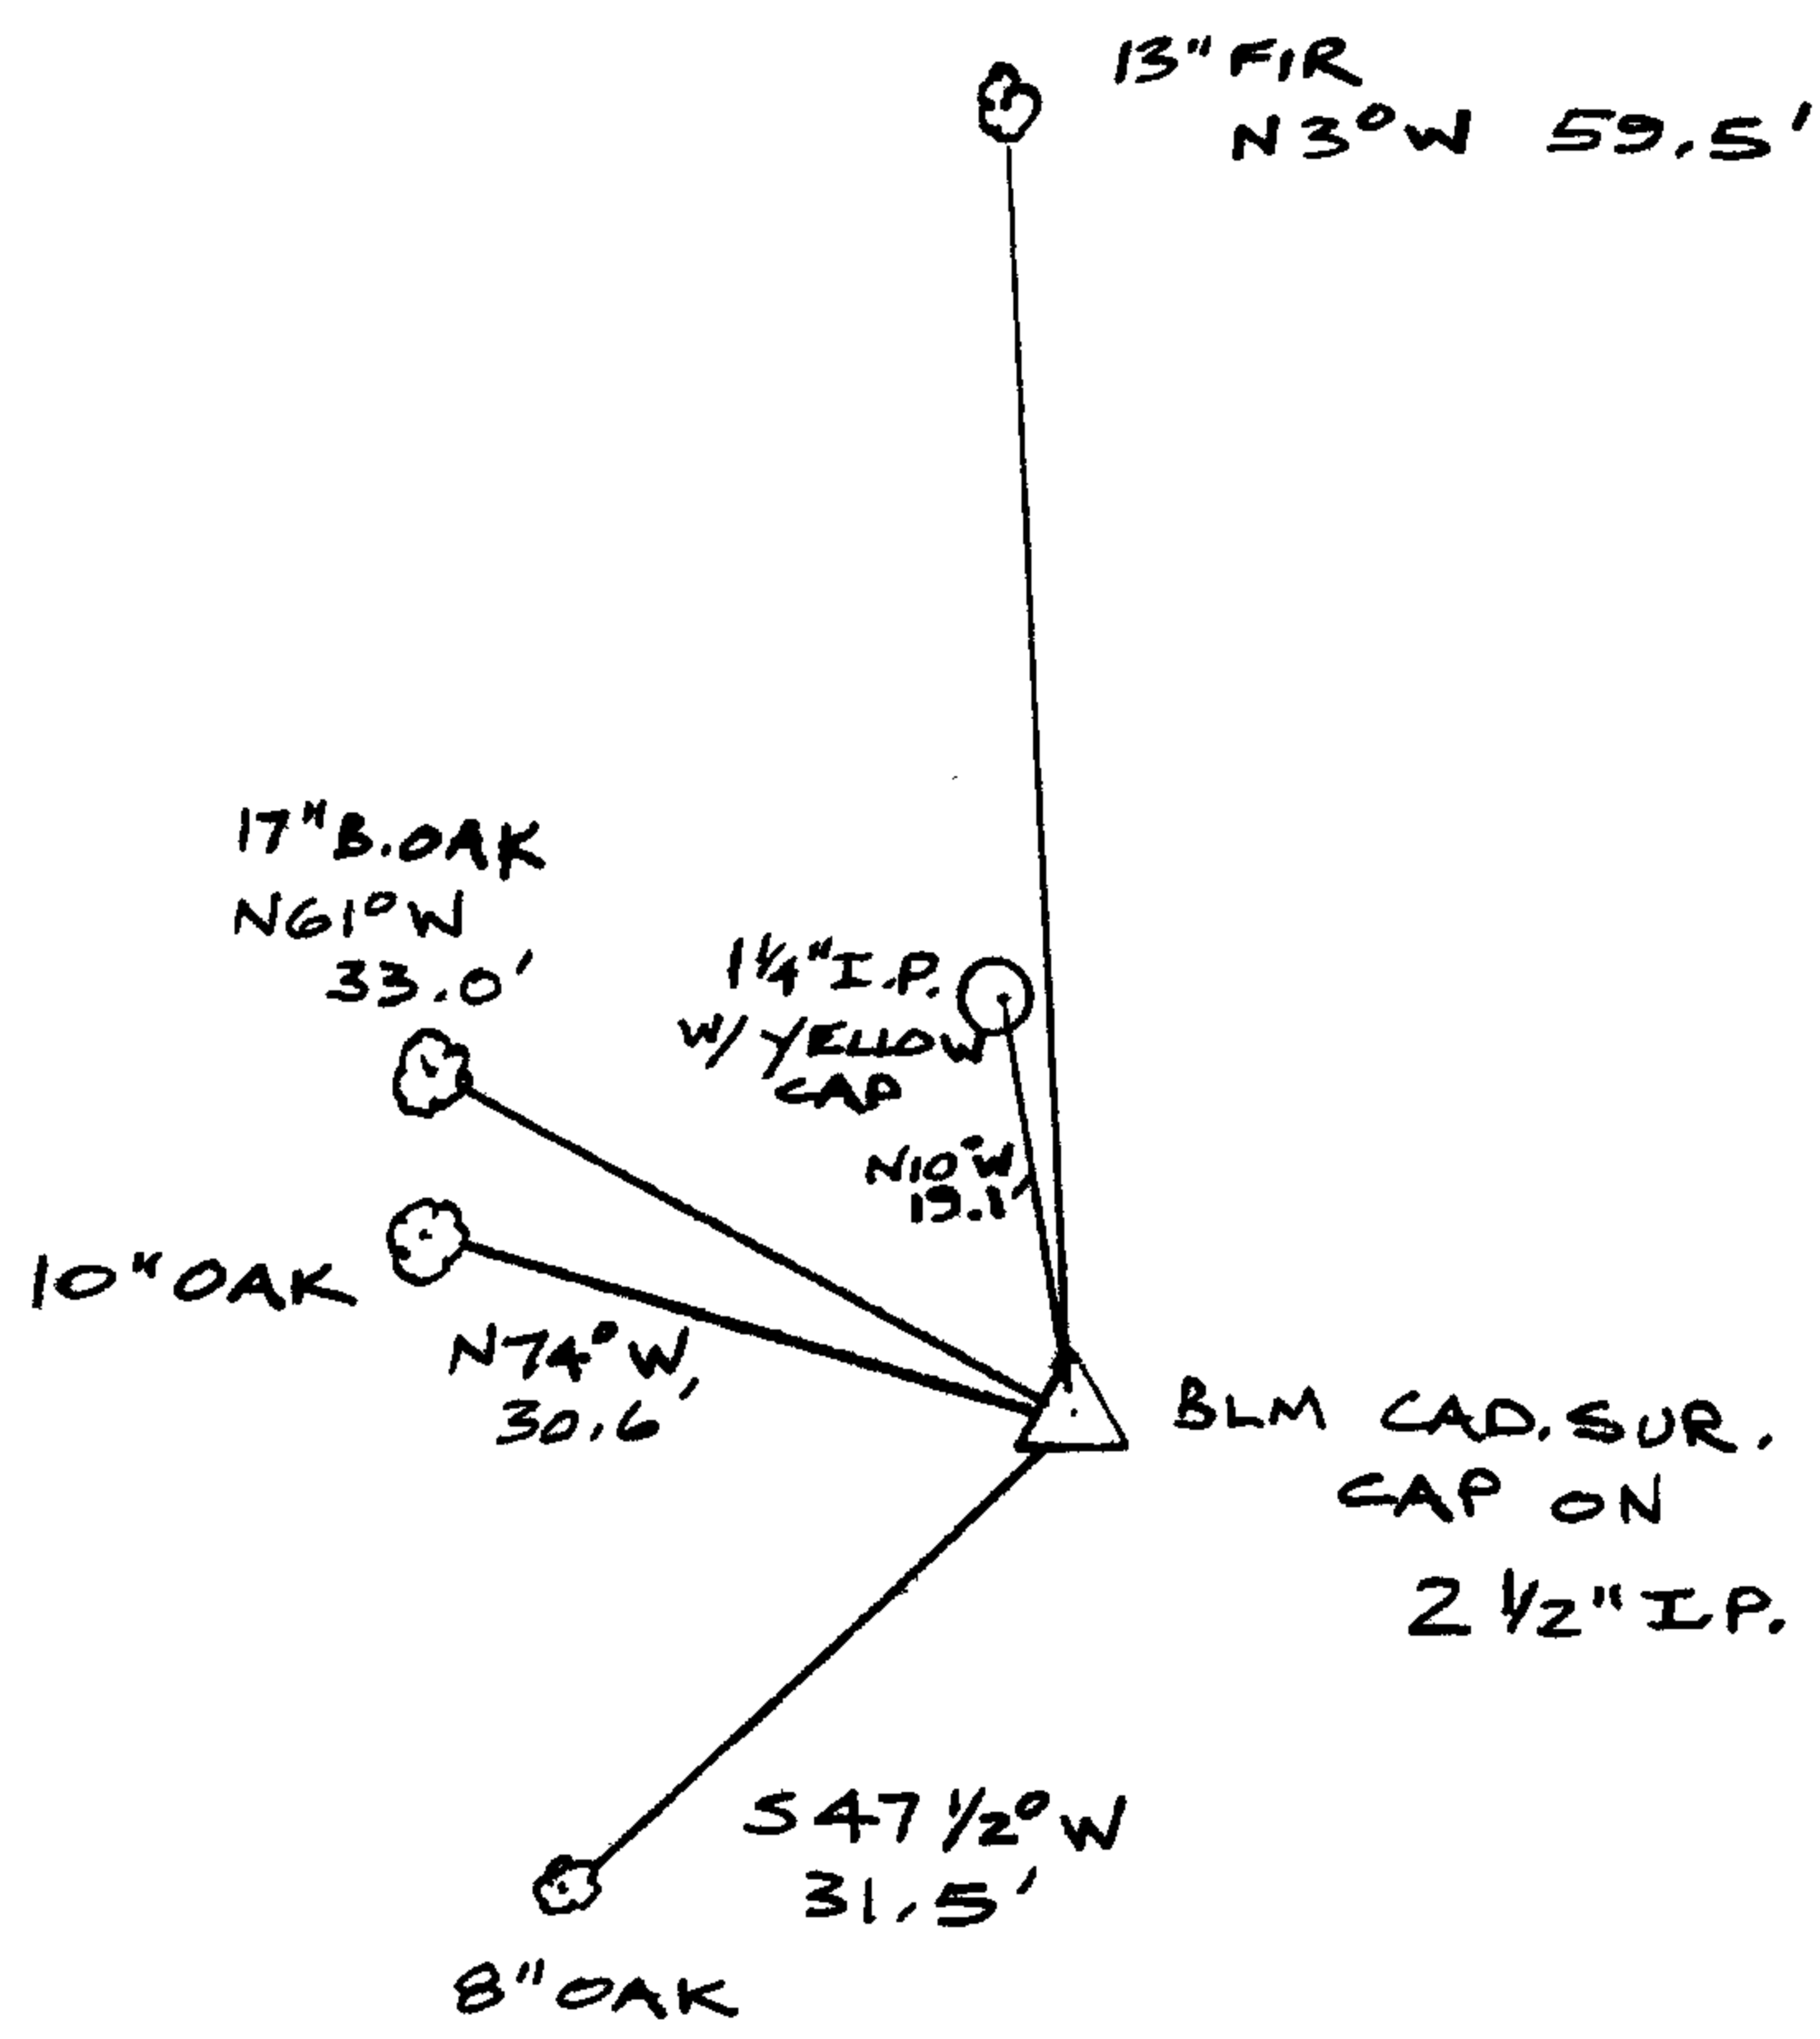

1" = 30'

Location & Comments

Comp. Declin. 19° E
 Agency DOUGLAS CO. SURVEYOR
 Party Chief L. E. MONREAN
 Notekeeper JANET LUNDEEN
 Witnesses RANDY SMITH

Janet Lundeen

Surveyor's Seal

REGISTERED
 PROFESSIONAL
 LAND SURVEYOR

Larry E. Monrean

OREGON
 JULY 13, 1979
 LARRY E. MONREAN
 #1830