


GOVERNMENT CORNER RESTORATION FORM

Township 30S Range 3W Sec. 6 County DOUGLAS

State OR Date 2/29/84 No. _____

Corner Designation

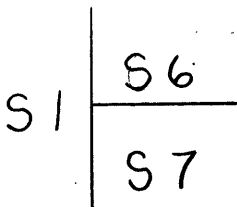


- Condition Report Only
- Not Found
- Renewed
- Unrecorded
- Surveyed In
- Referenced Out

Previous Renewals #61

Monument(s) Found: (Condition and Source)
FD. 1" IRON PIPE WITH BRASS CAP PER REN#61
PROTRUDING 10" ABOVE GROUND MARKED AS
NOTED. ALSO FD. PARTIALLY BURIED CORNER
STONE ALONG SIDE IRON PIPE FOUR NOTCHES
VISIBLE ON STONE (CORNER STONE IS FROM
W.M. THEIL 1889 RESURVEY).

COUNTY SURVEYORS OFFICE

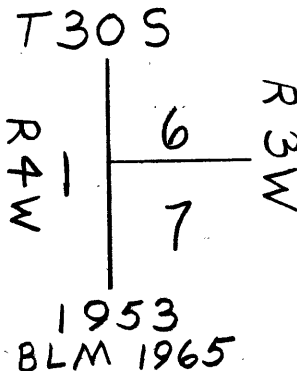

Accessories Found:

NO ORIGINAL BT'S FOUND

- ① FD. 36" FIR NOW A 30" DIA. FIR STUMP. 4 FT HIGH AND ROTTED
BEARS S88°E, 21.8 FT (REC. N88°E, 19.8 FT). BLM 1965 RESURVEY
CALLS THIS STUMP AN ORIGINAL BT, THIS BT CAME FROM W.M. THEIL
1889 RESURVEY.
- ② FD. 10" MAPLE NOW A DOWNED TREE, ROOT HOLE BEARS S19°E, 25.6 FT.
BT HAS PARTIALLY HEALED BLAZE AND ILLEGIBLE SCRIBING VISIBLE. BLM 1965
RESURVEY CALLS THIS TREE AN ORIGINAL BT, THIS BT CAME FROM W.M. THEIL
1889 RESURVEY.

NO OTHER BT'S BY W.M. THEIL 1889 RESURVEY FOUND FOR CORNER.

- ③ FD. 18" NOW 28" DIA. FIR WITH SINGLE HEALED BLAZE
BEARS S50°W, 31.7 FT. PER. REN. #61

NO OTHER BT'S PER. REN#61 FOUND

- ④ FD. 12" NOW A 20" DIA. D. FIR WELL HEALED DOUBLE BLAZE
BEARS N61°E, 97.7 FT. BT IS FROM BLM 1965 RESURVEY.

#230 (T.30-3)
#285 (T.30-4)

C.S. File No. 62/16-18

C✓

