

GOVERNMENT CORNER RESTORATION FORM

Township 32 S Range 4 W Sec. 7 County DOUGLAS

State OREGON Date 3-26-84 No. _____

Corner Designation

	T	32	S	
R		512	57	R
S				A
W		513	518	W

- Condition Report Only
- Not Found
- Renewed
- Unrecorded
- Surveyed In
- Referenced Out

Previous Renewals 1922 RESURVEY, REN. # 2, 53, 97 AND 1971 BLM RESURVEY

Monument(s) Found: (Condition and Source)

FOUND 2" BAR (REC. 1 1/2" BAR 1971 BLM RESURVEY)
THE TOP OF THIS BAR IS SPREAD APPARENTLY
FROM DRIVING. THIS MONUMENT IS ABOUT 3"
BELOW GROUND IN A RECESSED AREA ALONG
WESTERN SIDE OF GRAVEL DRIVE.

WE DID NOT DIG DEEPER TO LOCATE
1971 BLM BRASS CAP MONUMENT.

MONUMENT DETAIL


Accessories Found:

REN. # 2¹³². A 10" NDW 32" DIA. FIR WITH WELL HEALED SINGLE BLAZE BEARS
S 60 1/2° E 59 5/8 FEET (REC. 60 3/8 FEET).

REN. # 97¹³²⁻⁴. A 6" NDW 9" DIA. FIR WITH WELL HEALED DOUBLE BLAZE BEARS
N 2° E 87 5/8 FEET.

REN. # 97¹³²⁻⁴. UTILITY POLE # E3457 BEARS N 21 1/2° W 24° FEET.

METAL DETECTOR

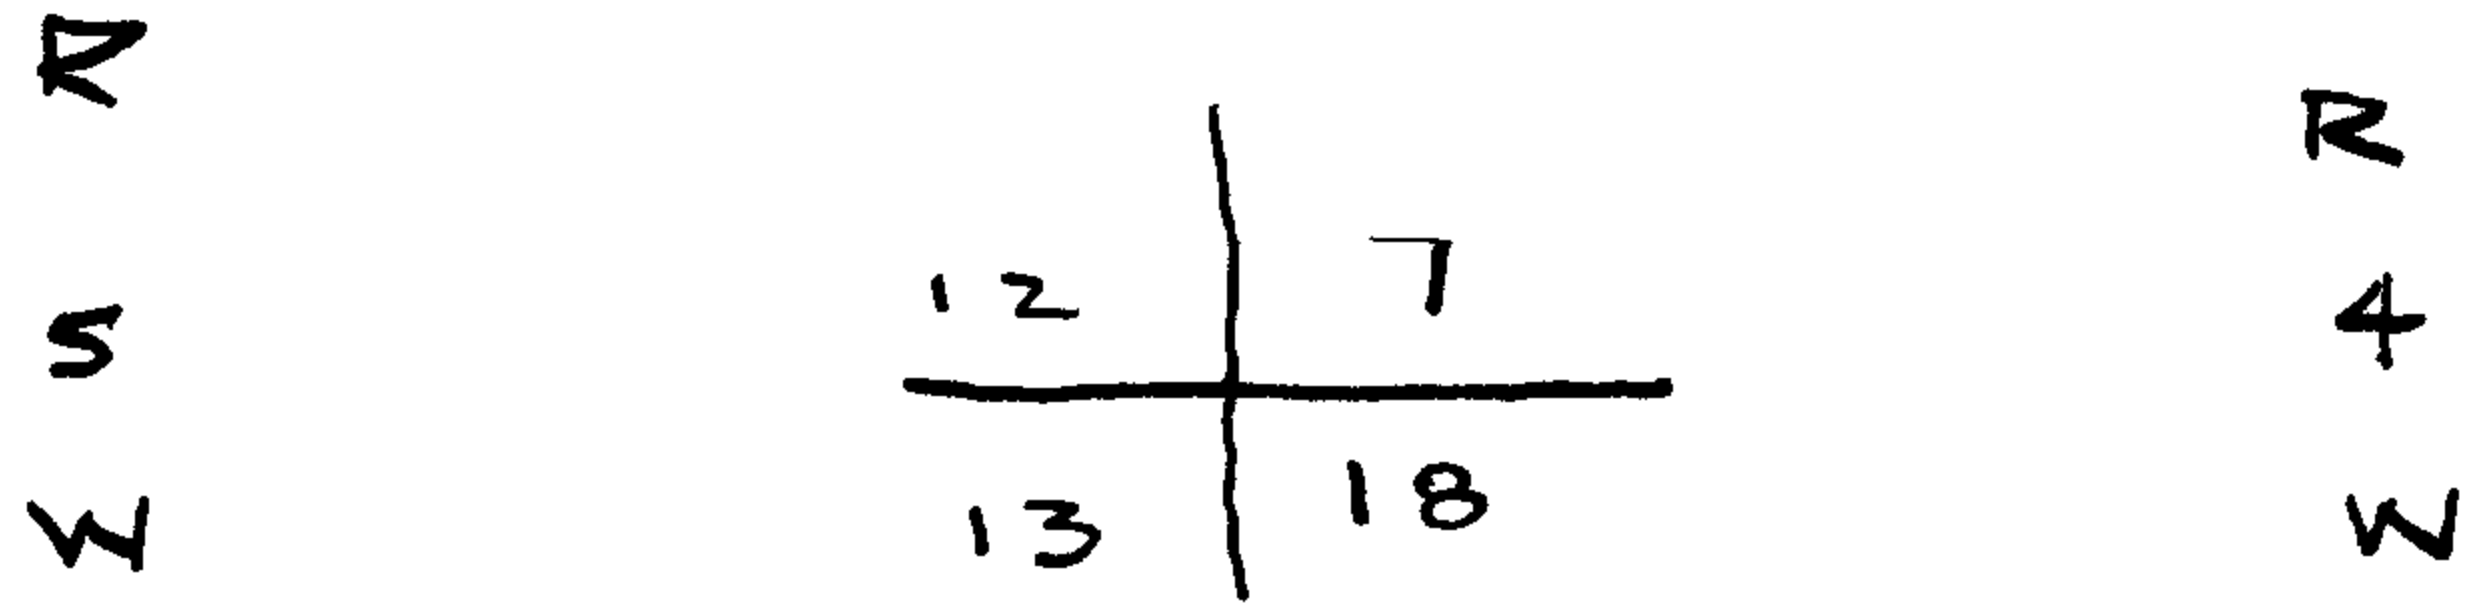

1854 ORIG SURVEY IVESE' HYDE V 20 PG 8452

SET POST

FIR	18"	N 48 W	62°
FIR	16"	N 51 E	46°
FIR	14"	S 46 E	11°
HEMLOCK	14	S 70 W	22°

1922 REN STEWART M 3-32 e' VOL. 3 PG 121

SET 2" BAR

OR. BT'S DOWN
NEW BT'S

FIR	24"	N 16 E	183°	FT
FIR	30"	N 71 E	216°	FT

1944 REN # 2 WENDEROTH

SET 1/2" x 38" I.P. EDGE OF DRIVEWAY
SET FROM STUMPS OF OLD BT'S

NEW BT'S

FIR	10"	S 60° 35' E	60°	FT
LIVEDAK	9"	N 4° 06' E	105°	FT

1953 REN # 53 WENDEROTH RECITES REN # 2

1966 REN # 97 POWELL

FD 1/2" IP

LINE OAK N 4 06 E TO BE CUT DOWN

C.S. File No. 62/16-21

NEW BTS

FIR 6" N 2 E 87.5 FT

POWER POLE # E3457 N 21 1/2° W 24° FT

1971 BLM

FD ① 1/2" DIA. IRON ROD (1922 MON?) NOT 1/2" IRON PIPE AS RECORDED
SINCE 1944

SET BLM MON 8" BELOW GROUND WITH 1 1/2" I R ALONG SIDE
THERE IS NO MENTION OF A 1/2" IRON PIPE

1983 SMITH

FD 1/2" I. ROD NO MENTION OF BLM MON., OR 1 1/2" IRON ROD

THE APPARENT DISCREPANCY OF MONUMENT DESCRIPTIONS FOR THIS
CORNER IS CAUSING CONFUSION, NEEDS TO BE RESOLVED