

GOVERNMENT CORNER RESTORATION FORM

Township 225 Range 4W Sec. 9 County DOUGLAS

State OREGON Date AUGUST 2, 1984 No. _____

Corner Designation

T225
1/4 59 | S10
R4W

- _____ Condition Report Only
- _____ Not Found
- Renewed
- _____ Unrecorded
- _____ Surveyed In
- _____ Referenced Out

Previous Renewals #38, BLM DEPENDENT RESURVEY 1963

Monument(s) Found: (Condition and Source)

MONUMENT DETAIL

COUNTY SURVEYOR'S OFFICE

T225

1/4 59 | S10

R4W

1958

1958

A 2 1/2 INCH DIAM. BRASS CAP ON A 1 INCH (I.D.)
X 36 INCH LONG GALVANIZED IRON PIPE.
MONUMENT REMOVED BY CONSTRUCTION OF
FIRE TRAIL IS FOUND LYING S42°E, 76 FT.
DIST FROM CORNER POSITION.
IRON PIPE RUSTED NEAR TOP.

Accessories Found:

AN ORIGINAL CEDAR 12 INS. DIAM. NOW A CEDAR STUMP 36 INCHES IN DIAM. AND
60 INCHES TALL BEARS N59°E, 125 FT. DIST. (AS PER RECORD) NO ORIGINAL SCRIBING
FOUND, BYRON RESCRIBE FROM RENEWAL #38 HAS OPEN FACE AND SHOWS SCRIBING
1/4 S10 CS BT. NO EVIDENCE OF OTHER ORIGINAL BT FOUND.

FROM RENEWAL #38 A 13" R. FIR NOW A 17 INCH D.B.H. D. FIR BEARS S41 3/4°W, 46 1/2 FT
DIST. (RECORD FROM RENEWAL #38 S41°W, 47 1/2 FT; BLM RECORD S47 1/2°W, 46 1/2 FT)

RENEWAL

Monument Set (Procedure and Description)

Monument Detail

MONUMENT FOUND IS REPLACED BY NEW CAP AND PIPE BECAUSE OF ITS RUSTED CONDITION. POSITION FOR NEW MONUMENT DETERMINED PRIMARILY FROM RECORD BEARING AND DISTANCE FROM FOUND ORIGINAL B.T.

NEW MONUMENT IS A 2 3/8 INCH BRASS CAP ON A 1 INCH (W.D.) X 32 INCH IRON PIPE FIRMLY SET AND PROTRUDING 7 INCHES FROM GROUND.

DOUGLAS CO. SURVEYORS OFFICE

T22S

1/4 S4 | S10

R4W

1984

New Accessories


A 9 INCH D.B.H. D. FIR BEARS S57 1/2° E, 17° FT. DIST. SCRIBED 1/4 S10 CSBT ON A DOUBLE BLAZE

A 13 INCH D.B.H. D. FIR BEARS S15° E, 44° FT. DIST. SCRIBED 1/4 S10 CSBT ON A DOUBLE BLAZE

A 12 INCH D.B.H. W. FIR BEARS S76 1/2° W, 22° FT. DIST SCRIBED 1/4 S9 CSBT ON A DOUBLE BLAZE

Sketch of Monument, Accessories, and General Area

Location & Comments

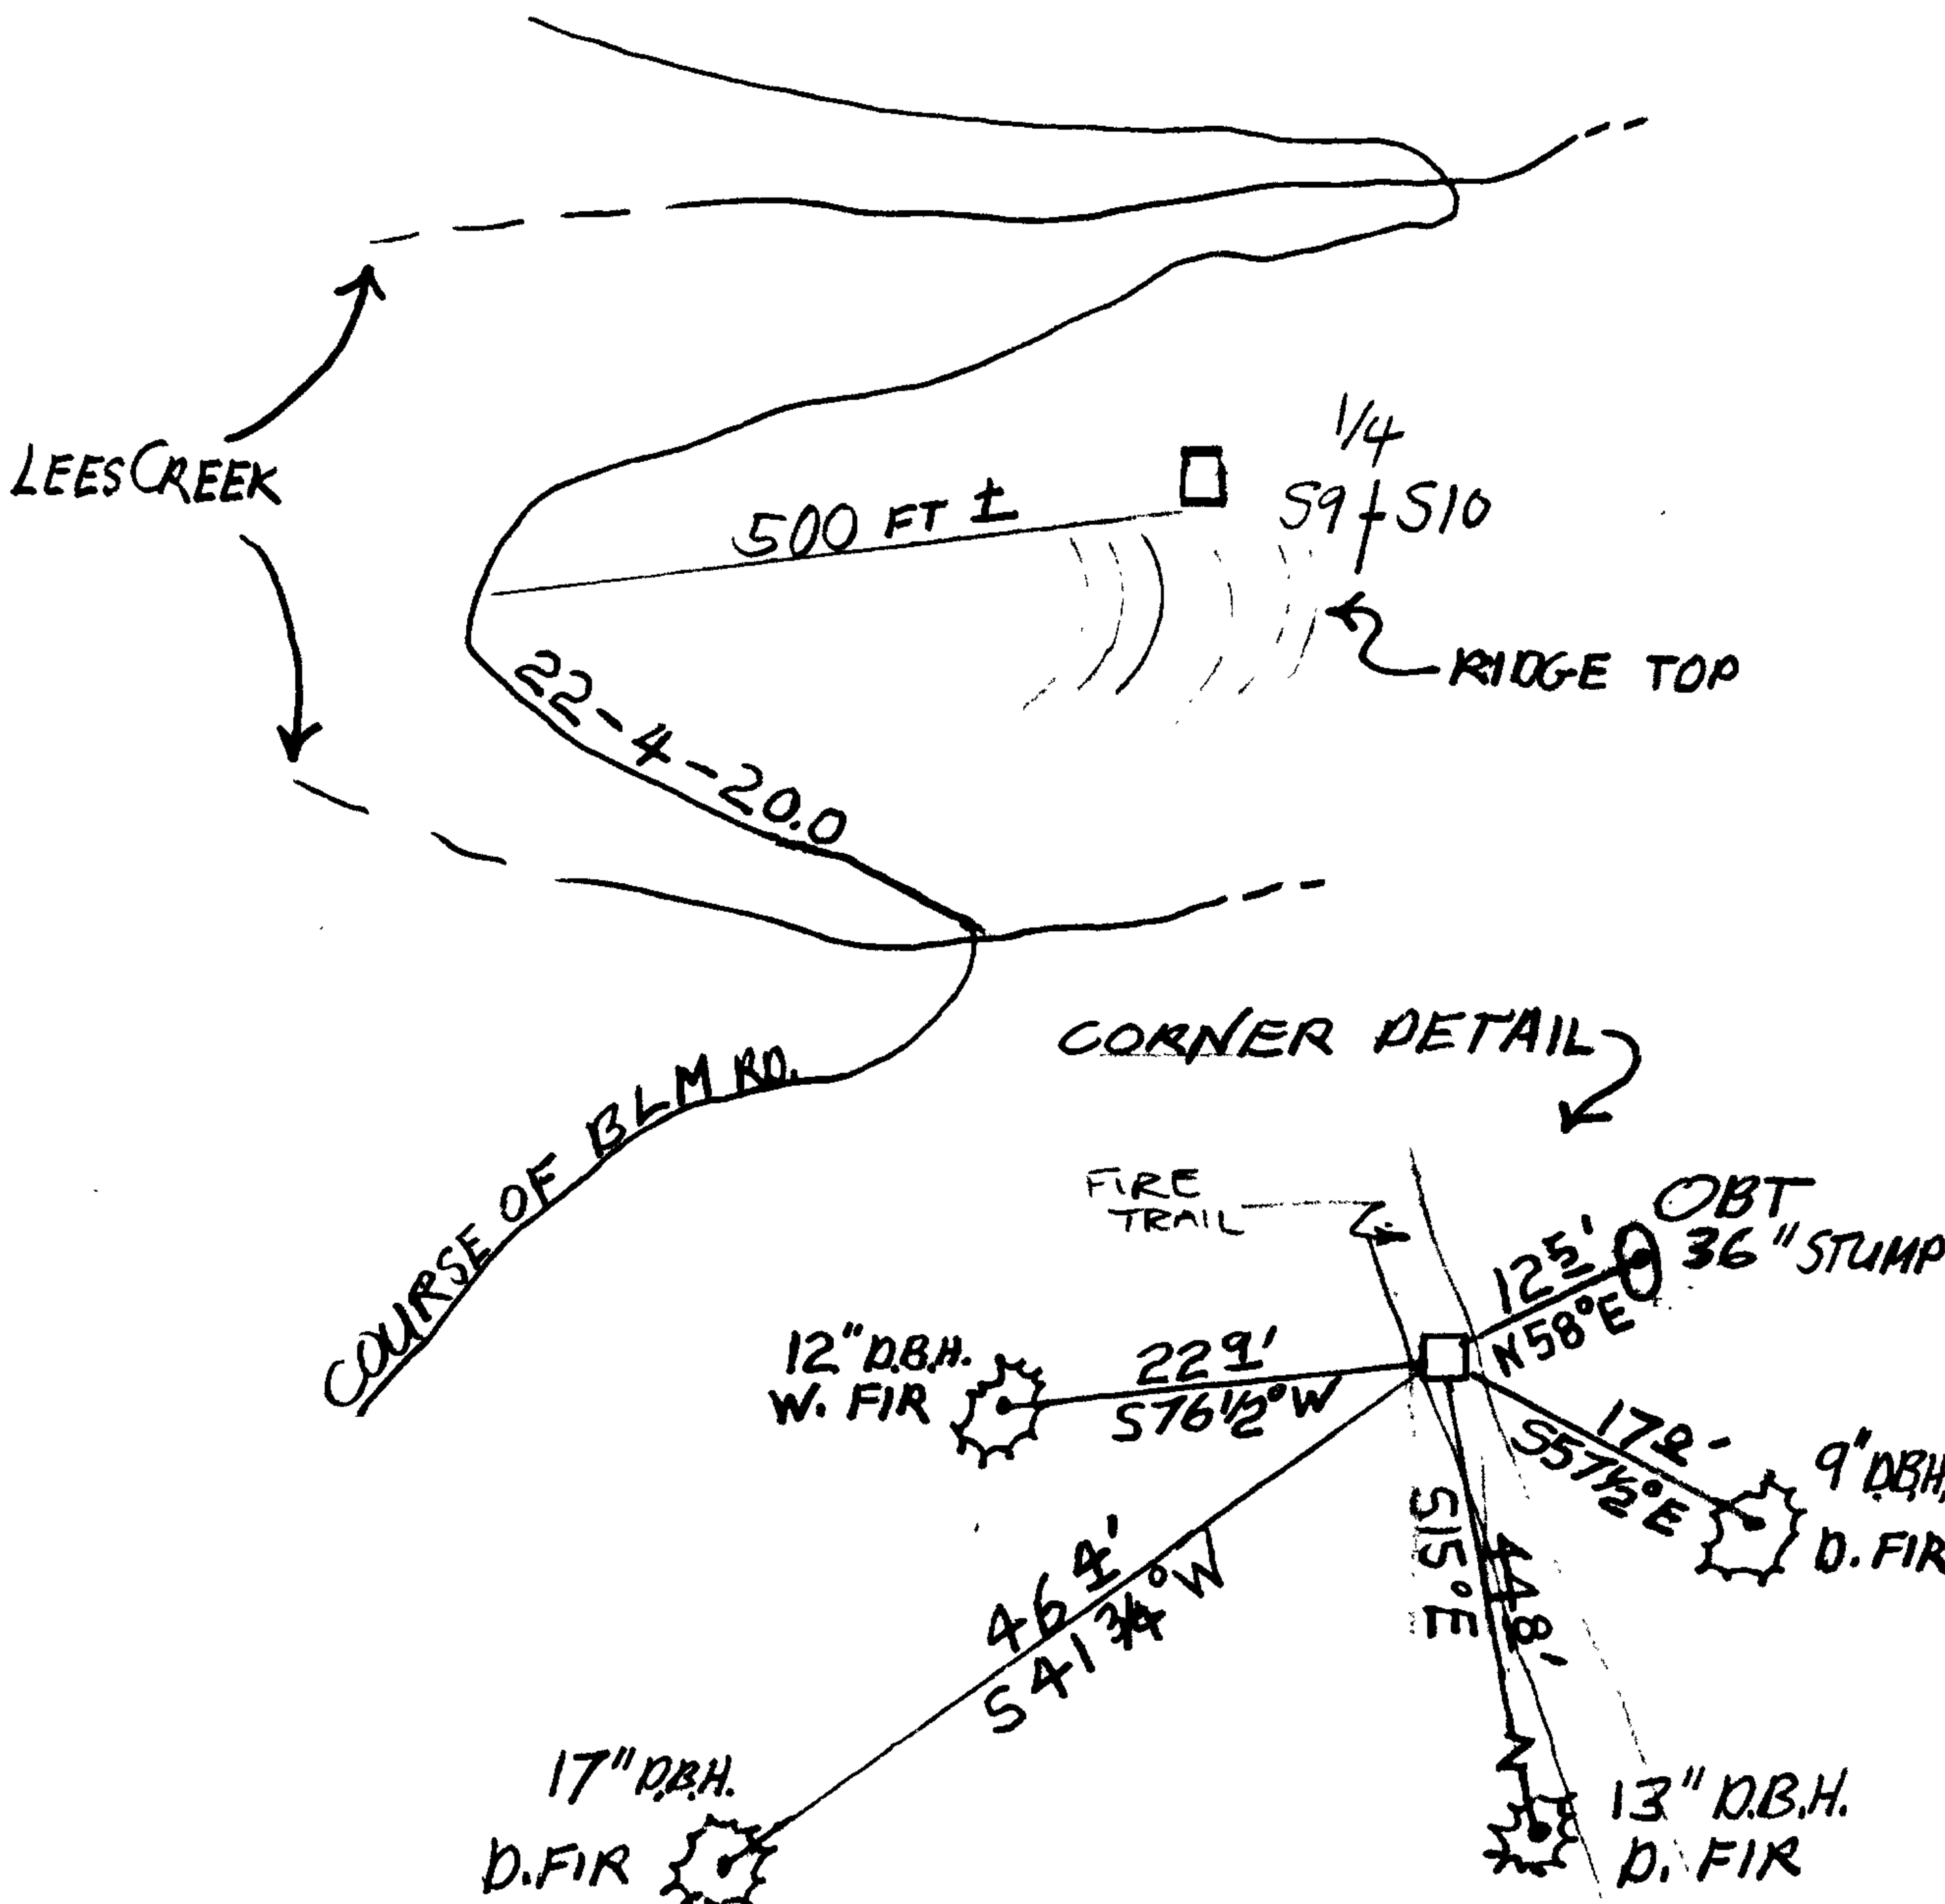

CORNER IS LOCATED 80+ FT NORTH OF RIDGE TOP ACCESSED FROM BLM RD. 22-4-20.0. (SEE SKETCH)

Comp. Declin.
 Agency DCSO
 Party Chief L. E. MONREAN
 Notekeeper Stephen John Plank
 Witnesses R. W. SMITH

Surveyor's Seal
 REGISTERED PROFESSIONAL LAND SURVEYOR

Larry E. Monrean
 OREGON
 JULY 13, 1979
 LARRY E. MONREAN
 #1830