

GOVERNMENT CORNER RESTORATION FORM

Township 27 S Range 6 W Sec. 27 County DOUGLAS

State OREGON Date MAY 14, 1984 No. \_\_\_\_\_

Corner Designation

28	27
33	34

- Condition Report Only
- Not Found
- Renewed
- Unrecorded
- Surveyed In
- Referenced Out

Previous Renewals NONE

Monument(s) Found: (Condition and Source)

NO EVIDENCE OF ORIGINAL CORNER MONUMENT OR ACCESSORIES FOUND.

THIS AREA HAS BEEN CLEARED FOR PASTURE.

Accessories Found:

MONUMENT DETAIL

RENEWAL

Monument Set (Procedure and Description)

*[This section is crossed out with a diagonal line.]*

Monument Detail

New Accessories

*[This section is crossed out with a diagonal line.]*

Sketch of Monument, Accessories, and General Area

*[This section is crossed out with a diagonal line.]*

Location & Comments


*[This section is crossed out with a diagonal line.]*

Comp. Declin. \_\_\_\_\_  
Agency DOUGLAS CO. SURV. OFFICE  
Party Chief L. E. MONREAN  
Notekeeper Jerry E. Monrean  
Witnesses \_\_\_\_\_

S. J. FLAUSE

RM 205 JUSTICE BLDG  
ROSBURG, OR 97471

Surveyor's Seal

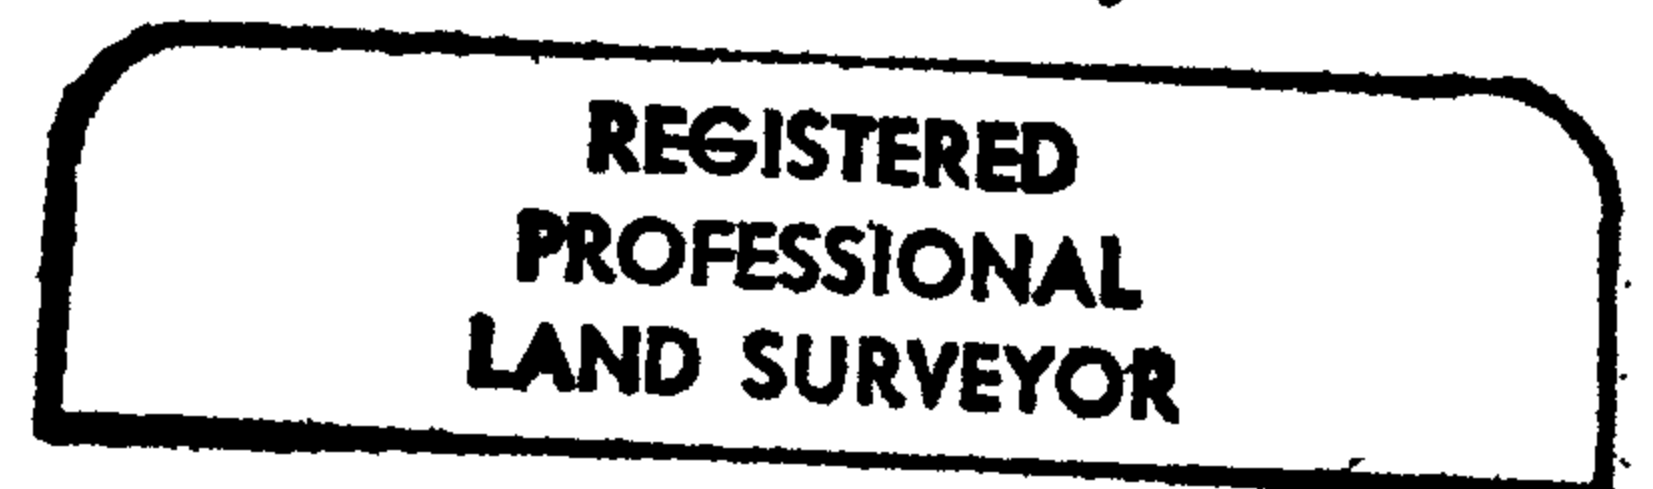

Jerry E. Monrean

