

GOVERNMENT CORNER RESTORATION FORM

Township 27 S Range 6 W Sec. 27 County DOUGLAS

State OREGON Date MAY 14, 1984 No. _____

Corner Designation

$\frac{1}{4} \frac{S 27}{S 34}$

- Condition Report Only
- Not Found
 - Renewed
 - Unrecorded
 - Surveyed In
 - Referenced Out

Previous Renewals NONE

Monument(s) Found: (Condition and Source)

NO EVIDENCE OF ORIGINAL CORNER
MONUMENT OR ACCESSORIES FOUND.

THIS AREA HAS BEEN CLEARED FOR
PASTURE.

MONUMENT DETAIL

Accessories Found:

RENEWAL

Monument Set (Procedure and Description)

Monument Detail

Handwritten notes in the Monument Set section, including a diagonal line across the grid.

New Accessories

Handwritten notes in the New Accessories section, including a diagonal line across the grid.

Sketch of Monument, Accessories, and General Area

Blank area for a sketch of the monument and general area.


Location & Comments

Handwritten notes in the Location & Comments section, including a diagonal line across the grid.

Comp. Declin. _____
Agency DOUGLAS CO. SURV. DEPT.
Party Chief LARRY E. MONREAM
Notekeeper Larry E. Mon
Witnesses J.R. LUNDSEN, S.J. FLAUSE

RM 205 JUSTICE BLDG
ROSEBURG, OR 97470

Surveyor's Seal

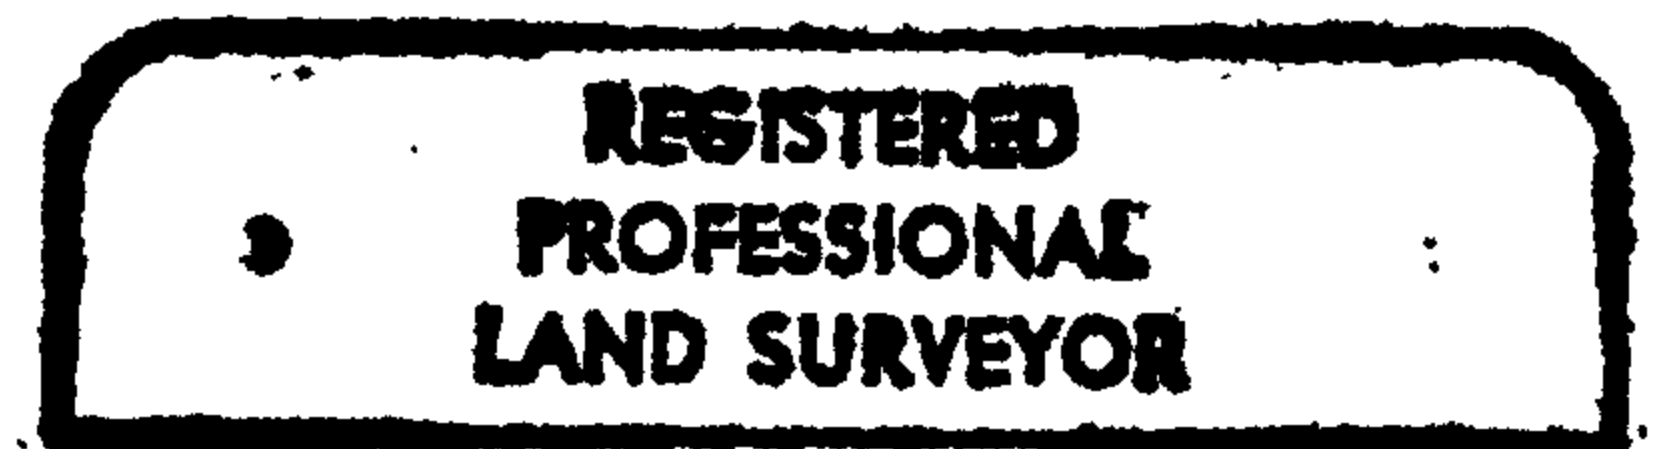

Larry E. Mon

