

GOVERNMENT CORNER RESTORATION FORM

Township 27 S Range 6 W Sec. 33 County DOUGLAS

State OREGON Date MAY 14, 1984 No. _____

Corner Designation

$\frac{1}{4}$ s 33 / s 34

- _____ Condition Report Only
- Not Found
- _____ Renewed
- _____ Unrecorded
- _____ Surveyed In
- _____ Referenced Out

Previous Renewals NONE

Monument(s) Found: (Condition and Source)

NO EVIDENCE OF ORIGINAL CORNER MONUMENT
OR ACCESSORIES FOUND.

Accessories Found:

MONUMENT DETAIL

RENEWAL

Monument Set (Procedure and Description)

Monument Detail

Lined area for Monument Set (Procedure and Description) description, currently blank.

New Accessories

Lined area for New Accessories description, currently blank.

Sketch of Monument, Accessories, and General Area

Large blank area for sketching the monument, accessories, and general area.


Location & Comments

Lined area for Location & Comments, currently blank.

Comp. Declin. _____
Agency DOUGLAS Co. SURVEYORS OFF.
Party Chief L. E. MONREAN
Notekeeper Larry E. Monrean
Witnesses _____

S. J. FLAWE
RM 205 JUSTICE BLDG
ROSEBURG, OR 97470

Surveyor's Seal

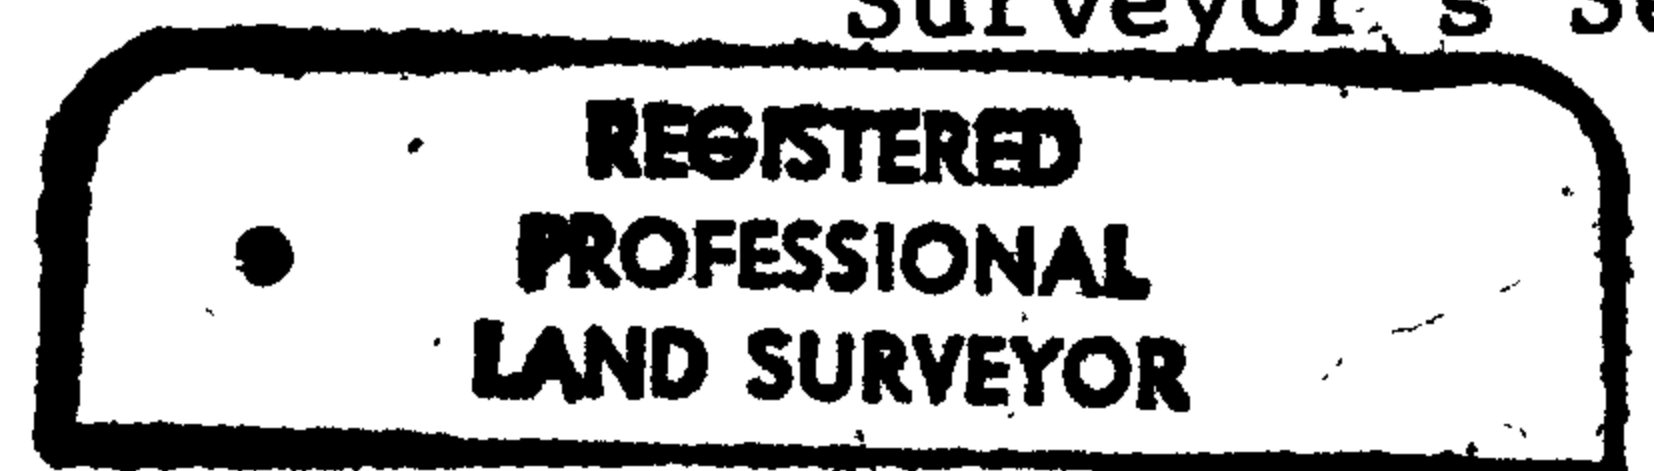

Larry E. Monrean

