

GOVERNMENT CORNER RESTORATION FORM

Township 285 Range 6W Sec. 21 County DOUGLAS

State OR Date 7/26/84 No. _____

Corner Designation

S21 | S22

- Condition Report Only
- Not Found
- Renewed
- Unrecorded
- Surveyed In
- Referenced Out

Previous Renewals #156

Monument(s) Found: (Condition and Source)
A BRASS CAP ON AN I.P. PROTRUDING
FROM A 2 FT DIA. MOUND OF STONE
12 IN. ABOVE GROUND. MARKED AS
NOTED.

T285 R6W

1/4

S21 | S22

1978

Accessories Found:

NO ORIG. EVIDENCE FOUND

1/2" I.P. PER VOL 8 pg 4 USED TO SET 1/4 COR.
PER REN #156 NOT FOUND.

RENEWAL

Monument Set (Procedure and Description)

Monument Detail

NONE

N/A

New Accessories

- A 5/8" I.R. (PER VOL 16 PG 56) BEARS NORTH, 51.29' FT.
- A 5/8" I.R. (PER VOL 16 PG 56) BEARS SOUTH, 8.71' FT.
- A 20" DIA. AT 18" HIGH DOUBLE TRUNKED APPLE TREE BEARS S52°E, 119.9' FT.



THE NW FOUNDATION CORNER OF HOUSE AT 398 JOLE ALLEN CT. WINSTON OR.
 BEARS S23Y4°W, 86.8 FT. (TREE NOT SCRIBED).
 Sketch of Monument, Accessories, and General Area

Location & Comments

CORNER IS APPROX.
 N37°E, 200 FT FROM
 THE CENTER OF CULDESAC
 ON JOLE ALLEN CT. IN
 WINSTON OREGON.

Comp. Declin. 18Y2°E
 Agency DCSO
 Party Chief RANDALL W. SMITH
 Notekeeper Randall W. Smith
 Witnesses STEPHEN J. FLAUSE

Surveyor's Seal

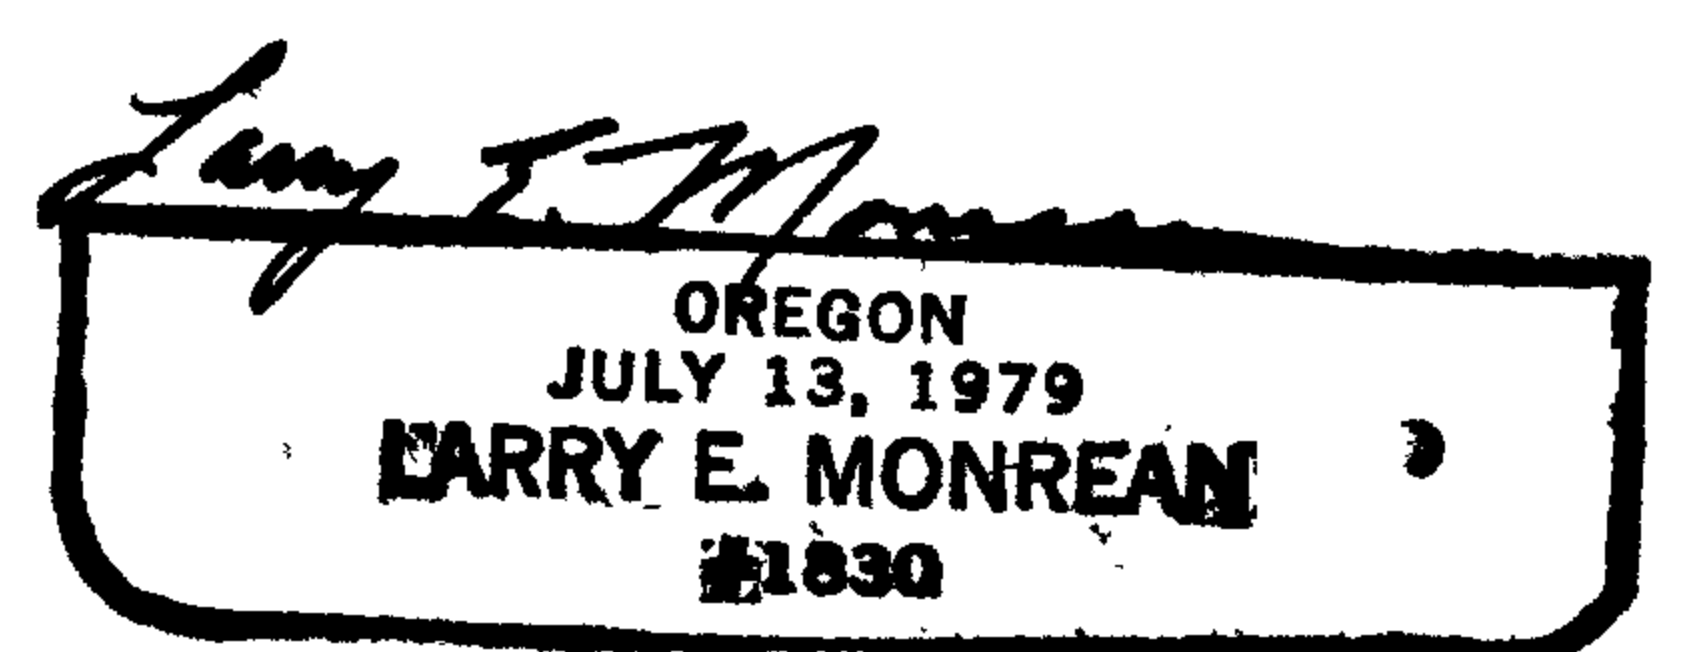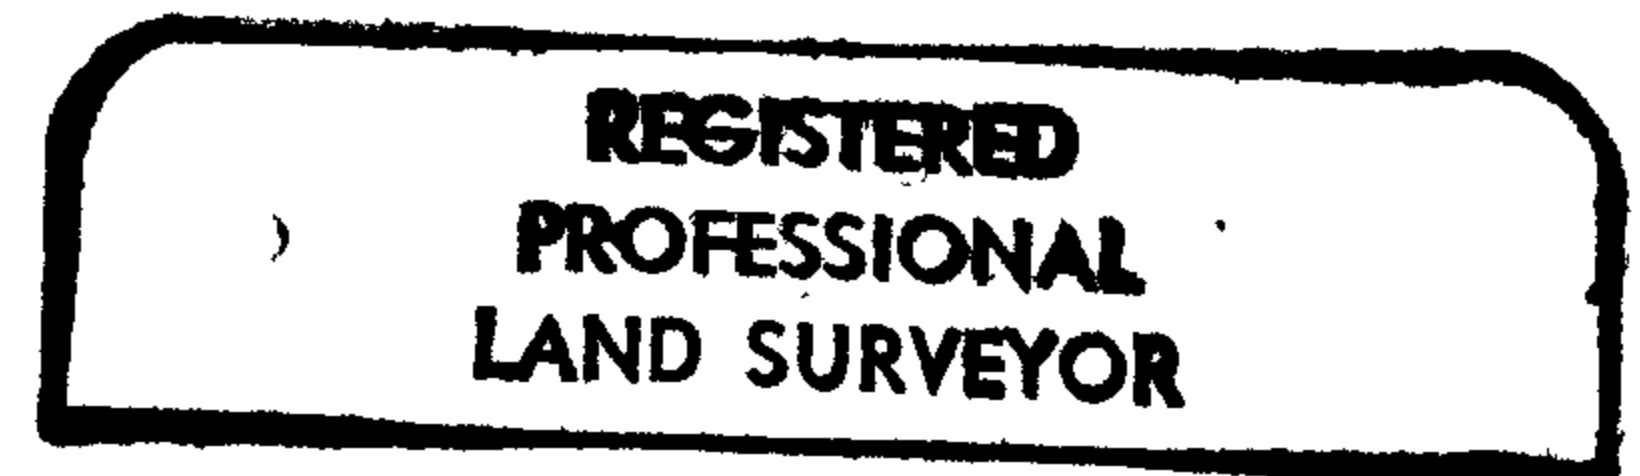

SUKSDORF COOS JUNCTION HILL TRACTS

