

GOVERNMENT CORNER RESTORATION FORM

Township 28S Range 6W Sec. 35 County DOUGLAS

State OR Date 7/20/84 No. _____

Corner Designation

$\frac{1}{4}$ $\frac{S35}{S2}$

- Condition Report Only
- Not Found
- Renewed
- Unrecorded
- Surveyed In
- Referenced Out


Previous Renewals #130 T28-6 #65 T29-6

MONUMENT DETAIL

Monument(s) Found: (Condition and Source)

A 1 3/4 IN. DIA I.P. (REC. 1 1/2 IN. I.P.)
8 IN. NORTH OF ROCK, LEANING 4 IN.
NORTH OF PLUMB, PROTRUDING 12 IN.
ABOVE GROUND (REC 16 IN ABOVE GROUND)
PER REN# 130.

A CONGLOMERATE ROCK FLUSH
WITH GROUND. (PER REN# 130).

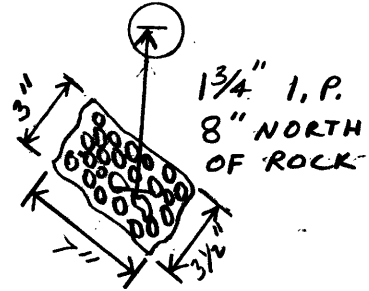

Accessories Found:

FOUND NO ORIGINAL EVIDENCE

A 10" NOW A 17" W. OAK WITH A SINGLE WELL HEALED BLAZE
BEARS N8°E, 57.5 FT.

A 12" NOW A 20" W. OAK WITH A SINGLE WELL HEALED BLAZE
BEARS S34 3/4°E, 66 FT.

