

GOVERNMENT CORNER RESTORATION FORM

Township 19S Range 9W Sec. 34 County DOUGLAS

State OR Date 12/13/84 No. _____

Corner Designation

1/4 S34 | S35

- Condition Report Only
- Not Found
- Renewed
- Unrecorded
- Surveyed In
- Referenced Out


Previous Renewals BLM 1957 DEPENDENT RESURVEY

MONUMENT DETAIL

Monument(s) Found: (Condition and Source)

A BRASS CAP ON A T.I.P.
PROTRUDING 2 IN. ABOVE
GROUND. MARKED AS NOTED
(PER. BLM 1957 RESURVEY)

US CADASTRAL SURVEY

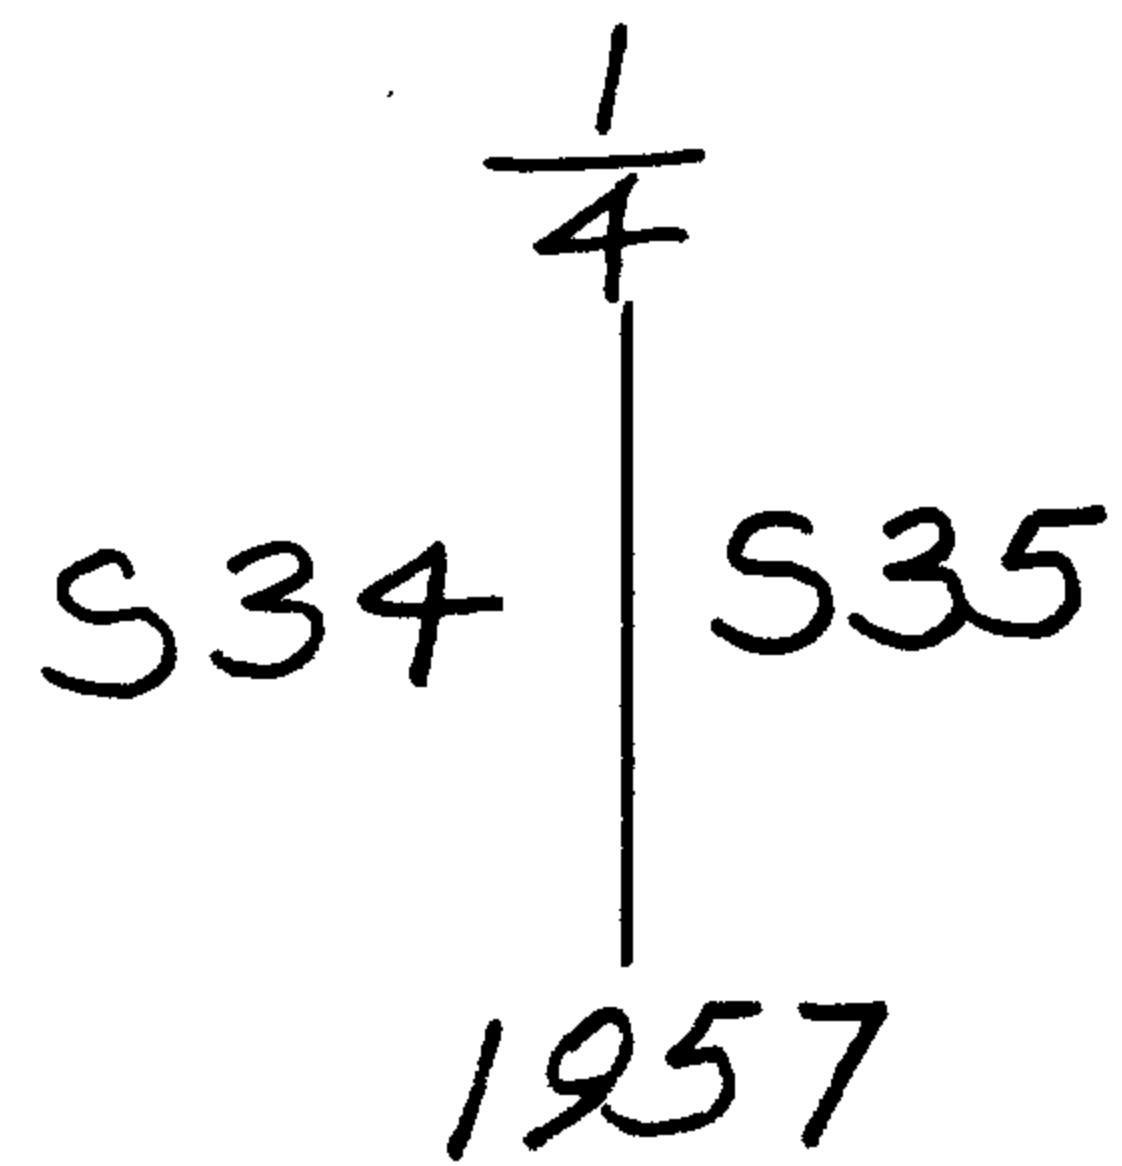

BUREAU OF LAND MANAGEMENT

Accessories Found:

24 IN. NOW A 50" DIA. 3 FT TALL ROTTED CEDAR STUMP, NO MARKS VISIBLE,
BEARS N11°W, 15.4' (REC. N8°W, 15.8') ORIG.

6 IN. NOW A 18" DIA. MAPLE SNAG WITH A PREVIOUSLY OPENED
FACE AND POSSIBLE SCRIBING FOUND, BEARS N45°E, 14.1'
(REC. N59°E, 15.8') ORIG.

13 IN. NOW A 19" TIPPED OUT AND DOWN CEDAR POSSIBLE SCAR
VISIBLE BEARS N13°E, 31.8" TO ROOT WAD. ROOT HOLE LEFT BY
TIPPED OUT TREE BEARS N6°E, 46.1' (REC. N6 3/4°E, 44.2') PER
BLM 1957 RESURVEY.

RENEWAL

Monument Set (Procedure and Description)

Monument Detail

NONE

N/A


New Accessories

3" D. FIR DOUBLE BLAZED AND SCRIBED "X BT" BEARS S 74 3/4° E, 21 1/2' FT

8" ALDER BARK SCRIBED "1/4 S 34 CS BT" BEARS N 70° W, 41 1/2' FT.

(DIAM. 23" ALDER MEASURED AT 2 FT HIGH) BARK SCRIBED "1/4 S 34 CS BT" BEARS S 82 1/2° W, 32 1/2' FT.

Sketch of Monument, Accessories, and General Area

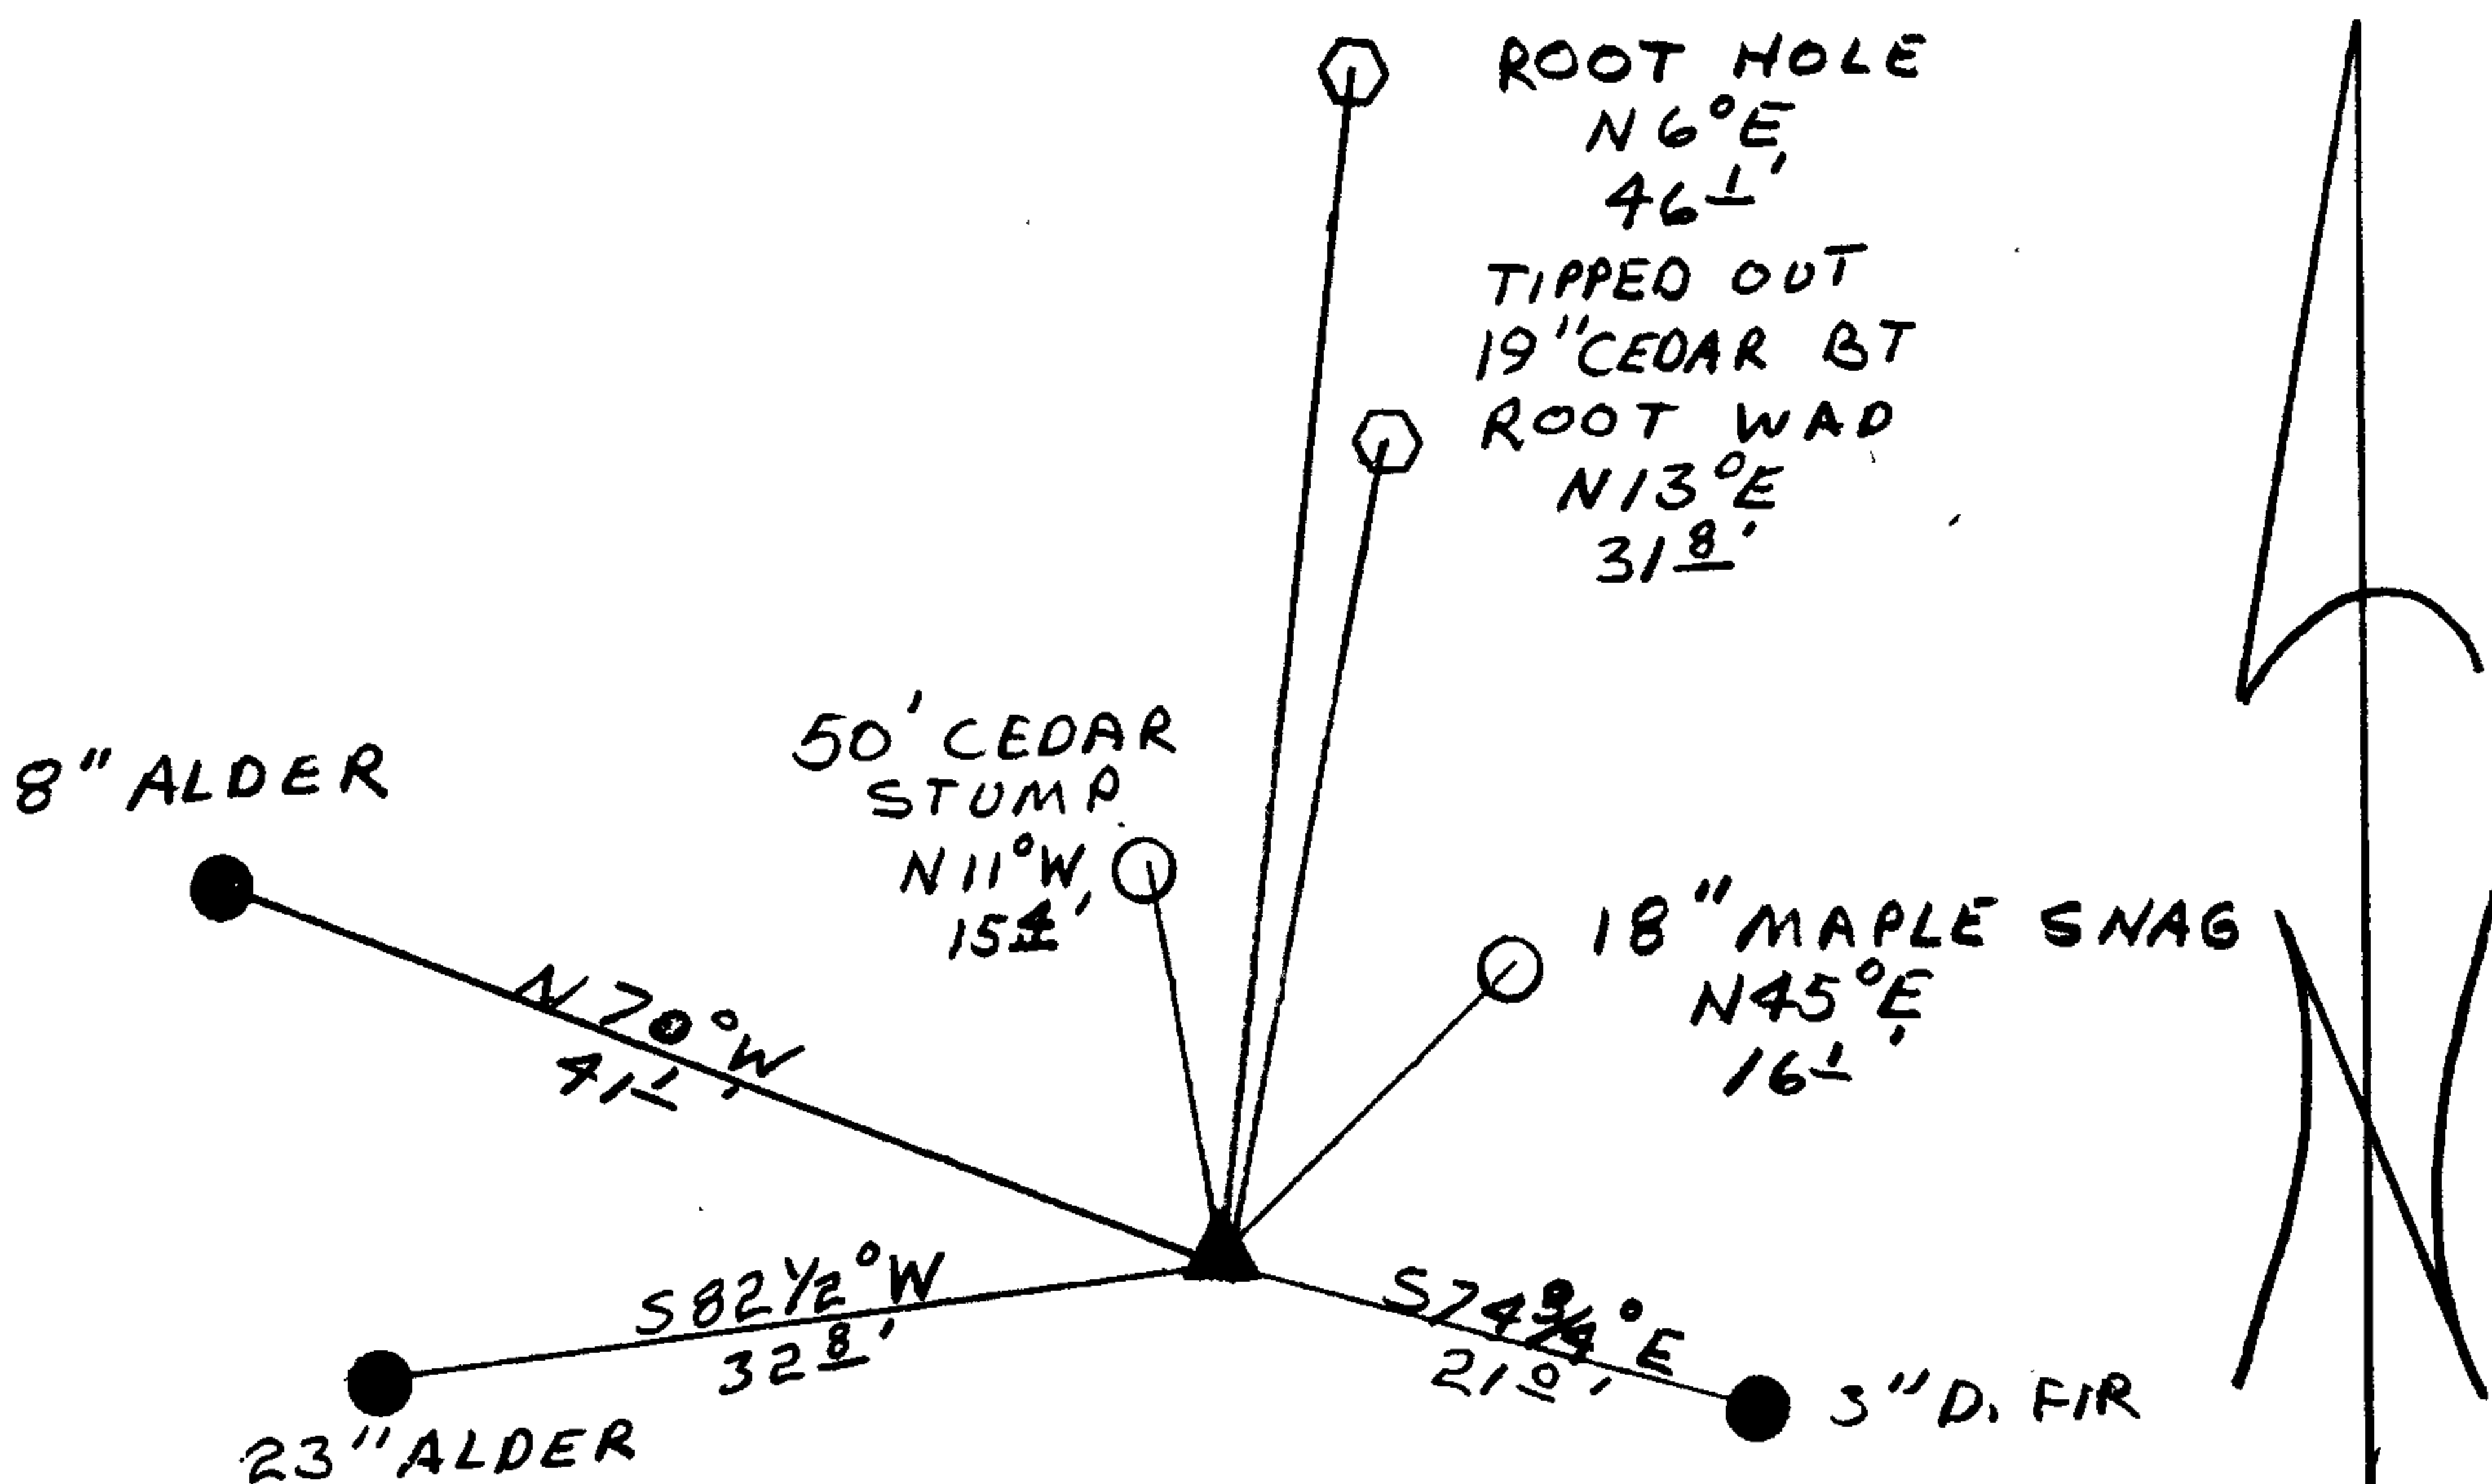

- ▲ BRASS CAP
- NEW BT
- BT FROM BLM 1957 RESURVEY
- ORIG. BT

Location & Comments

CORNER LIES APPROX 160' NORTH OF A SMALL CREEK AND ON A STEEP SOUTH SLOPE

MONUMENT WAS ACCEPTED AS CORNER, INTERSECTION OF DISTANCES FROM CAP TO BT'S ARE NEAR ORIG. DISTANCES.

Comp. Declin. 18 3/4° E
Agency DCSO
Party Chief RANDALL W. SMITH
Notekeeper [Signature]
Witnesses STEPHEN J. FLAUSÉ

Surveyor's Seal

REGISTERED PROFESSIONAL LAND SURVEYOR

[Signature]

OREGON
JULY 13, 1979
LARRY E. MONREAN
#1830