

GOVERNMENT CORNER RESTORATION FORM

Township 20S Range 10W Sec. 6 County DOUGLAS

State OREGON Date SEPTEMBER 18, 1984 No. \_\_\_\_\_

Corner Designation

T20S R10W

56	CC
57	

Condition Report Only  
 Not Found  
 Renewed  
 Unrecorded  
 Surveyed In  
 Referenced Out

Previous Renewals T-20-10 #48, 84 T-20-11 #161-101

MONUMENT DETAIL

Monument(s) Found: (Condition and Source)

A U.S.F.S., 3 1/4 INCH DIAM. ALUMINIUM CAP ON AN IRON PIPE, MONUMENT, MARKED AS AT RIGHT. MONUMENT IS IN AN APPROX 3 FT DIAM MOUND OF STONE RISING 8 TO 10 INCHES ABOVE THE SURROUNDING GROUND. THE ORIGINAL STONE FOUND AT THIS CORNER LOCATION AS NOTED IN RENEWAL # 84 HAS BEEN REMOVED BY THE U.S.F.S. SEE CS. FILE 62/19.

U.S.D.A. FOREST SERVICE

T20S

R11W

R10W

S12	56	CC
	57	

UNLAWFUL TO DISTURB

Accessories Found:

TWO BEARING TREES ORIGINALLY MARKED BY PROCHNAU FOR THE PROPORTIONED IN CORNER (SEE RENEWAL # 48) NOW ARE ACCESSORIES FOR THE ORIGINAL CORNER FOUND IN RENEWAL # 84:

A 17 INCH FIR NOW A 19 INCH D.B.H. DOUGLAS FIR BEARS N57°E, 95.8 FT. (RECORD N60°E, 95.8 FT.) THIS TREE HAS A HEALED SINGLE BLAZE WITH NO SCRIBING VISIBLE; AND A 20 INCH FIR SNAG, NOW AN UPROOTED AND FALLEN DOUGLAS FIR SNAG WHOSE STUMP HOLE BEARS S76 1/2°E, 56.6 FT. (RECORD S72°E, 56.6 FT.) THIS TREE SHOWS EVIDENCE OF A POSSIBLE BLAZE NEAR UNDERSIDE OF TRUNK.

FROM RENEWAL # 84 THE FOLLOW ACCESSORIES:

A 34 INCH FIR NOW A 36 INCH D.B.H. DOUGLAS FIR BEARS N76 1/2°E, 92.5 FT. (RECORD N79 1/2°E, 92.5 FT.) THIS TREE HAS PARTIALLY HEALED DOUBLE BLAZE WITH THE SCRIBING T20S R10W CC 56 BT VISIBLE; AND A 20 INCH ALDER NOW A 21 INCH D.B.H. ALDER BEARS S99 1/2°E, 12.0 FT. (RECORD S95 1/2°E, 12.0 FT.) THIS TREE HAS HEALED BARK SCRIBING WHICH READS T20S R10W CC 57 BT; ALSO THE PROPORTIONED IN

CORNER SET BY PROCHNAU, A 2 1/2 INCH DIAMETER BRONZE CAP ON A 2 INCH DIAM. IRON PIPE MARKED T20S FIRMLY SET AND PROTRUDING 1.1 FT FROM GROUND BEARS N49°E, 23.6 FT (RECORD N51°33'26"E 23.58 FT)

S12	56	CC
	57	

1971

4185

C.S. File No. 62/21-2

RENEWAL

Monument Set (Procedure and Description)

Monument Detail


NA

NONE

New Accessories

NONE

Sketch of Monument, Accessories, and General Area

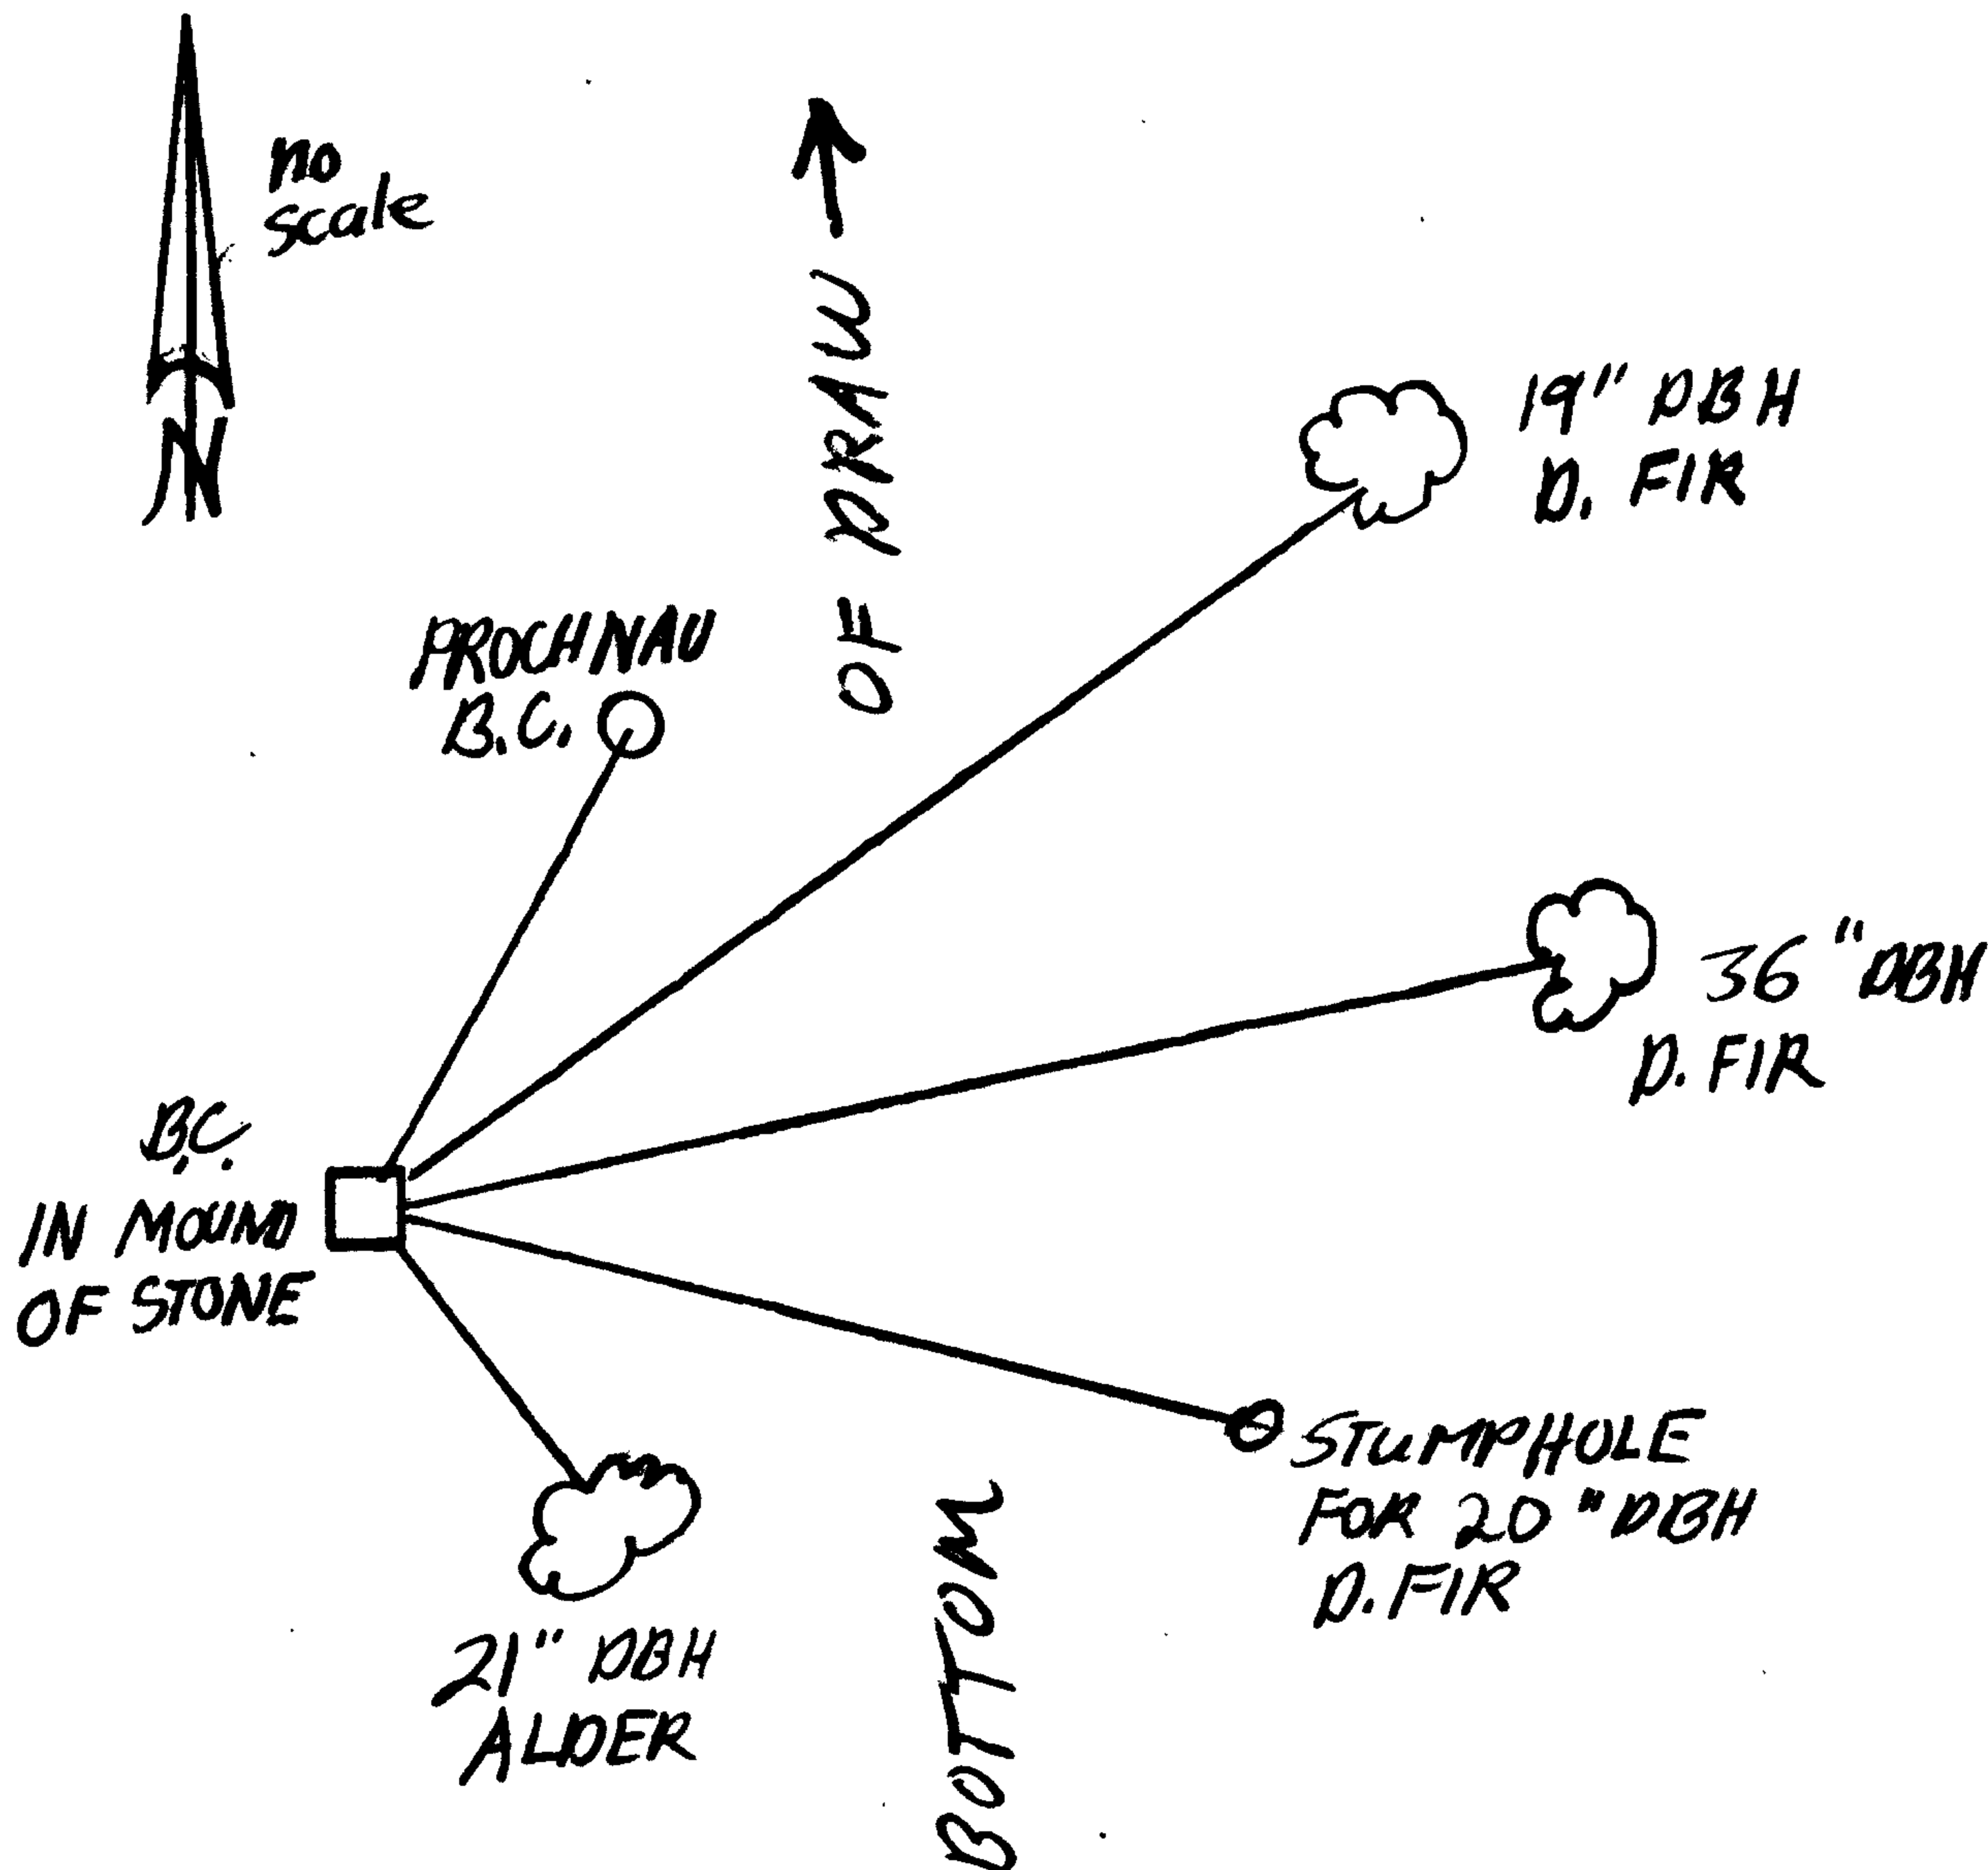

Location & Comments

CORNER IS LOCATED ON THE WEST SIDE OF A SHALLOW DRAW RUNNING NORTH-SOUTH; DRAW IS ON A VERY STEEP NORTH FACING SLOPE.

Comp. Declin. 18 3/4° E  
Agency DCSO  
Party Chief RANDY SMITH  
Notekeeper Stephen John House  
Witnesses S.J. FLAUS

Surveyor's Seal

REGISTERED  
PROFESSIONAL  
LAND SURVEYOR

*Larry E. Monrean*

OREGON  
JULY 13, 1979  
LARRY E. MONREAN  
#1830