

GOVERNMENT CORNER RESTORATION FORM

Township 21 S Range 7 W Sec. 23 County DOUGLAS

State OREGON Date 12-20-84 No. _____

Corner Designation

$\frac{1}{4}$ $\frac{S 23}{S 26}$

- _____ Condition Report Only
- _____ Not Found
- Renewed
- _____ Unrecorded
- _____ Surveyed In
- _____ Referenced Out

Previous Renewals # 49 E 51

Monument(s) Found: (Condition and Source)

ORIGINAL STONE AND POST NOT FOUND

FOUND "T" IRON WITH BRASS WASHER
SET BY HAINES RENEWAL NUMBER 48 E 51

MONUMENT DETAIL

N/A

Accessories Found:

ORIGINAL BT'S

"BT 14" $\frac{1}{4}$ "


40" FIR NOW A SNAG WITH BARK SCRIBING "BT" VISIBLE
BEARS S $1\frac{1}{2}$ ° W 37.9 FEET (SLOPE DIST. 45² FEET AT 34°) RECORD BEARING
AND DISTANCE SOUTH 42.2 FEET.

A 12" NOW 23" DIAMETER MAPLE WITH WELL HEALED BLAZE AND HAINES
WASHER BEARS N 14° E 22.4 FEET (RECORD 24.4 FEET) LEVEL CHANGED

HAINES BT'S. FOUND

A 12" FIR NOW A DECAYED AND DISLODGED STUMP WITH HAINES
WASHER AND SCRIBING "BT" VISIBLE CHECKS WELL WITH RECORD
S 37° W 10.0 FEET

A 20" FIR NOW A 28" STUMP 2 FEET HIGH WITH SINGLE AXE
MARK VISIBLE BEARS N 11° W 58.8 FEET.

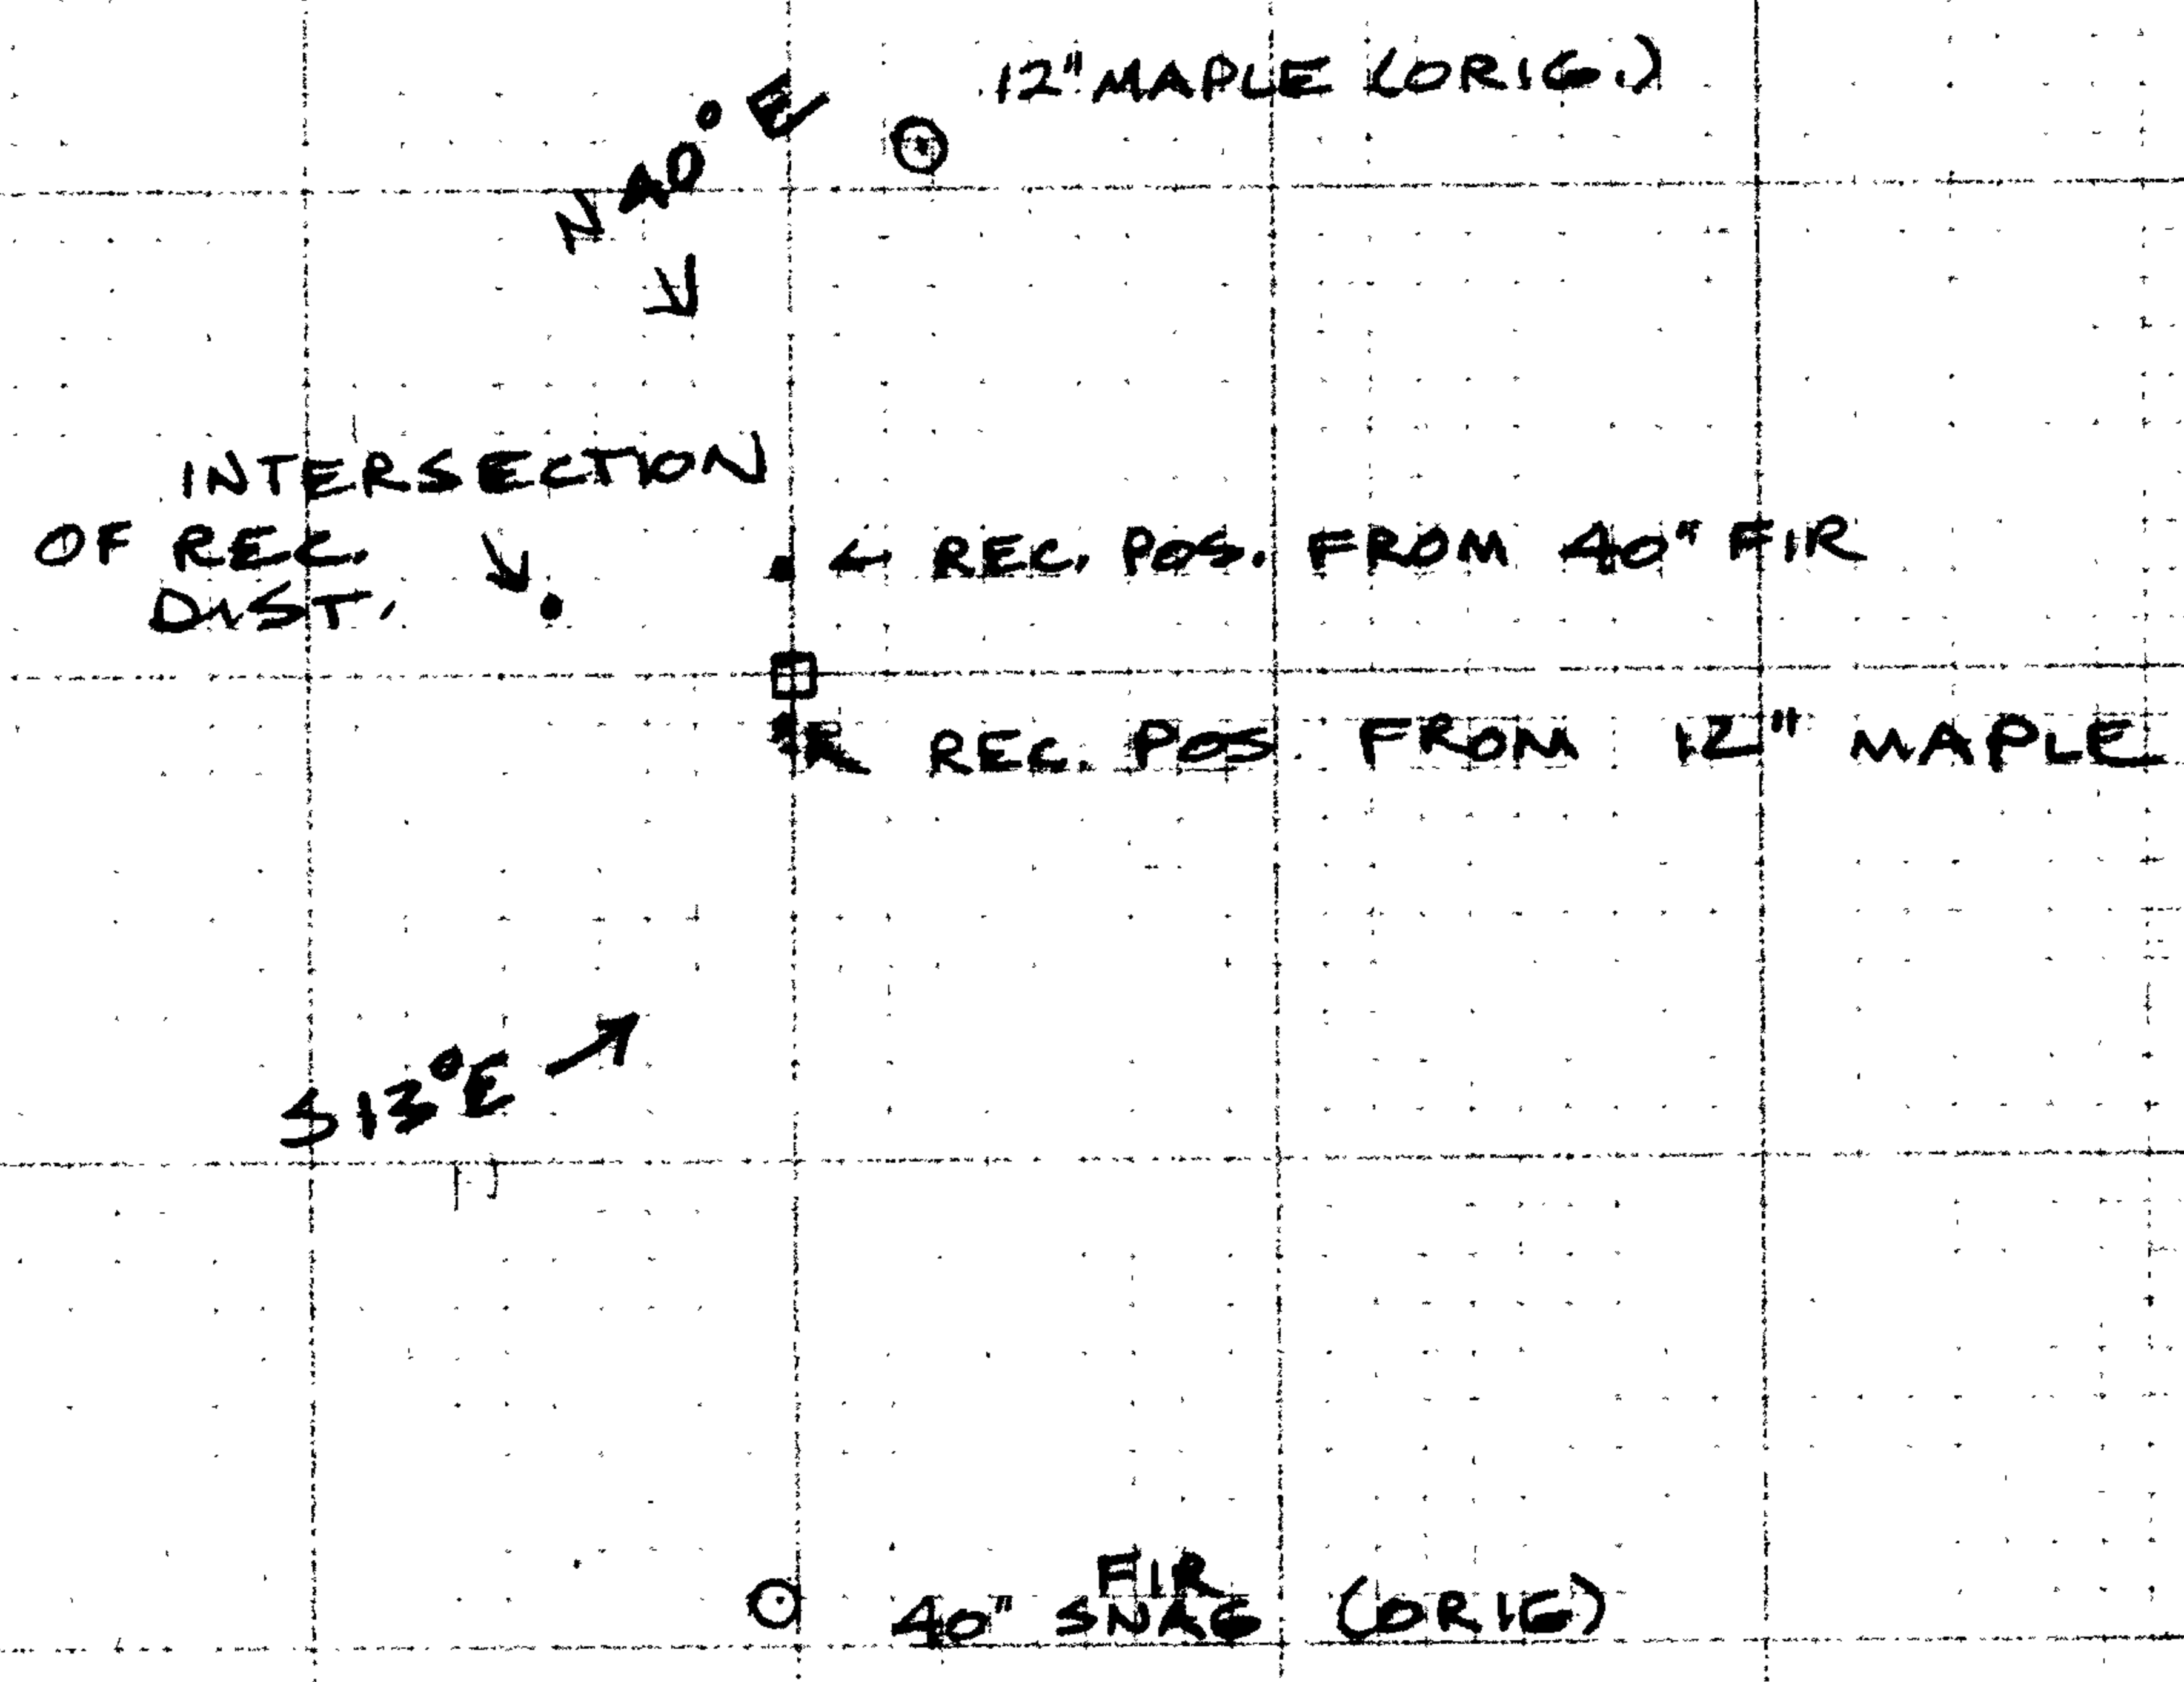

NOTE: HAINES' POSITION IS AT THE INTERSECTION OF RECORD BEARINGS

CS 62/21-4