

OREGON CORNER RESTORATION FORM

Section 33 Township 24 S Range 1 E

County LANE - DOUGLAS Date 7-21-84

Corner Designation

S33 | S34

- Condition Report Only
- Not Found
- Renewed
- Unrecorded
- Surveyed In
- Referenced Out

Previous Renewals/Surveys, etc. ORIG. SURVEY 1896, 1978 SURVEY AND 1978 RESURVEY.

Monument(s) & Accessories Found: (Condition and Source)

ORIGINAL STONE MONUMENT SEARCHED FOR AND NOT FOUND. ORIGINAL 12" NOW 19" FIR BEARS N 14° E 15 1/2 FT. WE OPENED A PORTION OF WELL HEALED BLAZE AND FOUND A SCRIBED "4" AT THE PROPER GROWTH RING COUNT. A 13" NOW 19" FIR BEARS S 31 1/2° E 20 1/2 FT (REC. 35 1/2 FT). FOUND FRAGMENTARY SCRIBE MARKS IN THE PREVIOUSLY OPENED AND CALIBERATED BLAZE. A 14" NOW 28" FIR BEARS S 11 1/2° W 13 1/2 FEET (REC. S 8° W). TREE HAS WELL HEALED, OVERLAPPING BLAZES. THE ORIGINAL B" MADEPNE BT NOT FOUND. CC 53
1 54 T 53 BEARS N 89 1/4° E 86 1/2 FT (REC. N 89 3/4° E 84 1/2 FT)

Monument Detail SET BRASS CAP IS MARKED

Sketch


" DOUGLAS CO. SURVEYOR "

T 24 S

R S33 | S34

E 54

T 25 S

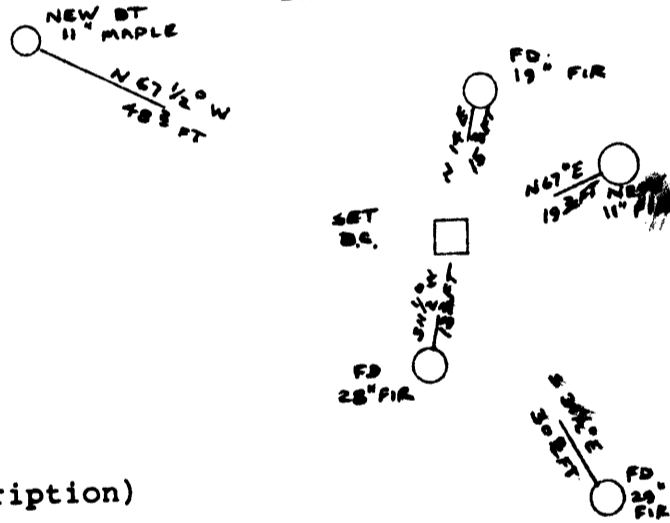

Monument Set (Procedures and Description)

AT THE LOCATION DETERMINED BY HOLDING THE RECORDED BEARING AND DISTANCE (N 14° E 15 1/2 FT) TO THE N.E. BT AND CORROBORATED WITH THE NOTED MEASUREMENTS WE CHISEL A 2" + INTO THE BEDROCK 6" BELOW GROUND SURFACE. OVER THIS POINT WE SET A 1" X 30" IRON PIPE WITH BRASS CAP IN MOUND OF STONE AND EARTH. CORNER LIES ON A STEEP SSE SLOPE.

New Accessories

AN 11" DIAM. PISTOL BUT D. FIR BEARS N 67° E 19 1/2 FT TO STR. OF ROOT CROWN IS DOUBLE BLAZED AND SCRIBED "T 24 S R 1 E S 34 CS BT".

AN 11" DIAM. MAPLE SCRIBED "T 24 S R 1 E S 33 CS BT" ON A DOUBLE BLAZE BEARS N 67 1/2° W 48 1/2 FEET TO CENTER OF ROOT CROWN.

Location & Comments

NOT OF RECORD

A TAGGED 28" DIA. FIR SNAG BEARS N 80° W 24 1/2 FT.

A TAGGED 28" DIA. FIR BEARS S 69° E 42 1/2 FT.

Compass Declination 18 1/2° E

Firm/Agency DOUGLAS COUNTY SURVEYOR'S OFFICE

Address 305 JUSTICE BLDG. ROSSBURG, OR 97470

Party Chief LARRY E. MONREAN

Notes L. E. MONREAN

Witness J. LUNDEN, R. W. SMITH, S. J. FIAUSE

Surveyor's Seal

REGISTERED PROFESSIONAL LAND SURVEYOR

Larry E. Monrean
 OREGON
 JULY 13, 1979
 LARRY E. MONREAN
 #1820

#7 T24-1E ✓
 #47 T25-1E X

C.S. FILE 62/217 C