

GOVERNMENT CORNER RESTORATION FORM

Township 26 S Range 7 W Sec. 3 County DOUGLAS

State OREGON Date 8-17-84 No. _____

Corner Designation

54	53
59	510

- _____ Condition Report Only
- _____ Not Found
- Renewed
- _____ Unrecorded
- _____ Surveyed In
- _____ Referenced Out

Previous Renewals # 37 (1959) & 1967 DEPENDENT RES.

Monument(s) Found: (Condition and Source)

ORIGINAL POST NOT FOUND
 FOUND PER RENEWAL #37 A 1" IRON PIPE WITH
 BRASS CAP MARKED AS NOTED AT CORNER
 POSITION.

MONUMENT DETAIL

COUNTY SURVEYOR'S OFFICE
T 26 S R 7 W

54	53
59	510

1959

Accessories Found:

1. REMAINS OF ROOTS AT RECORD BEARING AND DISTANCE TO ORIGINAL 6" HEMLOCK S 25° E 205 FEET. NO OTHER ORIGINAL EVIDENCE FOUND.
BT'S PER BYRON RENEWAL #37
2. A 14" NOW 22" FIR WITH WELL HEALED DOUBLE BLAZE BEARS N 39 1/2° E 27 1/2 FT (REL PER. BLM N 41° E 20° FEET) THIS TREE TO BE COMPLETELY REMOVED IN PASTURE CLEARING.
3. 6" FIR AT RECORD N 65° W 30° FEET IS DEAD AND DOWN
4. 12" W. FIR NOW A 10" SNAG WITH "T 26 S R 7 W S 9 CS BT" SCRIBED ON PARTLY HEALED BLAZE BEARS S 60° W 31° FEET (BLM REC. 31° FEET, REN 37 CALLS 31° CHECKS WELL TO CENTER OF TRUNK AT TOP OF BLAZE).
BLM BT
5. A FIR 10 NOW 16" DIA. BEARS S 62 1/2° E 177 1/2 FEET. HAS A WELL HEALED SINGLE BLAZE

RENEWAL

Monument Detail


Monument Set (Procedure and Description)

WE RESET THE NOTED FOUND BRASS CAP
 AT CORNER POSITION, THE MONUMENT NOW
 PROTRUDES 5" ABOVE GROUND LEVEL

New Accessories

16" W. FIR DOUBLE BLAZED AND SCRIBED "T26SR7W S3 CS BT" BEARS N 58 1/2° E 140° FEET.
 14" W. FIR DOUBLE BLAZED AND SCRIBED "T26SR7W S9 CS BT" BEARS S 61 1/2° W 33° FEET.
 14" D. FIR DOUBLE BLAZED AND SCRIBED "T26SR7W S9 CS BT" BEARS S 26° W 28° FEET.

28.2 Sketch of Monument, Accessories, and General Area

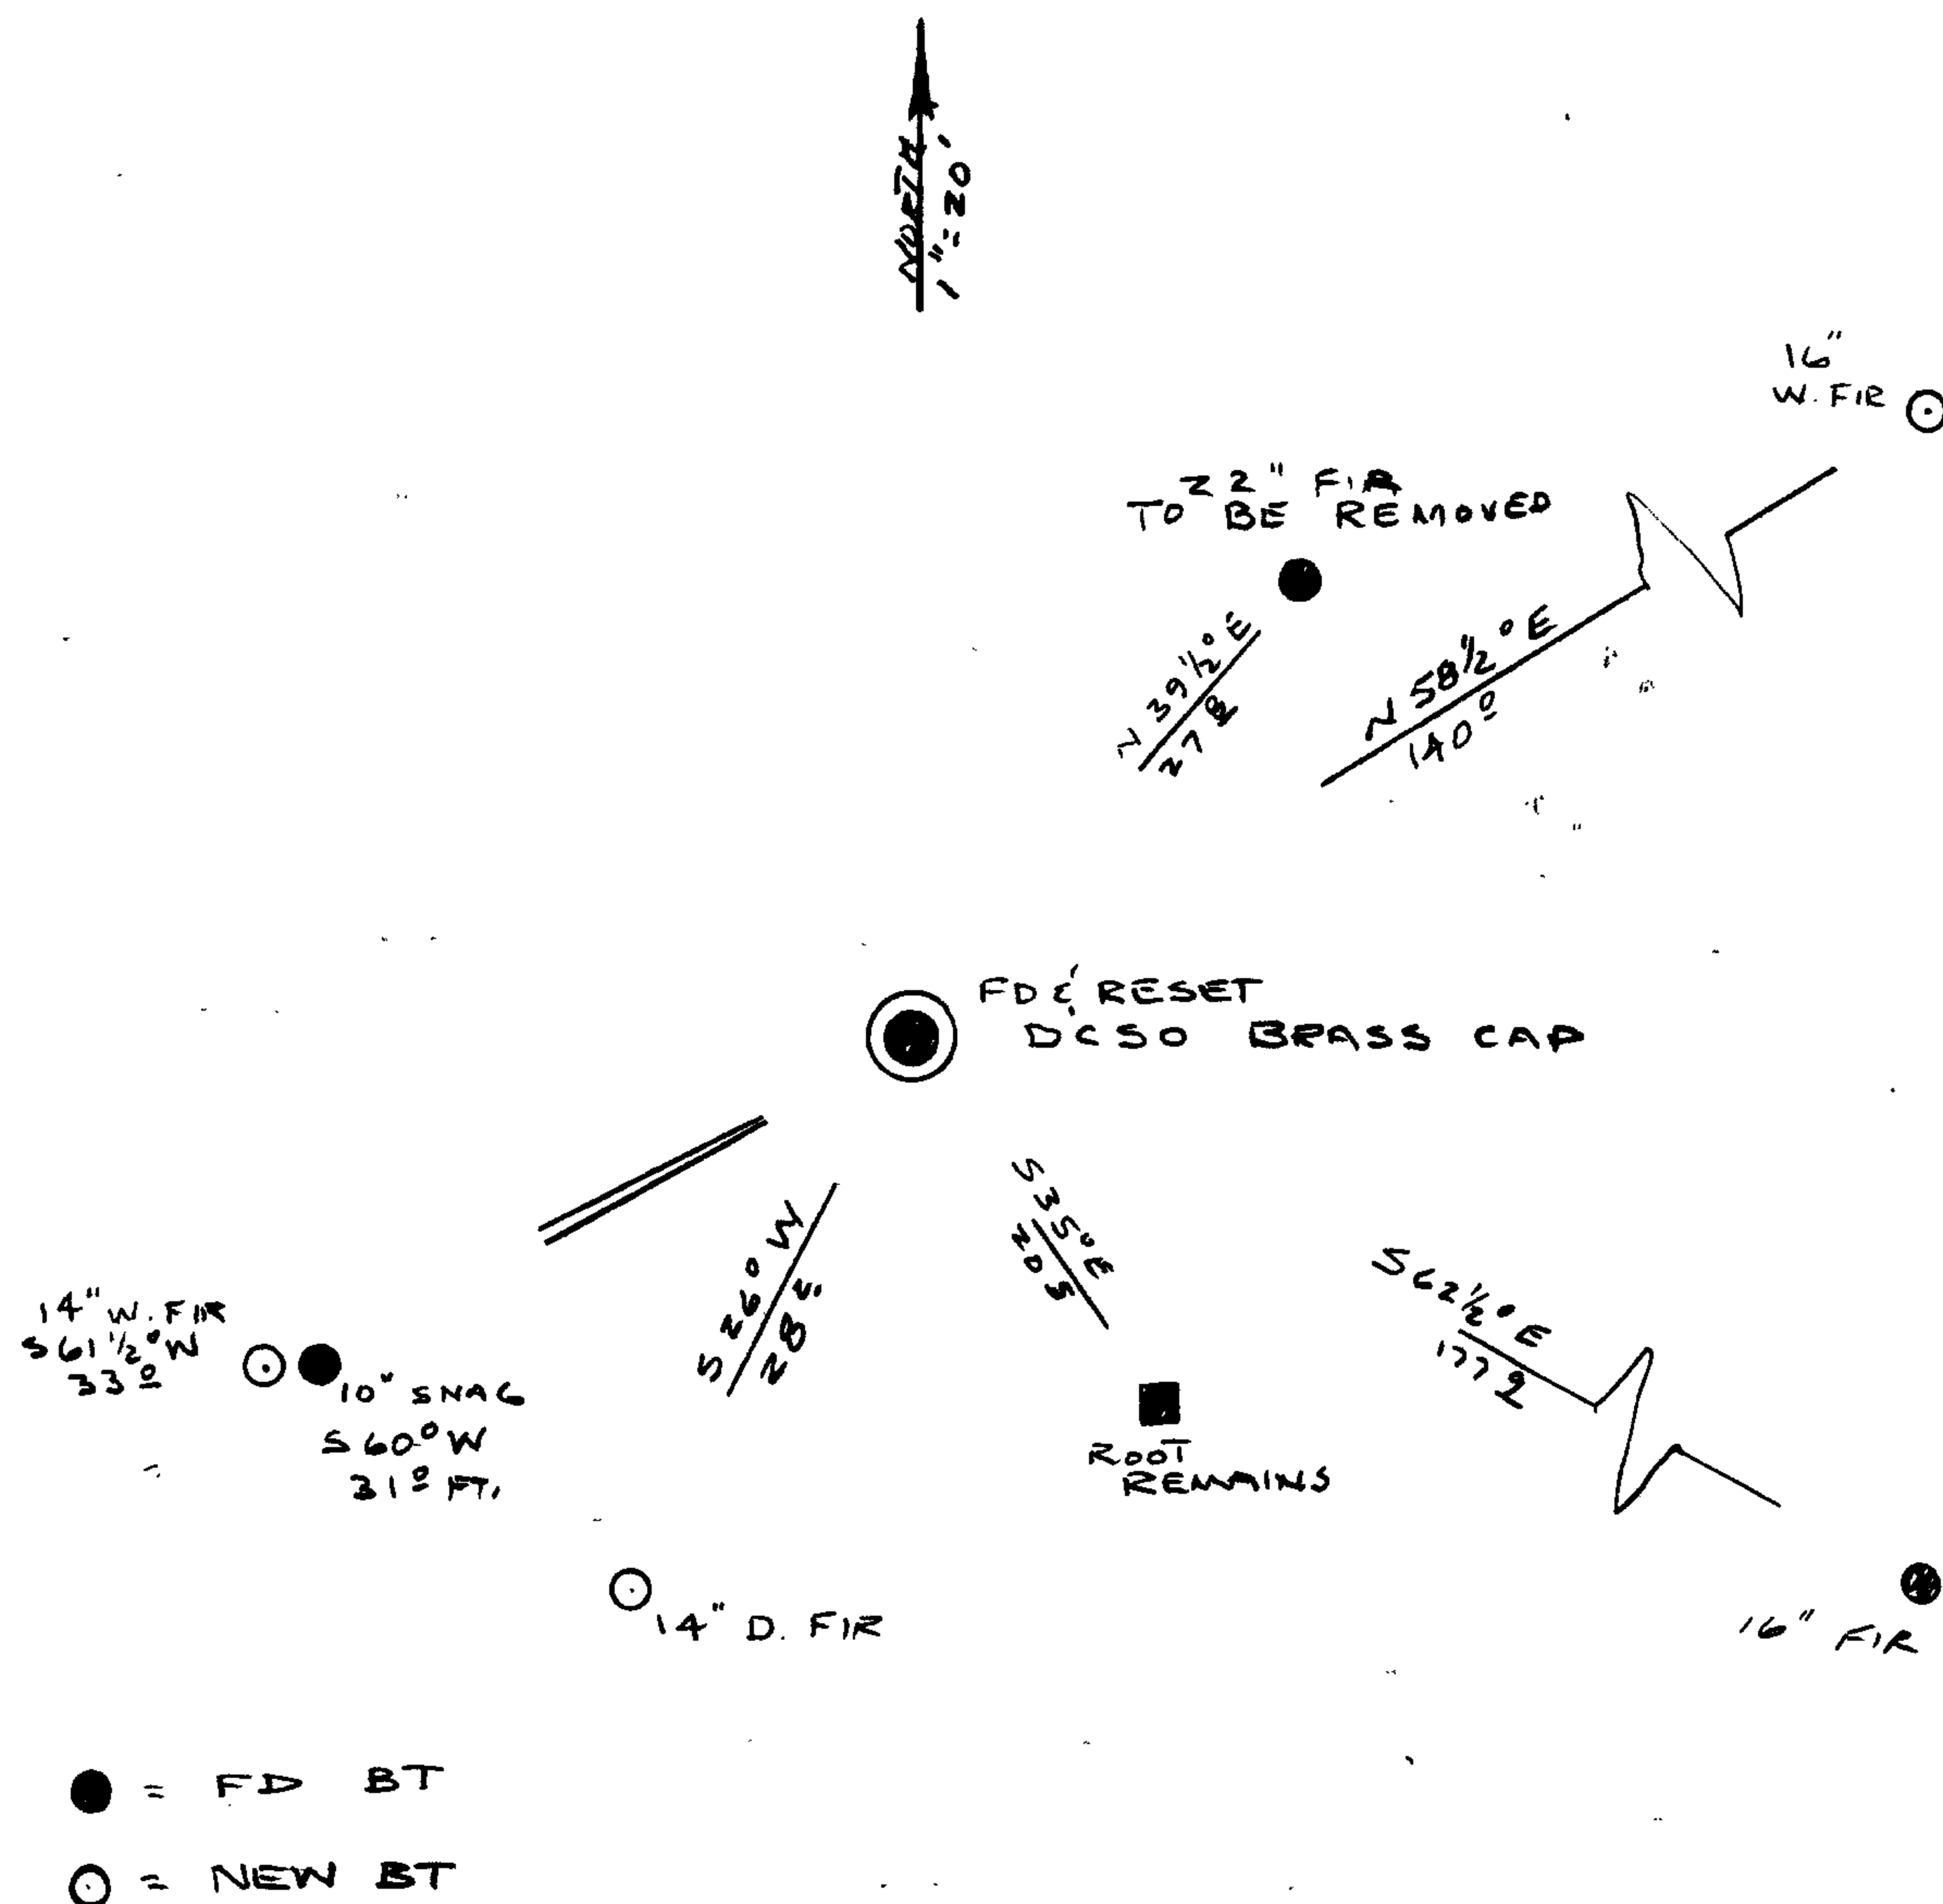

Location & Comments

CLEARING FOR PROPOSED PASTURE
 IS IN PROGRESS. FENCES ARE TO
 RUN NORTH, WEST, AND SOUTH
 FROM CORNER WHEN CLEARING IS
 COMPLETED, 72' EAST TO DIRT ROAD

Comp. Declin. 19° EAST
 Agency DOUGLAS CO. SURVEYOR'S OFFICE
 Party Chief LARRY E. MONREAN
 Notekeeper " " "
 Witnesses R.W. SMITH
 S.J. FLAUSE

Surveyor's Seal

REGISTERED
 PROFESSIONAL
 LAND SURVEYOR

Larry E. Monrean

OREGON
 JULY 13, 1979
 LARRY E. MONREAN
 #1830