

RENEWAL

Monument Set (Procedure and Description)

Monument Detail

NONE

N/A


New Accessories

A 9 INCH D.B.H. W. FIR BEARS $S5\frac{1}{2}^{\circ}E$, 64.2 FT DIST. SCRIBED "T285, RBW, S12, CS, BT" ON A DOUBLE BLAZE.

AN 8 INCH D.B.H. W. FIR BEARS $N50^{\circ}W$, 24.7 FT DIST. SCRIBED "T285, RBW, S2, CS, BT" ON A DOUBLE BLAZE.


TAGS ON FOUND ACCESSORIES ARE ALTERED TO SHOW MEASUREMENTS FROM THE RENEWAL

Sketch of Monument, Accessories, and General Area

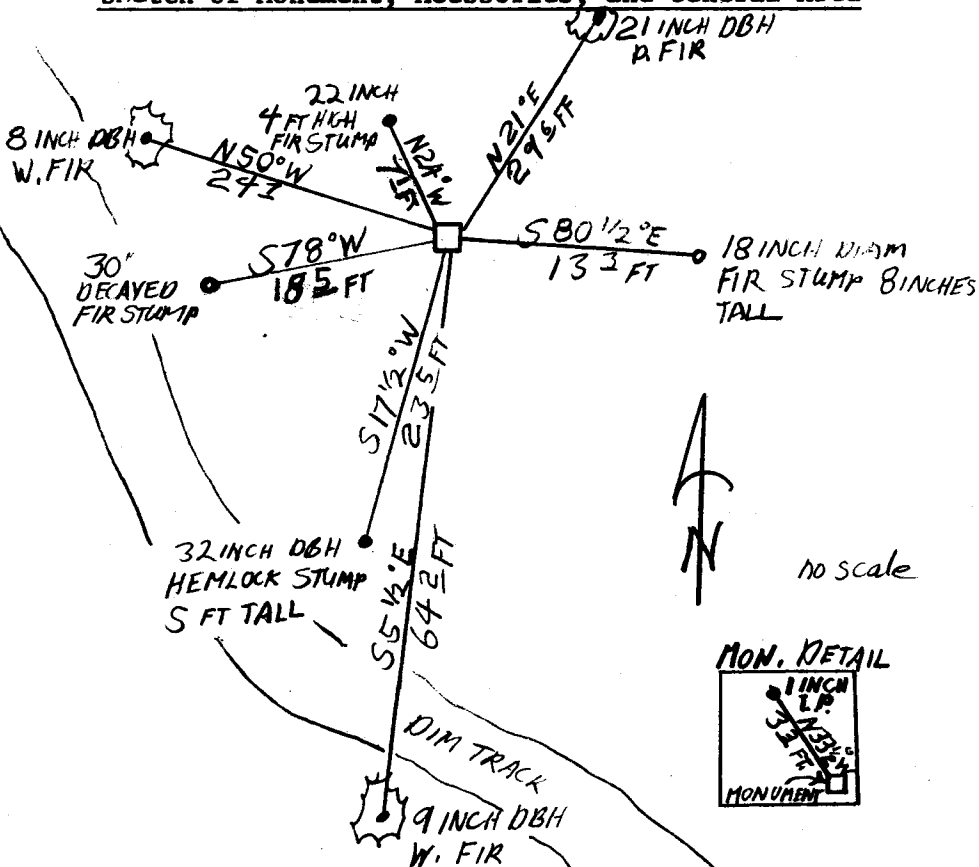

Location & Comments

Comp. Declin. $18\frac{1}{2}^{\circ}E$
 Agency DCSO
 Party Chief S.J. FLAISE
 Notekeeper Stephen John Flaise
 Witnesses R.W. SMITH

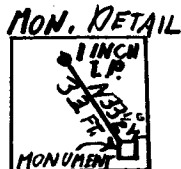

Surveyor's Seal

REGISTERED
 PROFESSIONAL
 LAND SURVEYOR

Larry E. Monrean

OREGON
 JULY 13, 1979
 LARRY E. MONREAN
 #1830