

GOVERNMENT CORNER RESTORATION FORM

Township 28S Range 8W Sec. 7 County DOUGLAS

State OREGON Date AUGUST 9, 1984 No. _____

Corner Designation

57 | 58

518 | 517

- _____ Condition Report Only
- _____ Not Found
- Renewed
- _____ Unrecorded
- _____ Surveyed In
- _____ Referenced Out

Previous Renewals BLM DEPENDENT RESURVEY 1972

Monument(s) Found: (Condition and Source)

A BLM DISK ON AN IRON PIPE FIRMLY SET AND PROTRUDING 4 INCHES ABOVE GROUND. FROM 1972 DEPENDENT RESURVEY. MARKED AS NOTED AT RIGHT.

MONUMENT DETAIL

U.S. DEPT. OF INTERIOR
BUR. OF LAND MANAGEMENT

T28S R8W

57 | 58

518 | 517

1972

Accessories Found:

NO EVIDENCE OF ORIGINAL BEARING TREES FOUND. FROM DEPENDENT RESURVEY FOUR BEARING TREES FOUND.

A D. FIR 16 INCH D.B.H. BEARS N 37° E, 35.1 FT. DIST. (RECORD: A FIR 15 IN. DIAM. BEARS N 37° E, 54 LKS. (SLOPE DIST. TO CAP), HAS HEALED SINGLE BLAZE, NO SCRIBING VISIBLE.

AN 8 INCH FIR NOW A 9 INCH D.B.H. D. FIR, BEARS S 62° E, 27.7 FT DIST. (AS PER RECORD) TREE HAS HEALED SINGLE BLAZE, NO SCRIBING VISIBLE.

AN 18 IN. FIR NOW A 20 INCH D.B.H. D. FIR, BEARS S 17° W, 25.7 FT. DIST. (AS PER RECORD) TREE HAS HEALED SINGLE BLAZE, NO SCRIBING VISIBLE.

AN 18 IN. FIR NOW A 20 INCH D.B.H. D. FIR, BEARS N 40° W, 9.9 FT. DIST. (AS PER RECORD) TREE HAS HEALED SINGLE BLAZE. NO SCRIBING VISIBLE.

TREES ARE ALL PROPERLY TAGGED EXCEPT AS NOTED IN NEW ACCESSORIES

#177 X

C.S. File No. 62/21-37

RENEWAL

Monument Set (Procedure and Description)

Monument Detail


(NONE)

N/A

New Accessories

TAG ON NE BT ALTERED; DISTANCE CHANGED TO 35.1 FT TO INDICATE HORIZONTAL DISTANCE BETWEEN CAP AND CENTER OF BT ROOT CROWN. ADDED INITIALS DCSD TO TAG

Sketch of Monument, Accessories, and General Area

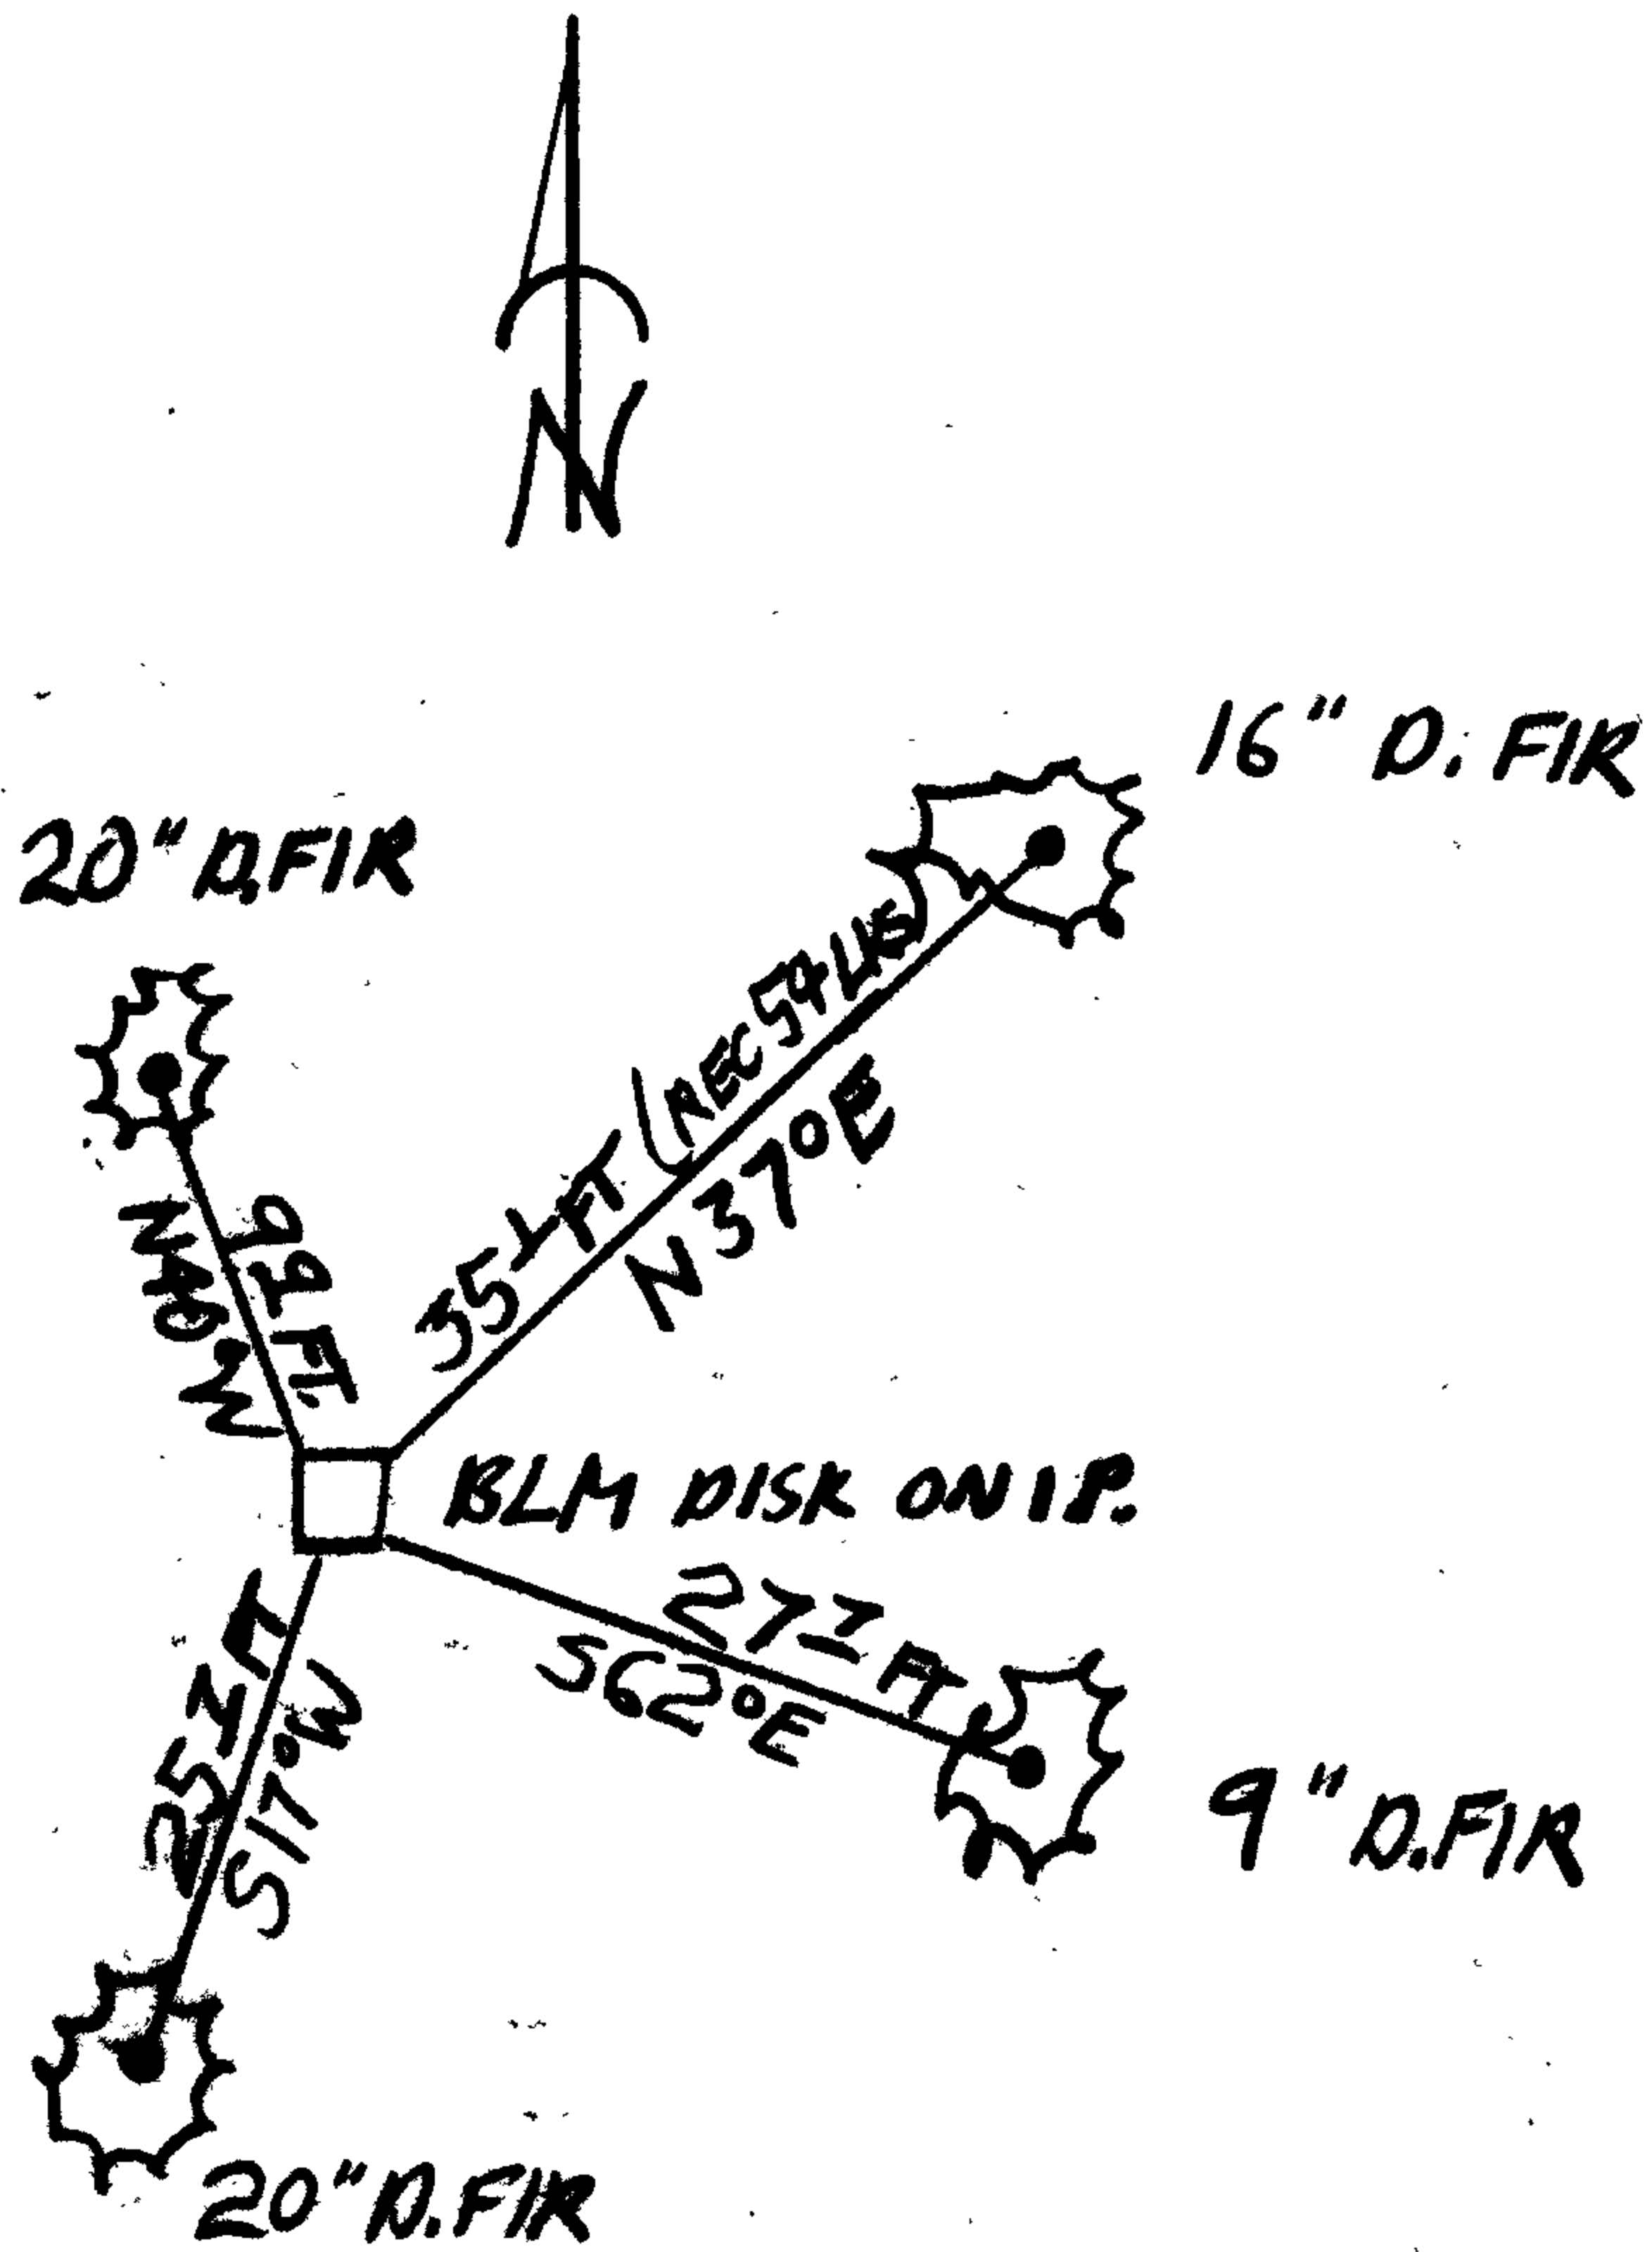


Location & Comments

MONUMENT LIES DOWN STEEP SOUTH SLOPE APPROX. 250 FT HORIZ. DIST FROM MLM RD 28-8-20

Comp. Declin. 18 1/2° E
Agency DCSD
Party Chief S J FLAISE
Notekeeper [Signature]
Witnesses R.W. SMITH

Surveyor's Seal

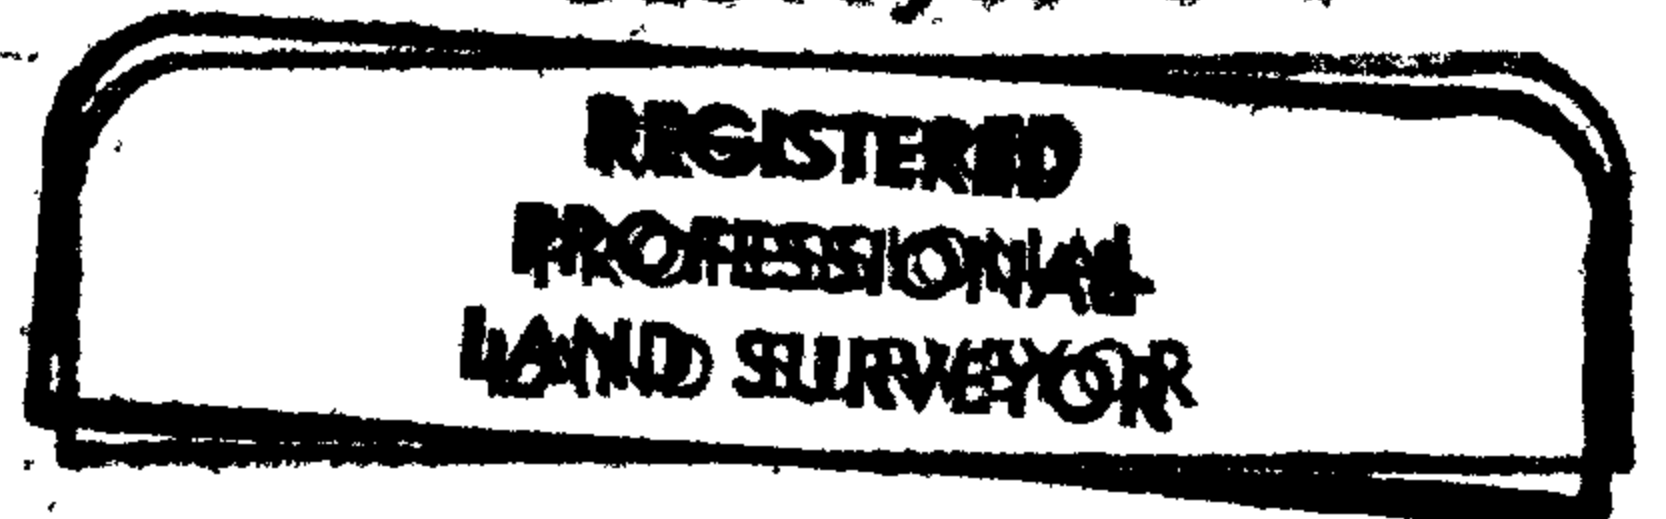

[Signature]

