

GOVERNMENT CORNER RESTORATION FORM

Township 30S Range 1W Sec. 26 County DOUGLAS

State OR Date 12/7/84 No. _____

Corner Designation

S 26

 S 35

- _____ Condition Report Only
- _____ Not Found
- Renewed
- _____ Unrecorded
- _____ Surveyed In
- _____ Referenced Out

Previous Renewals #48

MONUMENT DETAIL

Monument(s) Found: (Condition and Source)

20" X 14" X 14" CORNER STONE LOOSE AND ON TOP OF GROUND, MARKED "1/4" ON NORTH SIDE AND NEAR RECORD POSITION (N60°W 20.5 FT.) FROM 1922 16" RED FIR

1968 COUNTY SURVEYOR SPLIT PIPE MONUMENT DELIVERED TO OFFICE

COUNTY SURVEYORS OFFICE
 T30S R1W
 1/4 S.26
 S.35
 1968

Accessories Found:

1922 16" RED FIR, NOW 21" SCRIBED "1/4 S35 CSBT" IN A SINGLE BLAZE BEARS S60°E 20.5 FT. MEAS. FROM 1922 FACE. PORTION OF ORIGINAL SCRIBING "5B" STILL VISIBLE. TREE IS FROM 1922 MENSCH RESURVEY.

POSS. ORIG. 48" FIR, PRESENT SIZE INDETERMINABLE, NOW A 3 FT. TALL STUMP BEARS S82°W 6.1 FT. (REC. S88°W 5.9 FT). RECORD DISTANCE PROBABLY TAKEN TO BARK. WE FIND THE RECORD BEARING 6° TOO FAR RIGHT. MENSCH, IN 1922, FOUND AN ORIG. 8" FIR N60°E 13.2 FT. FROM THE CORNER (REC. N70°E 13.8 FT.) - I.E. RECORD BEARING 10° TOO FAR RIGHT. NO SIGN OF BLAZE OR SCRIBING.

24" CEDAR, NOW A FALLEN 20" STOB 8 FT TALL SCRIBED "1/4 S 26 CSBT" IN DOUBLE BLAZE. ROOT HOLE BEARS N46°E 20.6 FT. (REC. N46°E 20.6 FT.)

ORIG. 8" FIR NOT FOUND (REC. N60°E 13.2 FT.)

#2214

C.S. File No. 62/21-41C

RENEWAL

Monument Set (Procedure and Description)

Monument Detail

CORNER POSITION WAS ESTABLISHED USING RECORD POSITION (N 60° W 20.5 FT) FROM 1922 16" RED FIR. WE RESET 1968 MONUMENT AND SET CORNER STONE ON THE NORTH SIDE OF THE MONUMENT. WE ADD THE WORDS "RESET 1984" TO BEASS CAP.


COUNTY SURVEYORS OFFICE
T30S RIW
1/4 S.26
S.35
RESET 1984
1968

New Accessories STAMPED "B01" ^{ORIG.}

- SET BOAT SPIKE AT RU B.T. TAG IN 148" STUMP (NOT IN CENTER) BEARS S 82° W 7.2 FT
- 9" D. FIR BEARS N 8° W 78.5 FT. AND IS SCRIBED "1/4 S.26 CSBT" IN DOUBLE BLAZE.
- 8" YEW BEARS S 80° E 33.5 FT. AND IS BARK SCRIBED "1/4 S.35 CSBT"
- 10" YEW BEARS S 9° W 41.4 FT AND IS SCRIBED "1/4 S.35 CSBT" IN DOUBLE BLAZE.

Sketch of Monument, Accessories, and General Area

Location & Comments

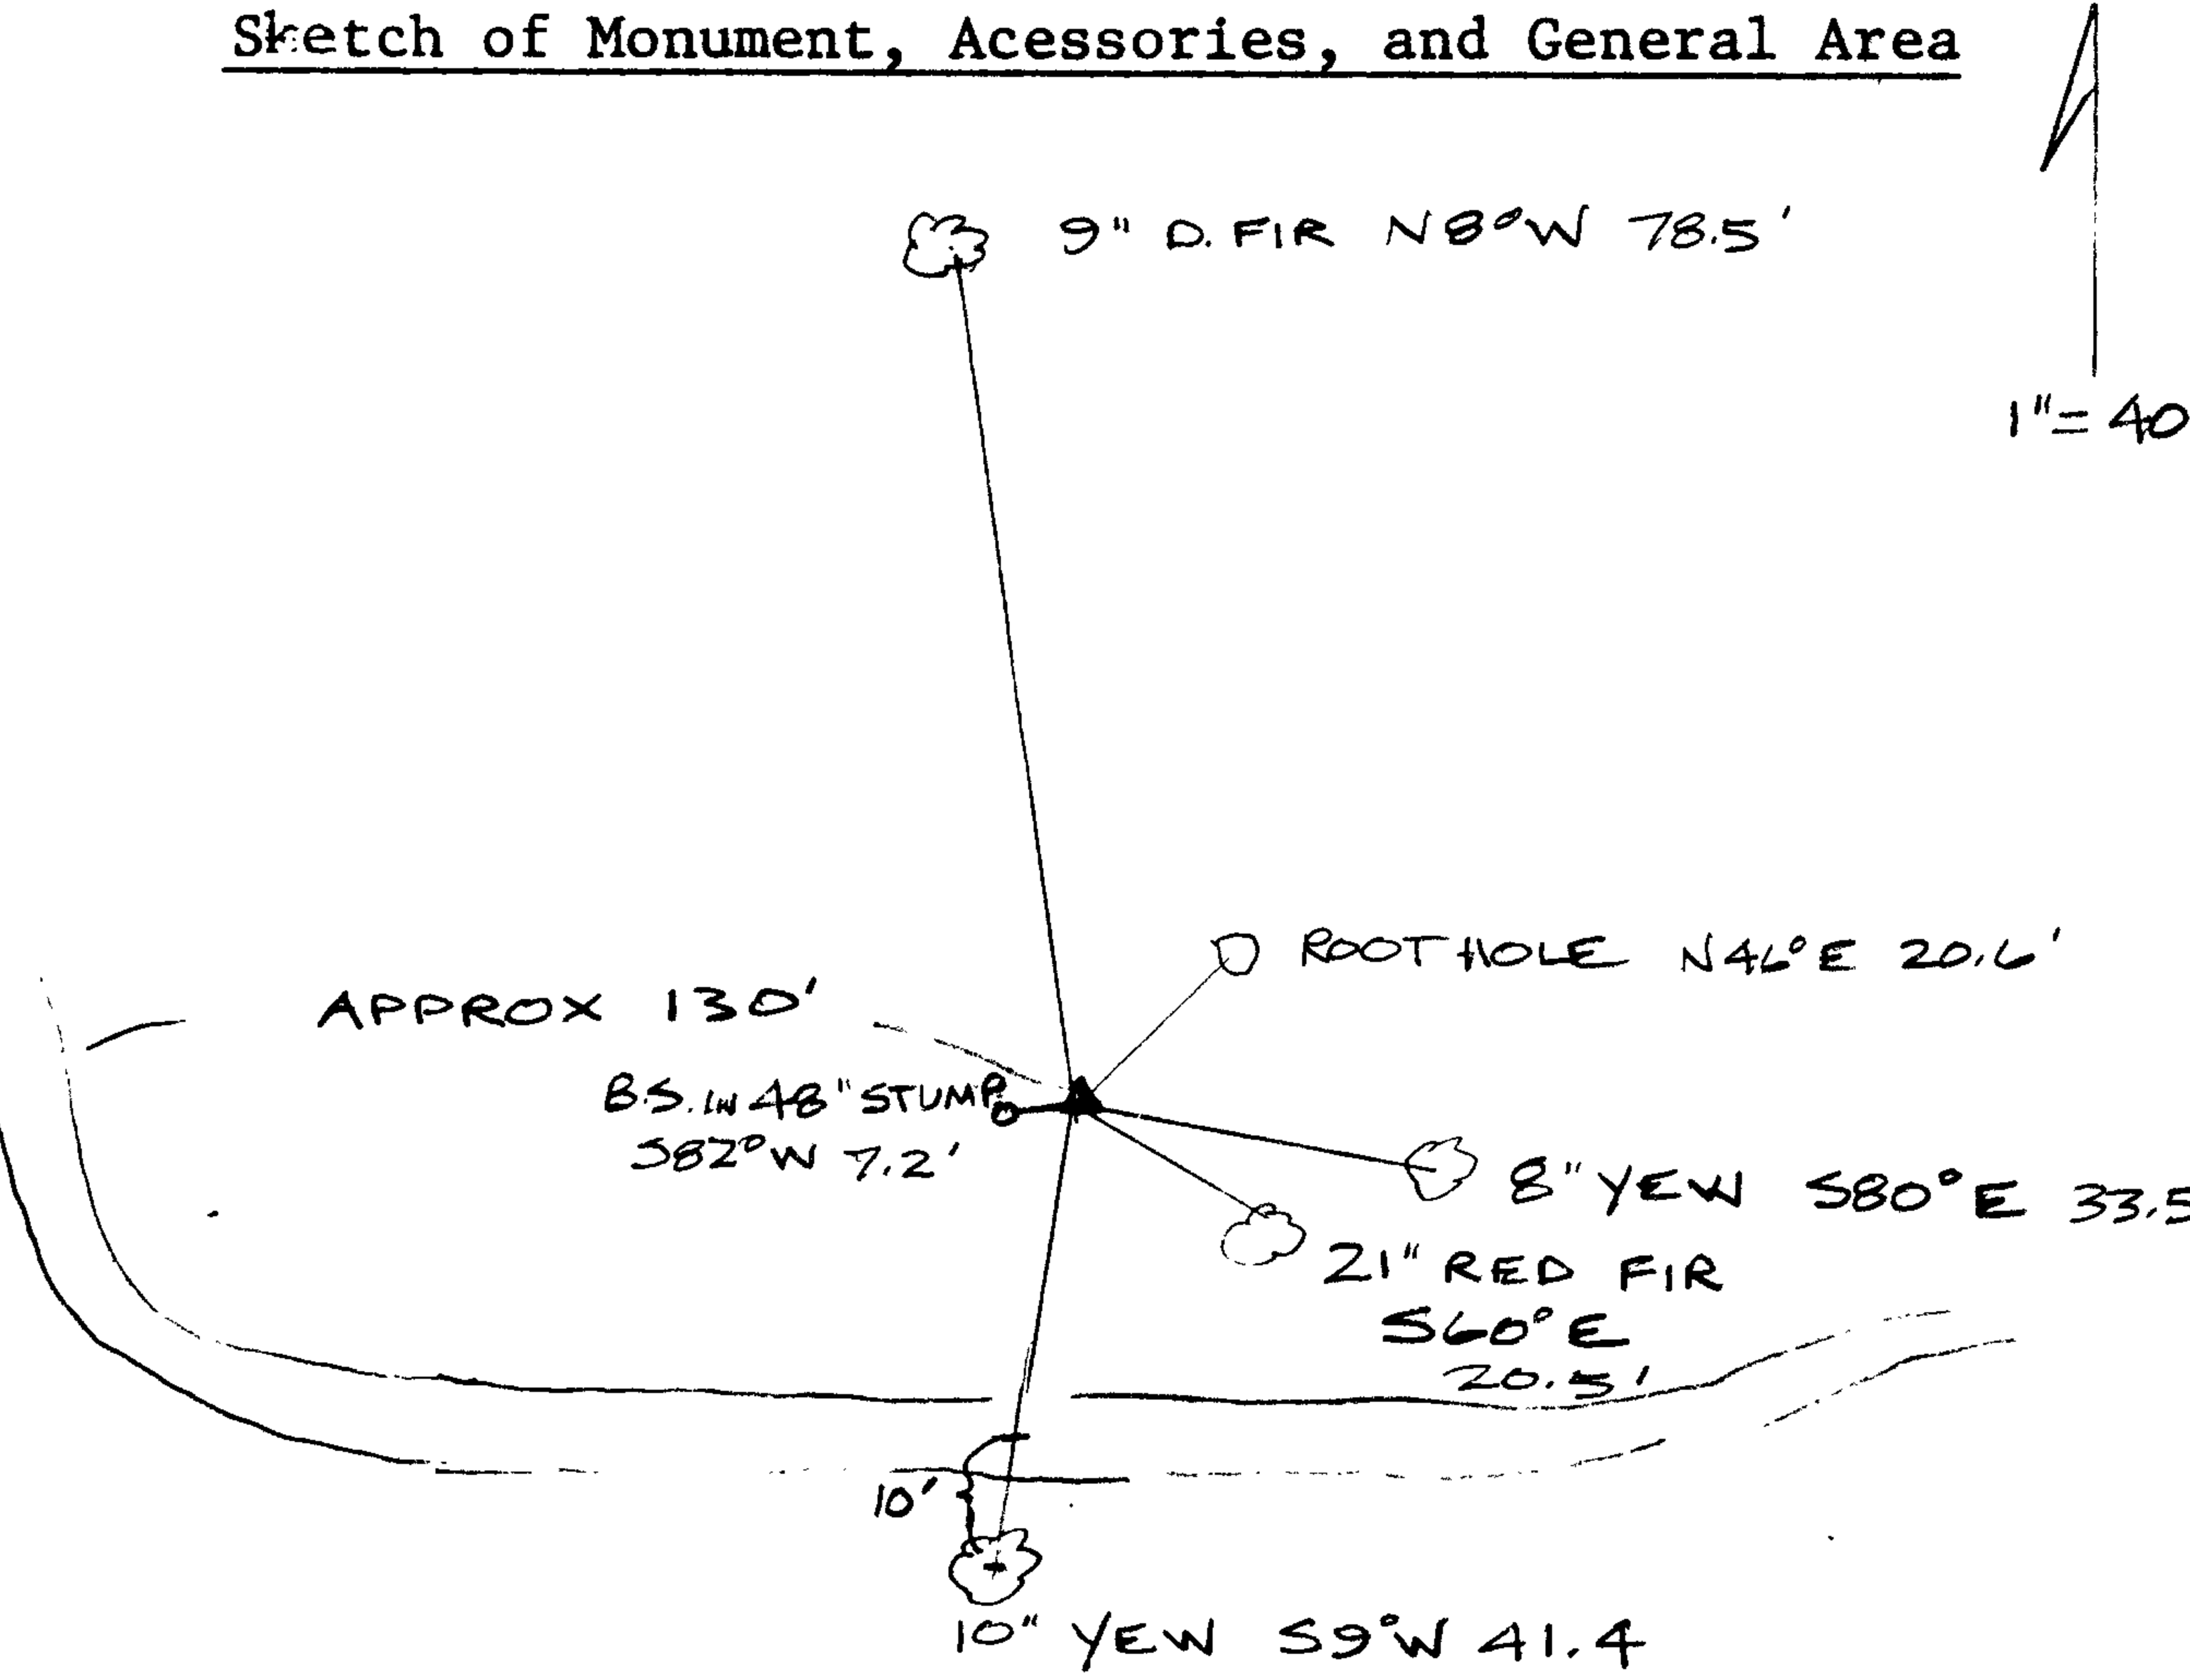

Location & Comments

Comp. Declin. 18 1/2° E

Agency DCSO.

Party Chief L.E. MONREAN

Notekeeper J.R. LUNDEEN

Witnesses S.J. FLAUSE

Surveyor's Seal

REGISTERED
PROFESSIONAL
LAND SURVEYOR

Larry E. Monrean

OREGON
JULY 13, 1979
LARRY E. MONREAN
#1830