


GOVERNMENT CORNER RESTORATION FORM

Township 26S Range 3W Sec. 31 County DOUGLAS

State OR Date 1/9/87 No. \_\_\_\_\_

Corner Designation

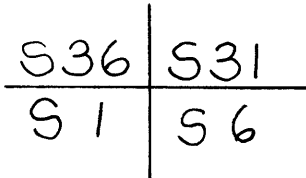

- Condition Report Only
- Not Found
- Renewed
- Unrecorded
- Surveyed In
- Referenced Out

Previous Renewals 1917 RESURVEY, REN #27 FOR T26S R4W


MONUMENT DETAIL

Monument(s) Found: (Condition and Source)

A 2 1/2" DISK ON A 2" I.P.  
PROTRUDES 4" ABOVE GROUND.  
MARKED AS NOTED (PER REN#94)

#99, #105

COUNTY  
T26S

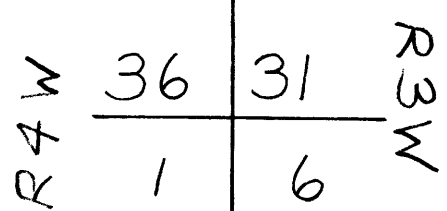

T27S

SURVEYOR

Accessories Found:

NO ORIG. BT'S FD.  
BT PER 1917 RESURVEY  
10" NOW A 32" DIA. W. OAK WITH A PREVIOUSLY OPENED NOW  
ROTTED FACE AND A SINGLE WELL HEALED BLAZE PER REN#105  
BEARS S76°W, 175.7 FT.

BT'S PER REN#94  
36" NOW A 48" DIA. 3 FT HIGH D. FIR STUMP WITH BARK  
SCRIBING "S BT" BEARS S6°E, 543.8 FT.

30" NOW A 30" 2 FT HIGH W. OAK STUMP WITH A POSSIBLE  
BLAZE, BEARS N 15 1/2° W, 233.1 FT (REC. 231.5 FT TO FACE).

SW BT GONE

BT PER REN#105  
12" NOW A 22" DIA. D. FIR WITH A WELL HEALED DOUBLE BLAZE  
BEARS S26 1/2° E, 443.8 FT (REC. S28°E, 444.6').

- #148 T.27-3 ✓
- #147 T.27-4 ✓
- #241 T.26-3 ✓
- #122 T.26-4 ✓

