

OREGON CORNER RESTORATION FORM

Section 33 Township 32 S Range 8 W

County DOUGLAS Date 4-24-85

CORNER DESIGNATION

STANDARD CORNER

T 32 S

S 33 | 34

T 33 S

Previous Renewals/Surveys, etc. 1916 RESURVEY, DOUGLAS COUNTY

RENEWAL NUMBER 85 (1968)

- Condition Report Only
- Not Found
- Renewed
- Unrecorded
- Surveyed In
- Referenced Out

Monument(s) & Accessories Found: (Condition and Source)

11X12X 10 INCH STONE (1916 REC. 11X12X17) WITH 3 GROOVES ON EAST & WEST FACES SETTING ON GROUND SURFACE WITH NE CORNER OF STONE CHECKING AT REFERENCES AS SHOWN. ALSO FD. DCSO BRASS CAP OUT OF GROUND. FD ORIG. BT'S
 1: 24" NOW 32" D. FIR WITH FAINT EVIDENCE OF HEALED BLAZE BEARS N 69° E 36 1/2 FT. (REC. N 65° E 35 FT.)
 2: 34" NOW 40" D. FIR FAINT BARK SCRIBE VISIBLE S 26° W 7 1/2 FT. (REC. N 48° W)
 3: 16" NOW 25" D. FIR WITH HEALED REBLAZE BEARS N 42° W 13 1/2 FT. (REC. N 48° W)
 FD. 1968 BT 4: 9" NOW 10" MADRONE WITH PARTIALLY HEALED DOUBLE BLAZE BEARS N 10° E 35 1/2 FT.

Monument Detail BRASS CAP MILD.

COUNTY SURVEYORS OFFICE

T 32 S R 8 W

DOUG.

S 33 | 34


S 3

JOB.

T 33 S

1968

Sketch ● 10" MADRONE N 10° E 35 1/2 FT

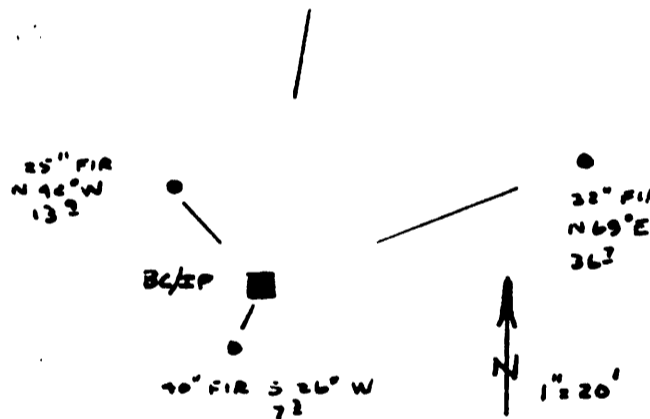

Monument Set (Procedures and Description)

THE 1968 BRASS CAP AND IRON PIPE (1" X 20") IS RESET AT CORNER IN MOUND OF STONE AND EARTH WITH 1916 RESURVEY STONE BURIED ALONG SW EDGE. RESET 1985" IS ADDED TO CAP, TOP OF CAP IS FLUSH WITH MOUND. NOTE: TOP OF CAP IS SET AT POSITION DETERMINED AND REFERENCED FOR CORNER. DUE TO BEDROCK THE MONUMENT CAN NOT BE SET VERTICALLY. BOTTOM OF MONUMENT IS SITUATED

N 69° E 0 ± FEET FROM VERTICAL.

NO NEW ACCESSORIES ADDED

Location & Comments

Compass Declination 18 1/2° E

Firm/Agency DOUGLAS CO.

SURVEYOR'S OFFICE

Address RM 205 JUSTICE BLDG.

ROSENBERG, OR. 97470

Party Chief L.E. MONREAN

Notes [Signature]

Witness RW SMITH

SJ FLAUS

Surveyor's Seal

REGISTERED PROFESSIONAL LAND SURVEYOR

[Signature]

OREGON JULY 13, 1979 LARRY E. MONREAN #1830

#1164

C.S. File No. 62/25-80