

FILED
RECEIVED *JR*

OREGON CORNER RESTORATION FORM

JAN 30 1985

Section 28 Township 29S Range 1W

COUNTY SURVEYOR
DOUGLAS COUNTY, ORE.

County DOUGLAS Date JAN. 21, 1985

Corner Designation

QUARTER (1/4) CORNER OF
SECTIONS 28 AND 27.

- Condition Report Only
- Not Found
- Renewed
- Unrecorded
- Surveyed In
- Referenced Out

Previous Renewals/Surveys, etc. 24, M 70-44A


Monument(s) & Accessories Found: (Condition and Source)

1 1/4" OUTSIDE DIAMETER IRON PIPE, FIRMLY SET, PROJECTING 15" ABOVE THE GROUND WITH BRASS CAP ATTACHED MARKED AS SHOWN BELOW, SET IN 1969 BY JOHN POWELL, DOUGLAS COUNTY SURVEYOR'S OFFICE. ORIGINAL STONE, 18" X 10" X 8", FOUND LYING ALONGSIDE IRON PIPE, WITH MARKS "1/4" VISIBLE. ORIGINAL REMAINING BT:

A 50" S. PINE STUMP, N67°E, 12 2/3 FT (REC. 13 2/3 FT.) WITH SCRIBE MARKS "S4 BT" VISIBLE ON PARTIALLY HEAVED BLAZE.

Monument Detail

AND BTS BY POWELL IN 1969: Sketch

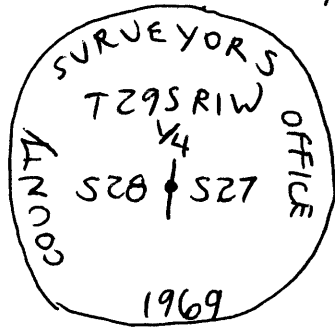

A 10" D. FIR, N24°E, 11 1/4 FT., WITH HEAVED DOUBLE BLAZE.

A 11" PONDEROSA PINE SNAG (REG. SUGAR PINE), S27°W 18 0 FT., WITH SCRIBE MARKS "CS" VISIBLE ON PARTIALLY HEAVED DOUBLE BLAZE.

Monument Set (Procedures and Description)

ADD 3 FT. DIAMETER MOUND OF STONE. IRON PIPE NOW PROJECTS 6"

New Accessories

I MARK A NEW BT:
A 16" D. FIR, N 27°W, 16 3/4 FT. SCRIBED "1/4 S28 BT" ON A DOUBLE BLAZE WITH A BRASS WASHER STAMPED "LS 1181" NAILED FLUSH TO LOWER BLAZE.

Location & Comments

Surveyor's Seal

CORNER IS 40 FT. EAST OF USFS ROAD #2827. A STEEL FENCE POST WITH USFS SIGNS #54-2 & #54-4 BEARS N0 3/4°E, 4 0 FT.

Compass Declination 18 1/2°E
Firm/Agency UMPQUA NATIONAL FOREST
Address 2900 STEWART PKWY, ROSEBURG, OR, 97470
Party Chief LEONARD HERZSTEIN
Notes LEONARD HERZSTEIN
Witness RANDY LOPEZ



1-23-85

#148 X