

GOVERNMENT CORNER RESTORATION FORM

Township 31S Range 2W Sec. 35 County DOUGLAS

State OR Date DEC. 12, 1985 No. _____

Corner Designation

WEST ONE SIXTEENTH CORNER OF SECTION 35 ONLY, TOWNSHIP 31 SOUTH, RANGE 2 WEST, WILLAMETTE MERIDIAN.


- _____ Condition Report Only
- _____ Not Found
- Renewed
- _____ Unrecorded
- _____ Surveyed In
- _____ Referenced Out

Previous Renewals M 42-72

Monument(s) Found: (Condition and Source)

2 1/2" OUTSIDE DIAMETER IRON PIPE FIRMLY SET PROJECTING 3" ABOVE THE GROUND, SET BY WILLIAM S. BARNES, P.E. 2128, IN 1972, WITH 3" DIAMETER BRASS CAP ATTACHED AND MARKED AS SHOWN.

MONUMENT DETAIL

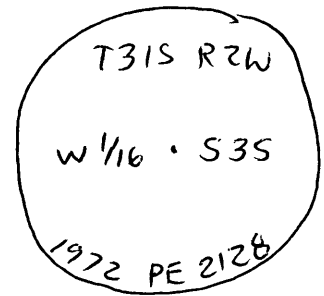

Accessories Found:

BEARING TREES MARKED BY BARNES IN 1972:

A 22" DOUG. FIR, N60°E, 12^S FT. (REC: 12^B FT.), WITH SCRIBE MARKS "W 1/16 S35 PE 2128" "BT" VISIBLE ON PARTIALLY HEALED DOUBLE BLAZE AND A 3/4" DIAMETER BRASS WASHER, STAMPED "PE 2128", NAILED FLUSH TO THE LOWER BLAZE.

A 30" MADRONE SNAG, S10°E, 7^S FT. (REC: 8^L FT.), WITH SCRIBE MARKS "W 1/16 S35 PE 2128" "BT" VISIBLE ON A PARTIALLY HEALED DOUBLE BLAZE AND WITH A 3/4" DIAMETER BRASS WASHER, STAMPED "PE 2128", NAILED FLUSH TO THE LOWER BLAZE.

AND A GUARD POST:

A STEEL FENCE POST, NORTH, 7^S FT., ~~AND~~ PROJECTING 4 FT. ABOVE THE GROUND, WITH FOREST SERVICE SIGN NO. 54-9 ATTACHED.

