

GOVERNMENT CORNER RESTORATION FORM

Township 27 S Range 7 W Sec. 32 County DOUGLAS

State OR Date 5-2-85 No. _____

Corner Designation

$\frac{1}{4}$ $\frac{S 22}{S 27}$

- Condition Report Only
- Not Found
- Renewed
- Unrecorded
- Surveyed In
- Referenced Out

MONUMENT DETAIL

Previous Renewals CS 55/III (1969 GARRET RENEWAL)

Monument(s) Found: (Condition and Source)

NONE, THE MOUND OF STONE CALLED BY GARRET HAS BEEN DESTROYED PRESUMABLY BY CONSTRUCTION OF AN EAST-WEST ROADWAY.

FROM POSITION AS DETERMINED BY GARRET RENEWAL WHICH LIES ALONG S. EDGE OF ROADWAY

Accessories Found:

PROBABLE ORIGINAL BLACK OAK IS NOW 17 INCH DIAMETER WITH THE FACE AXED OUT, CENTER DECAYED, IS ALIVE BUT IN VERY POOR CONDITION. NO SCRIBING FOUND. BEARS N 20° W 16 1/2 FT.

GARRET BT'S.

8" W. OAK WITH WELL HEALED DOUBLE BLAZE BEARS S 84° E 38 1/2 FEET.

8" NOW 11" PINE WITH WELL HEALED DOUBLE BLAZE BEARS N 54 1/2° W 20 1/2 48 3/4 FEET (REC. 49° CHECKS CENTER OF TREE AT BREST HEIGHT).

1994

RENEWAL

Monument Set (Procedure and Description)

ACCORDING TO GARRETT THE BEARING AND DISTANCE TO THE APPARENT BT AS WELL AS THE NW COR. SECTION 27 CHECKS WELL WITH RECORDED. THE AERIAL PHOTO OF THE AREA SHOWS THIS LOCATION TO AGREE WITH STRAIGHT LINE BETWEEN CONTROLLING SECTION CORNERS. CONSTRUCTION OF THE E-W ROADWAY IS SOME EVIDENCE OF AGREEMENT WITH POSITION FOR USAGE PURPOSES. THERE ARE FEW LARGE OAK TREES IN THIS AREA WHICH WOULD TEND TO LESSON THE LIKELIHOOD OF FINDING THIS EVIDENCE BY COINCIDENCE. CONSIDERING THE ABOVE I BELIEVE THIS IS CURRENTLY THE BEST EVIDENCE OF THE ORIGINAL CORNER. TO PERPETRATE THIS POINT WE SET A 1" X 30" IRON PIPE WITH BRASS CAP 13" INTO THE GROUND AND BUILT A MOUND OF STONE AROUND MEASURING 3' X 4' X 17" HIGH.

Monument Detail


DOUGLAS COUNTY SURVEYOR
 T 27 S
 S 22
 S 27
 R 7 W
 1985

New Accessories

11" D. FIR DOUBLE BLAZED AND SCRIBED "1/4 S 22 CS BT" BEARS N 11° W 20 1/2 FT.

10" D. FIR DOUBLE BLAZED AND SCRIBED "1/4 S 27 CS BT" BEARS S 25° W 52 1/2 FT.

Sketch of Monument, Accessories, and General Area

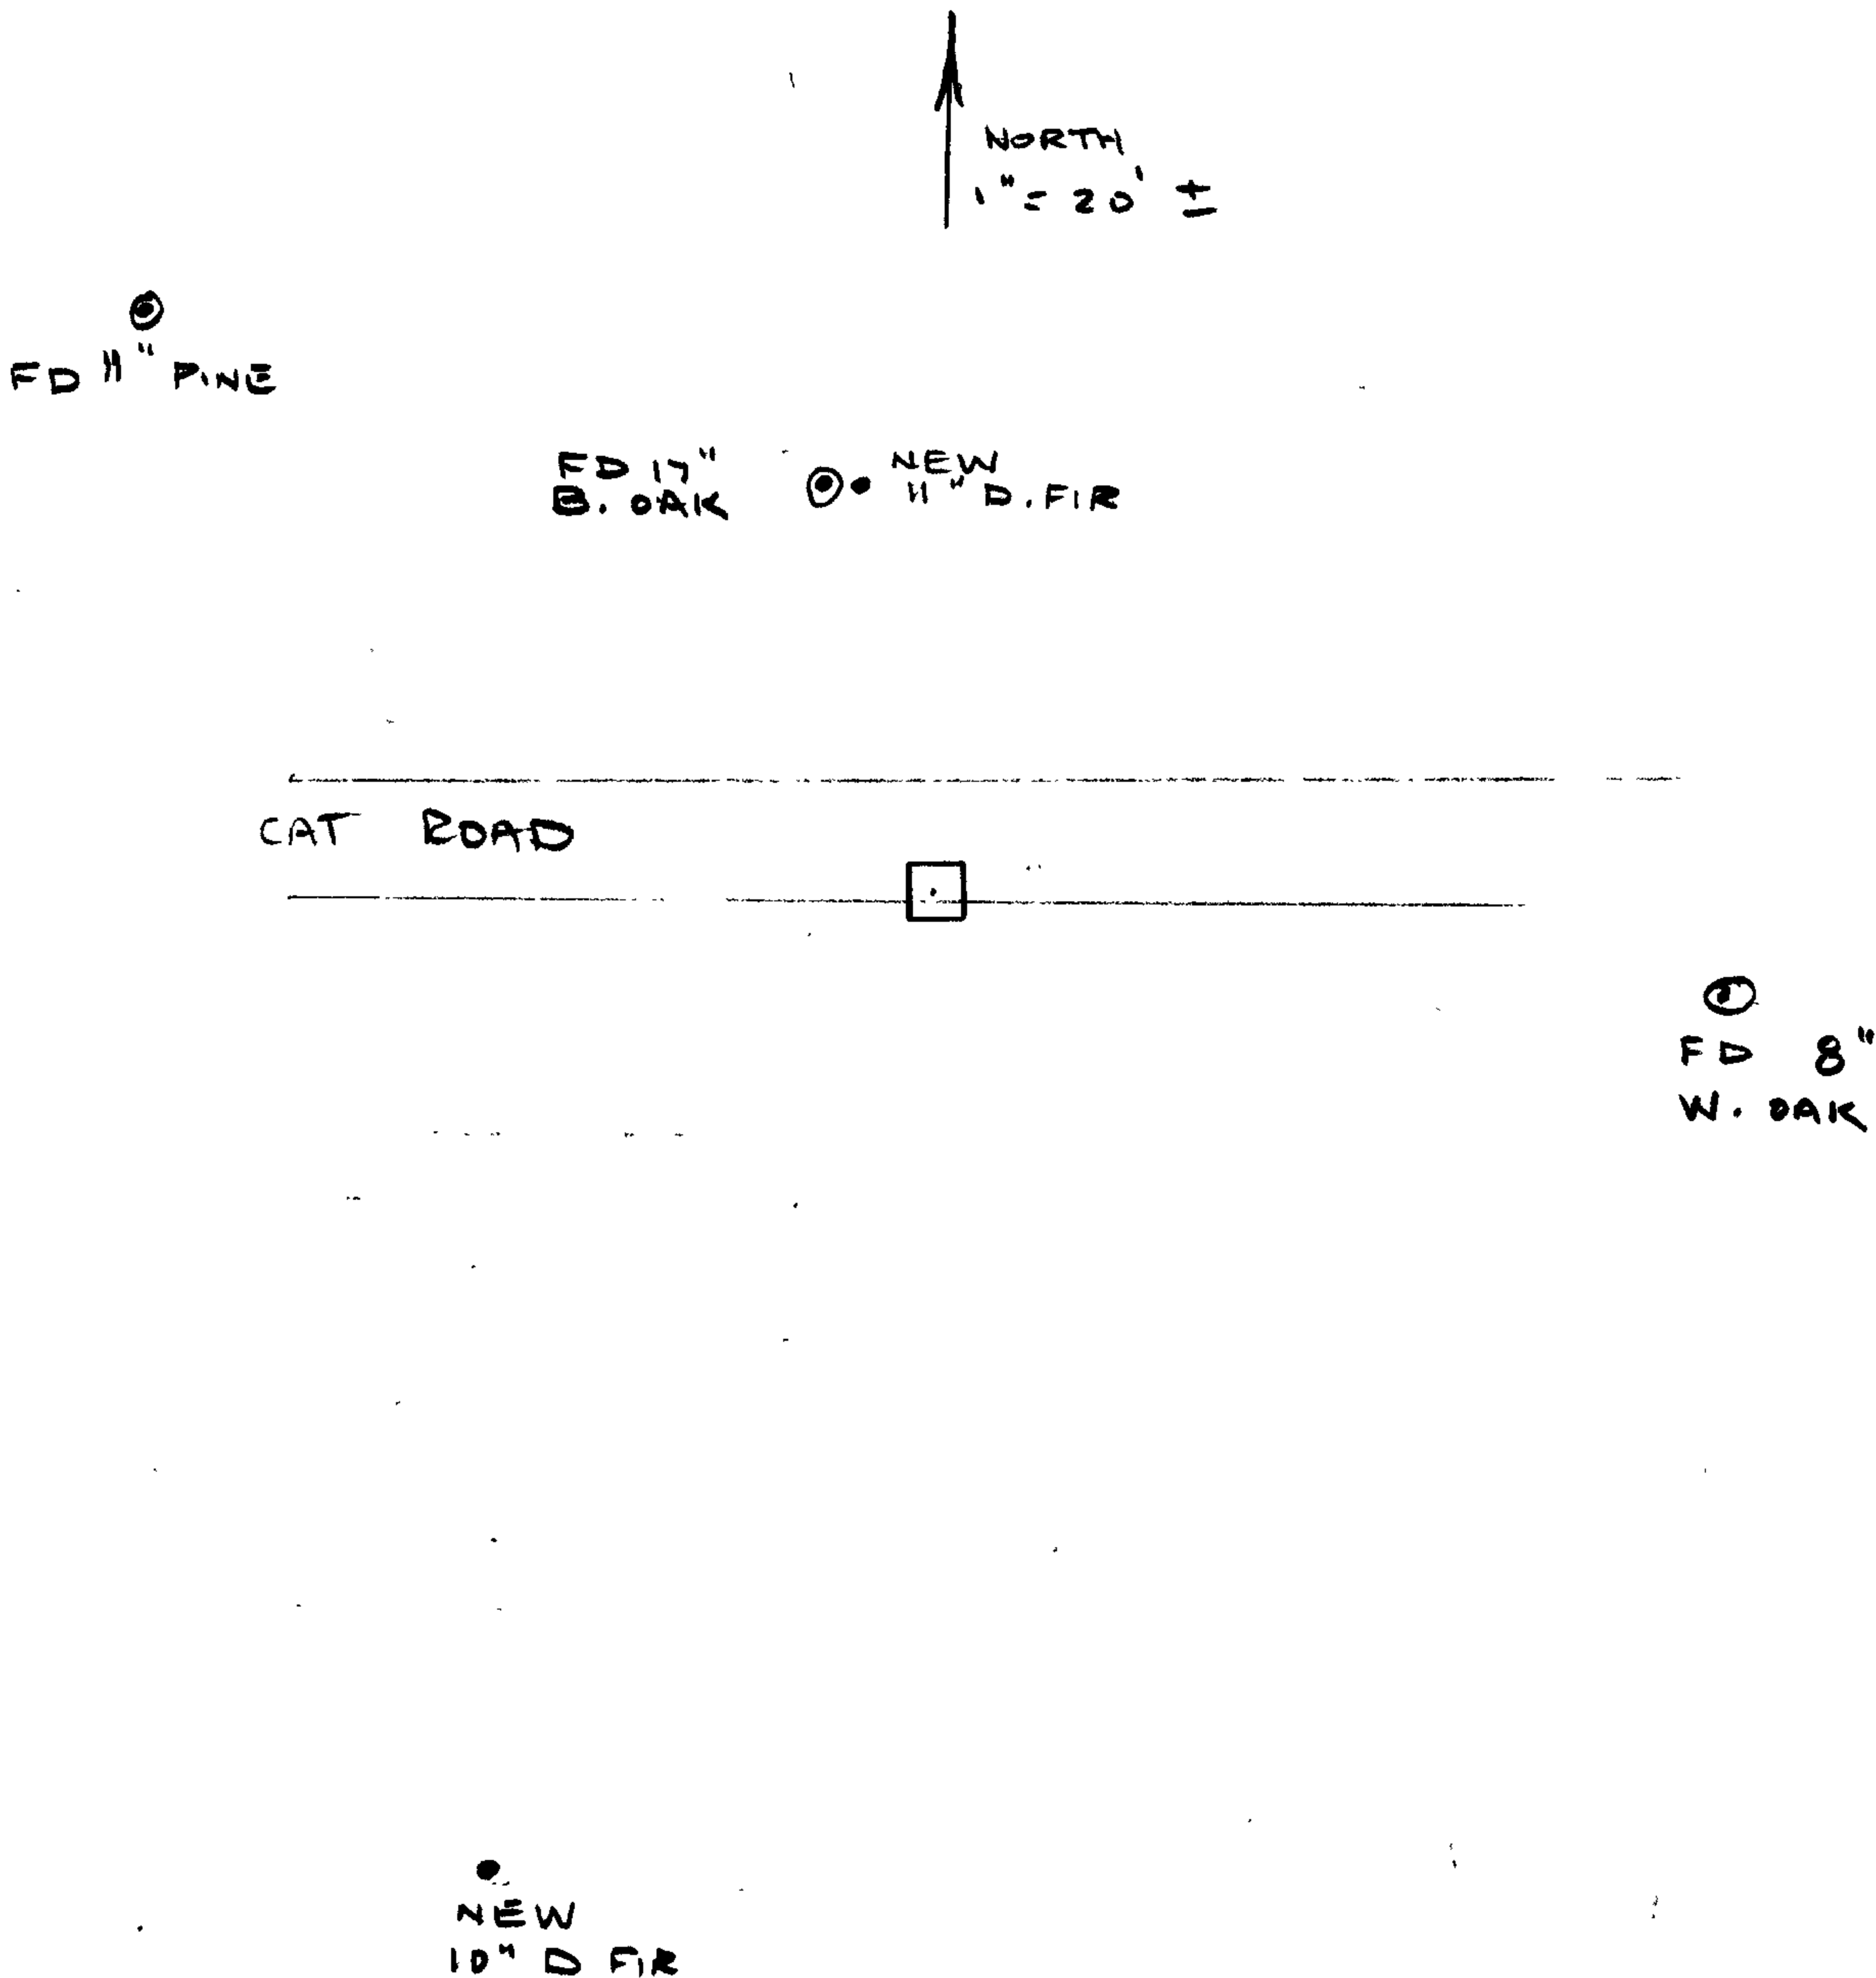

Location & Comments

Comp. Declin. 18 1/2° EAST
 Agency DOUGLAS COUNTY SURVEYORS OFFICE
 Party Chief LARRY E. MONREAN
 Notekeeper " " "
 Witnesses R.W. SMITH S.J. FLAUSIE

Surveyor's Seal

REGISTERED
 PROFESSIONAL
 LAND SURVEYOR

Larry E. Monrean

OREGON
 JULY 13, 1979
 LARRY E. MONREAN
 #1830