

GOVERNMENT CORNER RESTORATION FORM

Township T30S Range R2W Sec. 6 County DOUGLAS

State OREGON Date JUNE 6, 1985 No. _____

Corner Designation

T29S R2W

1/4 56

- Condition Report Only
- Not Found
- Renewed
- Unrecorded
- Surveyed In
- Referenced Out

Previous Renewals 1917 RESURVEY, 1971 DEPENDENT RESURVEY MONUMENT DETAIL

Monument(s) Found: (Condition and Source)

RENEWAL #127

AN ORIGINAL PORPHYRY STONE MEASURING APPROXIMATELY 14x12x6 INCHES AND HAS POSSIBLE "4" MARKED ON SOUTH FACE; THIS STONE IS LOOSELY SET ON SURFACE OF GROUND AT EAST EDGE OF BRASS CAP MONUMENT.

FROM 1968 RENEWAL #127 AN IRON PIPE AND BRASS CAP MONUMENT MARKED AS AT RIGHT IS FIRMLY SET AND PROTRUDES 12 INCHES FROM GROUND.

COUNTY SURVEYORS OFFICE

T29S

R2W

1/4 56

T30S

1968

Accessories Found:

TWO ORIGINAL 1909 B.T.s. A FIR 10 INS. DIAM NOW A 16 INCH DBH D. FIR WITH X CHOPPED IN BARK AND A PARTIALLY HEALED OBLITERATED FACE, BEARS N 35° E, 2.6 FT. DIST (RECORD N 35° W, 2.6 FT. DIST). A MADRONE 6 INS DIAM NOW A 9 INCH DBH MADRONE WITH A PARTIALLY HEALED ROTTED OUT BLAZE, BEARS S 57° W AT CENTER OF ROOT CROWN, S 40° W AT CENTER OF TRUNK BLAZE HEIGHT, 2.3 FT DIST. (RECORD S 40° E 2.3 FT. DIST.)

FROM 1917 RESURVEY A 12 INS. DIAM FIR NOW A SEVERELY ROTTEN 6" TALL, BROKEN FIR STUB WITH NO IDENTIFIABLE MARKS, BEARS S 2 1/4° E 12 3/4 FT. DISTANT TO CENTER OF APPAREN ROOT CROWN (RECORD S 2 1/4° E 13 3/4 FT. DIST.)

TWO B.T.s FROM RENEWAL #127 FOUND. A 5" D. FIR NOW A 9 INCH DBH D. FIR, BEARS S 41° E, 17 1/4 FT DIST. (AS PER RECORD) WITH FULLY HEALED SINGLE BLAZE. A 30" D. FIR STILL A 30 INCH DBH, D. FIR WITH A FULLY HEALED SINGLE BLAZE AND A "8" CHOPPED INTO THE BARK BEARS S 35° W, 18 3/4 FT DIST. (AS PER RECORD)

T30-2 #258 ✓
T30-2 #120 ✓

RENEWAL

Monument Set (Procedure and Description)

Monument Detail

N/A


N/A

New Accessories

A 6 INCH DBH DOUGLAS FIR, DOUBLE BLAZED AND SCRIBED 1/4 S6 CS
BT, BEARS S14 1/2° E, 18 0 FT. DIST.

Sketch of Monument, Accessories, and General Area

Location & Comments

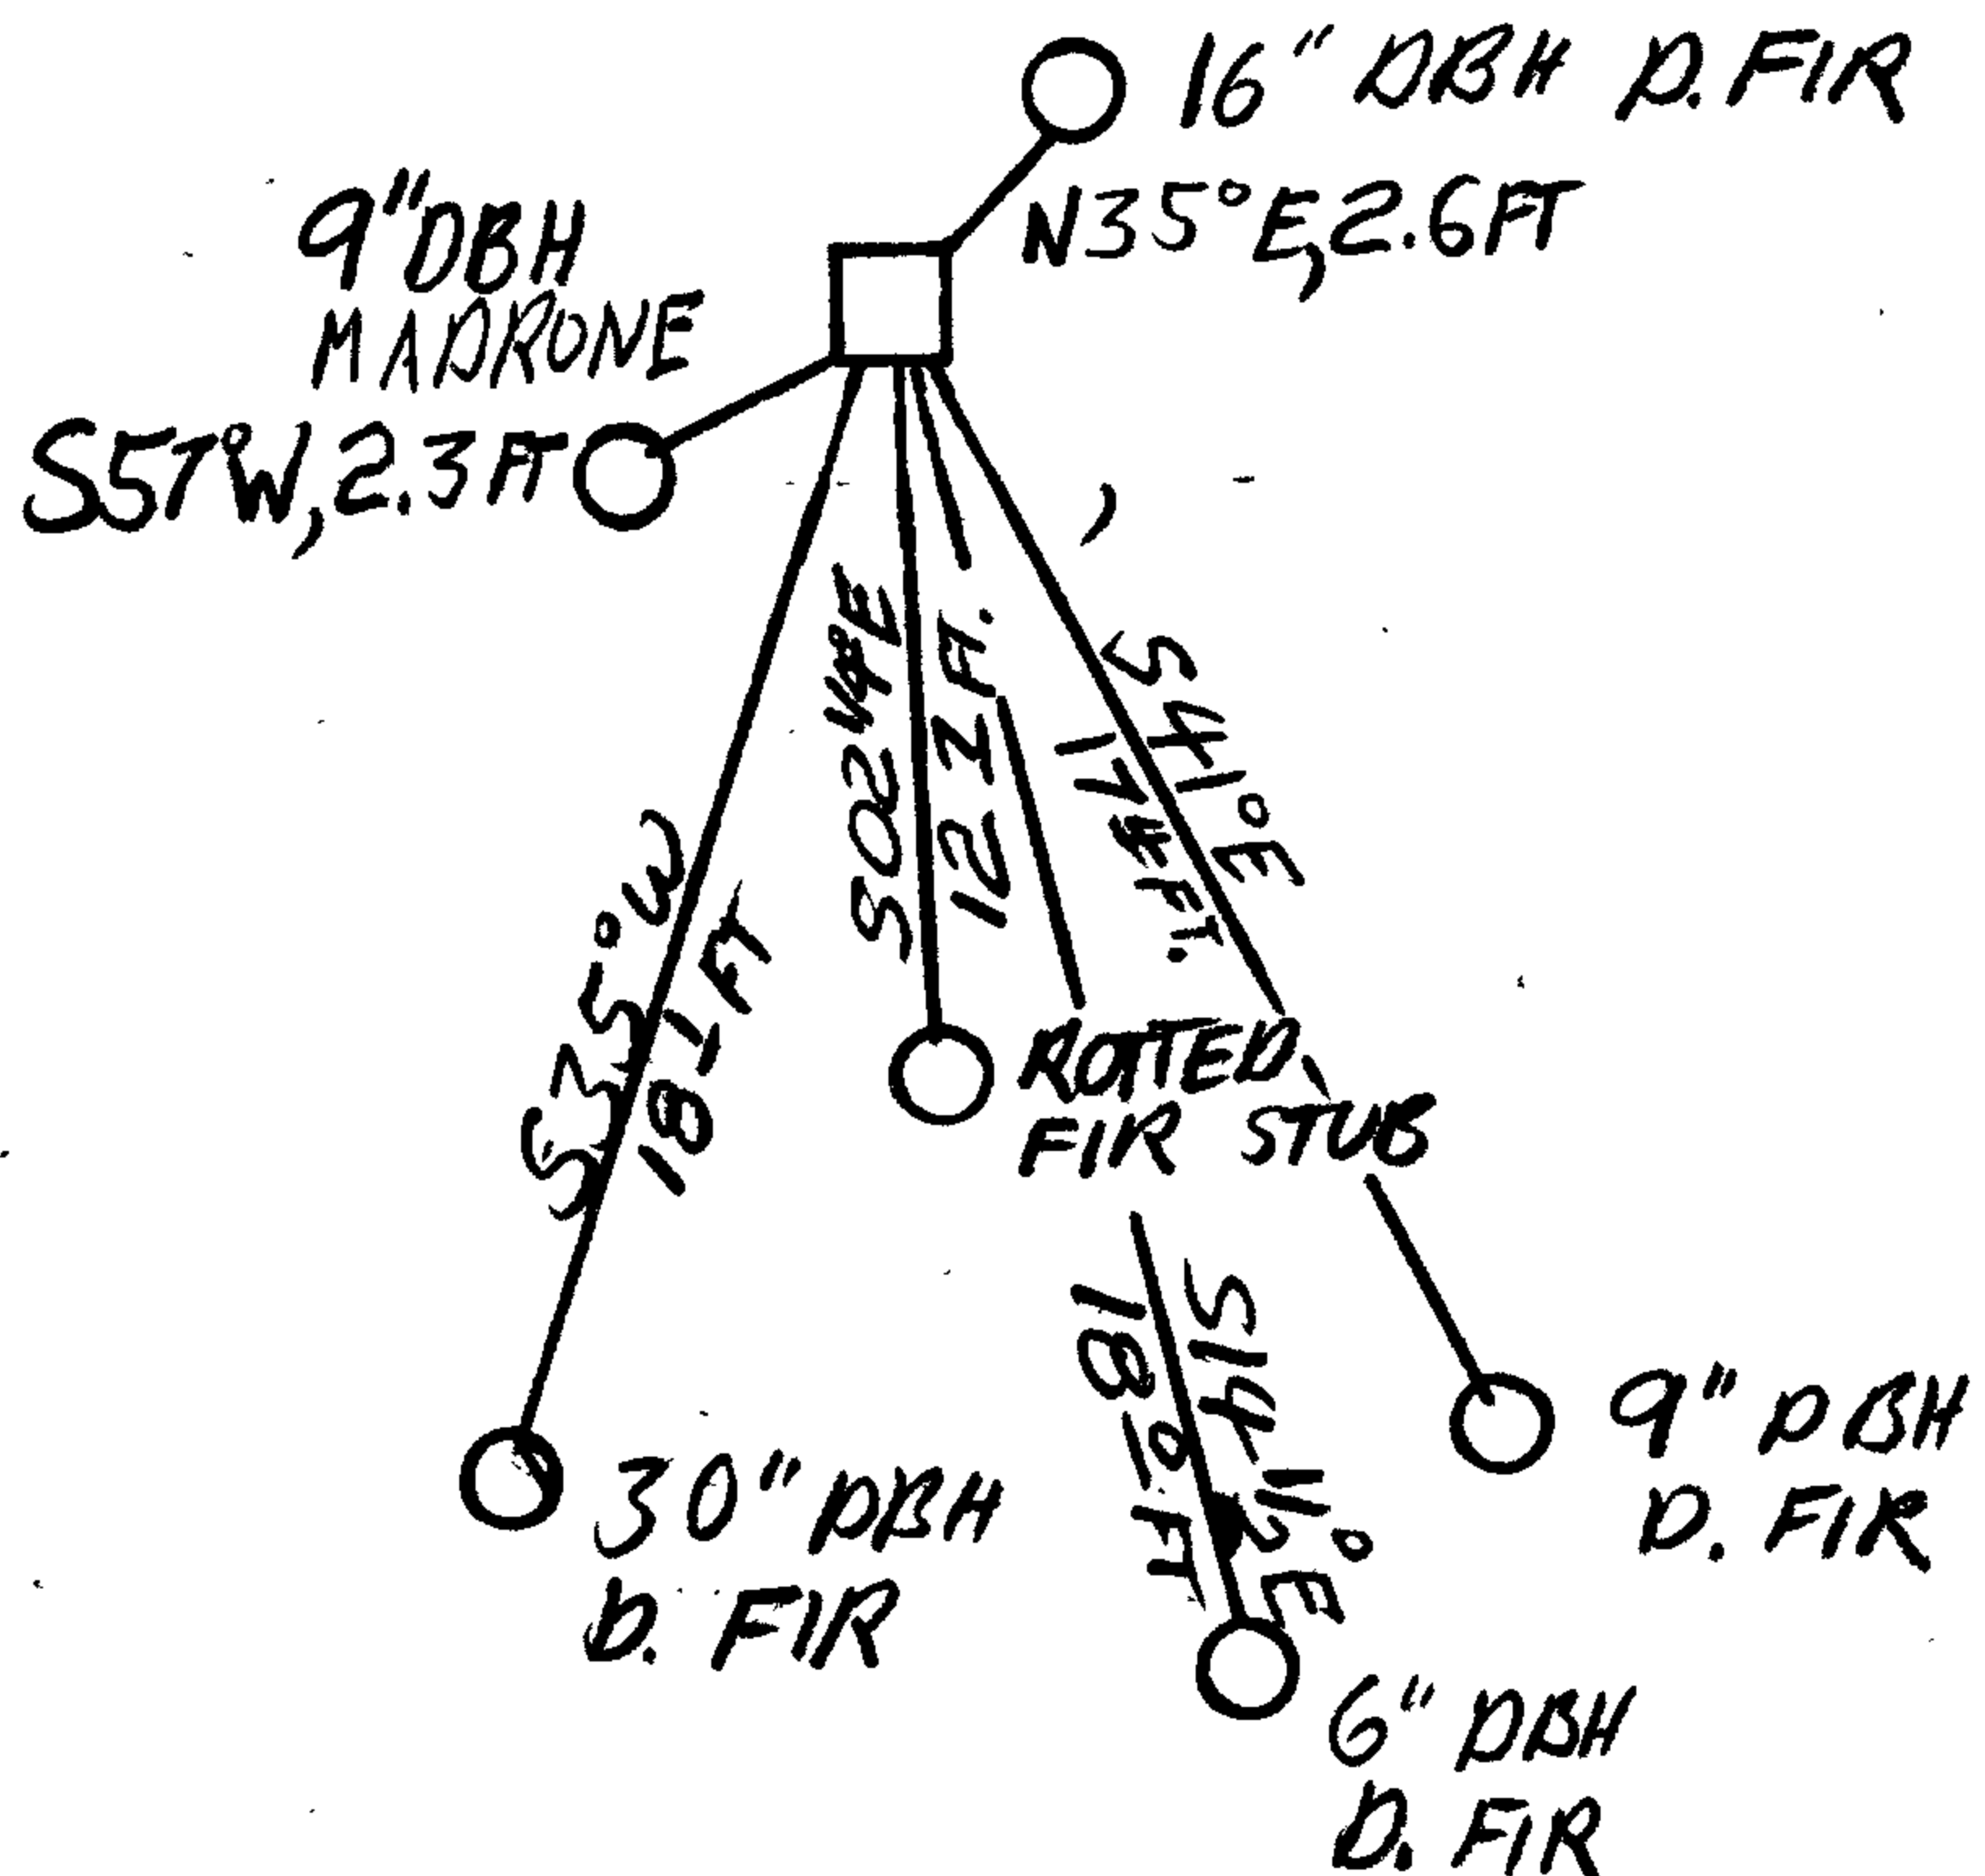

Comp. Declin. 18 1/2° E
Agency DCSO
Party Chief SJ FLAUSE
Notekeeper Stephen John Flause
Witnesses RW. SMITH

Surveyor's Seal

REGISTERED
PROFESSIONAL
LAND SURVEYOR

Larry E. Monrean

OREGON
JULY 13, 1979
LARRY E. MONREAN
#1830