


GOVERNMENT CORNER RESTORATION FORM

Township 27S Range 1E Sec. 25 County DOUGLAS

State OR Date 6/12/85 No. _____

Corner Designation

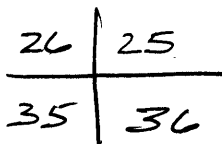

- Condition Report Only
- Not Found
- Renewed
- Unrecorded
- Surveyed In
- Referenced Out

Previous Renewals NONE


MONUMENT DETAIL

Monument(s) Found: (Condition and Source)

US GLO CAP →

THE CAP & POST LEAN SLIGHTLY NE
NO SIGN OF CAT DAMAGE OR
DISTURBANCE.

U.S.F.S. REQUESTED WE RENEW
THIS CORNER AS THE MONUMENT
WAS DESTROYED. WE SAW FLAGGING ON
GROUND & FOUND CARBY KICKING
2 INCHES OF DIRT FROM TOP
OF
MONUMENT IS FIRMLY SET.

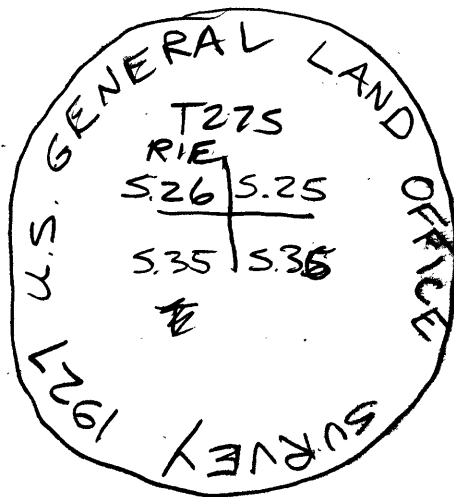

Accessories Found:

- 12" FIR (NOW 13" AND FALLEN) BEARS N27°E 36.3 FT. FRAGMENTARY SCRIBING & OPEN ROTTEN BLAZE.
- 24" HEMLOCK (NOW 31") BEARS S60°E 2.9 FT - VISIBLE & PARTIALLY HEALED SINGLE BLAZE FACES N85°W - SOME SCRIBING VISIBLE "30 BT"
- 18" PINE (NOW 19" DEAD SNAG) BEARS S35°W 34.4 FT (REC 33.7') UNHEALED BLAZE SHOWS "LTS R1E S.35 BT."
- 12" FIR (NOW 22") BEARS N41°W 36.3 FT (REC N39 1/2°W) HEALED BLAZE - NO SCRIBING VISIBLE
- 10" W. FIR BEARS S67°W 36.2 FT SCAR FACING CORNER NO SCRIBING VISIBLE. IT HAS A FOREST SERVICE TAG.

#244

