


GOVERNMENT CORNER RESTORATION FORM

Township 29S Range 1W Sec. 3 County DOUGLAS

State OR Date 6/13/85 No. _____

Corner Designation

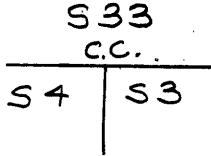

- Condition Report Only
- Not Found
- Renewed
- Unrecorded
- Surveyed In
- Referenced Out

Previous Renewals # 113 T29-1 (# 25 T28-1)

MONUMENT DETAIL

Monument(s) Found: (Condition and Source)

A US GENERAL LAND OFFICE
 BRASS CAP ON A 2" DIA. I.P.
 PROTRUDING 15" ABOVE GROUND
 AND LEANING 10" WESTERLY
 MARKED AS NOTED.

US GENERAL LAND OFFICE

T28S R1W S33
S4 | S3
 T29S R1W
 C.G.
 1922

Accessories Found:

10" DIA. NOW 24" DIA. 2 FT HIGH SUGAR PINE STUMP
 WITH A SINGLE WELL HEALED BLAZE BEARS S34°E, 5.0'
 (REC. S39°E, 4.6' DIST. IS TO FACE OF BLAZE.) ORIG.

6" DIA. NOW 7" DIA. 25 FT HIGH CHINQUAPIN SNAG WITH
 ROTTED EVIDENCE OF A BLAZE BEARS S42°W, 14.5 FT
 (DIST. IS TO CENTER OF ROOTCROWN AND FACE OF BLAZE DUE TO
 LEANING GROWTH OF TREE). ORIG.

9" DIA. GRAND FIR. NOW A 12" DIA. WHITE FIR WITH A DOUBLE
 WELL HEALED BLAZE BEARS S42½°W, 5.8 FT (REC. S37°W, 5.3 FT
 IS TO CAP ON LEANING MONUMENT).

#150 T29-1 ✓
 #40 T28-1 ✓

RENEWAL

Monument Detail

Monument Set (Procedure and Description)


US GENERAL LAND OFFICE BRASS CAP
 ON I.P. STRAIGHTEN TO PLUMB AND
 SURROUNDED BY A 24" DIA. 15" TALL
 MOUND OF STONE

BECAUSE BOTH ORIG. FACE MEASUREMENTS
 AND ONE ORIG. BRG. AGREE WITH PLUMB
 POSITION OF MONUMENT WE ACCEPT
 PLUMB POSITION.

New Accessories

28" DIA. SUGAR PINE DOUBLE BLAZED AND SCRIBED
 " T295 RIW S4 CC CS BT" BEARS S70 1/2° W 50.1 FT.

Sketch of Monument, Accessories, and General Area

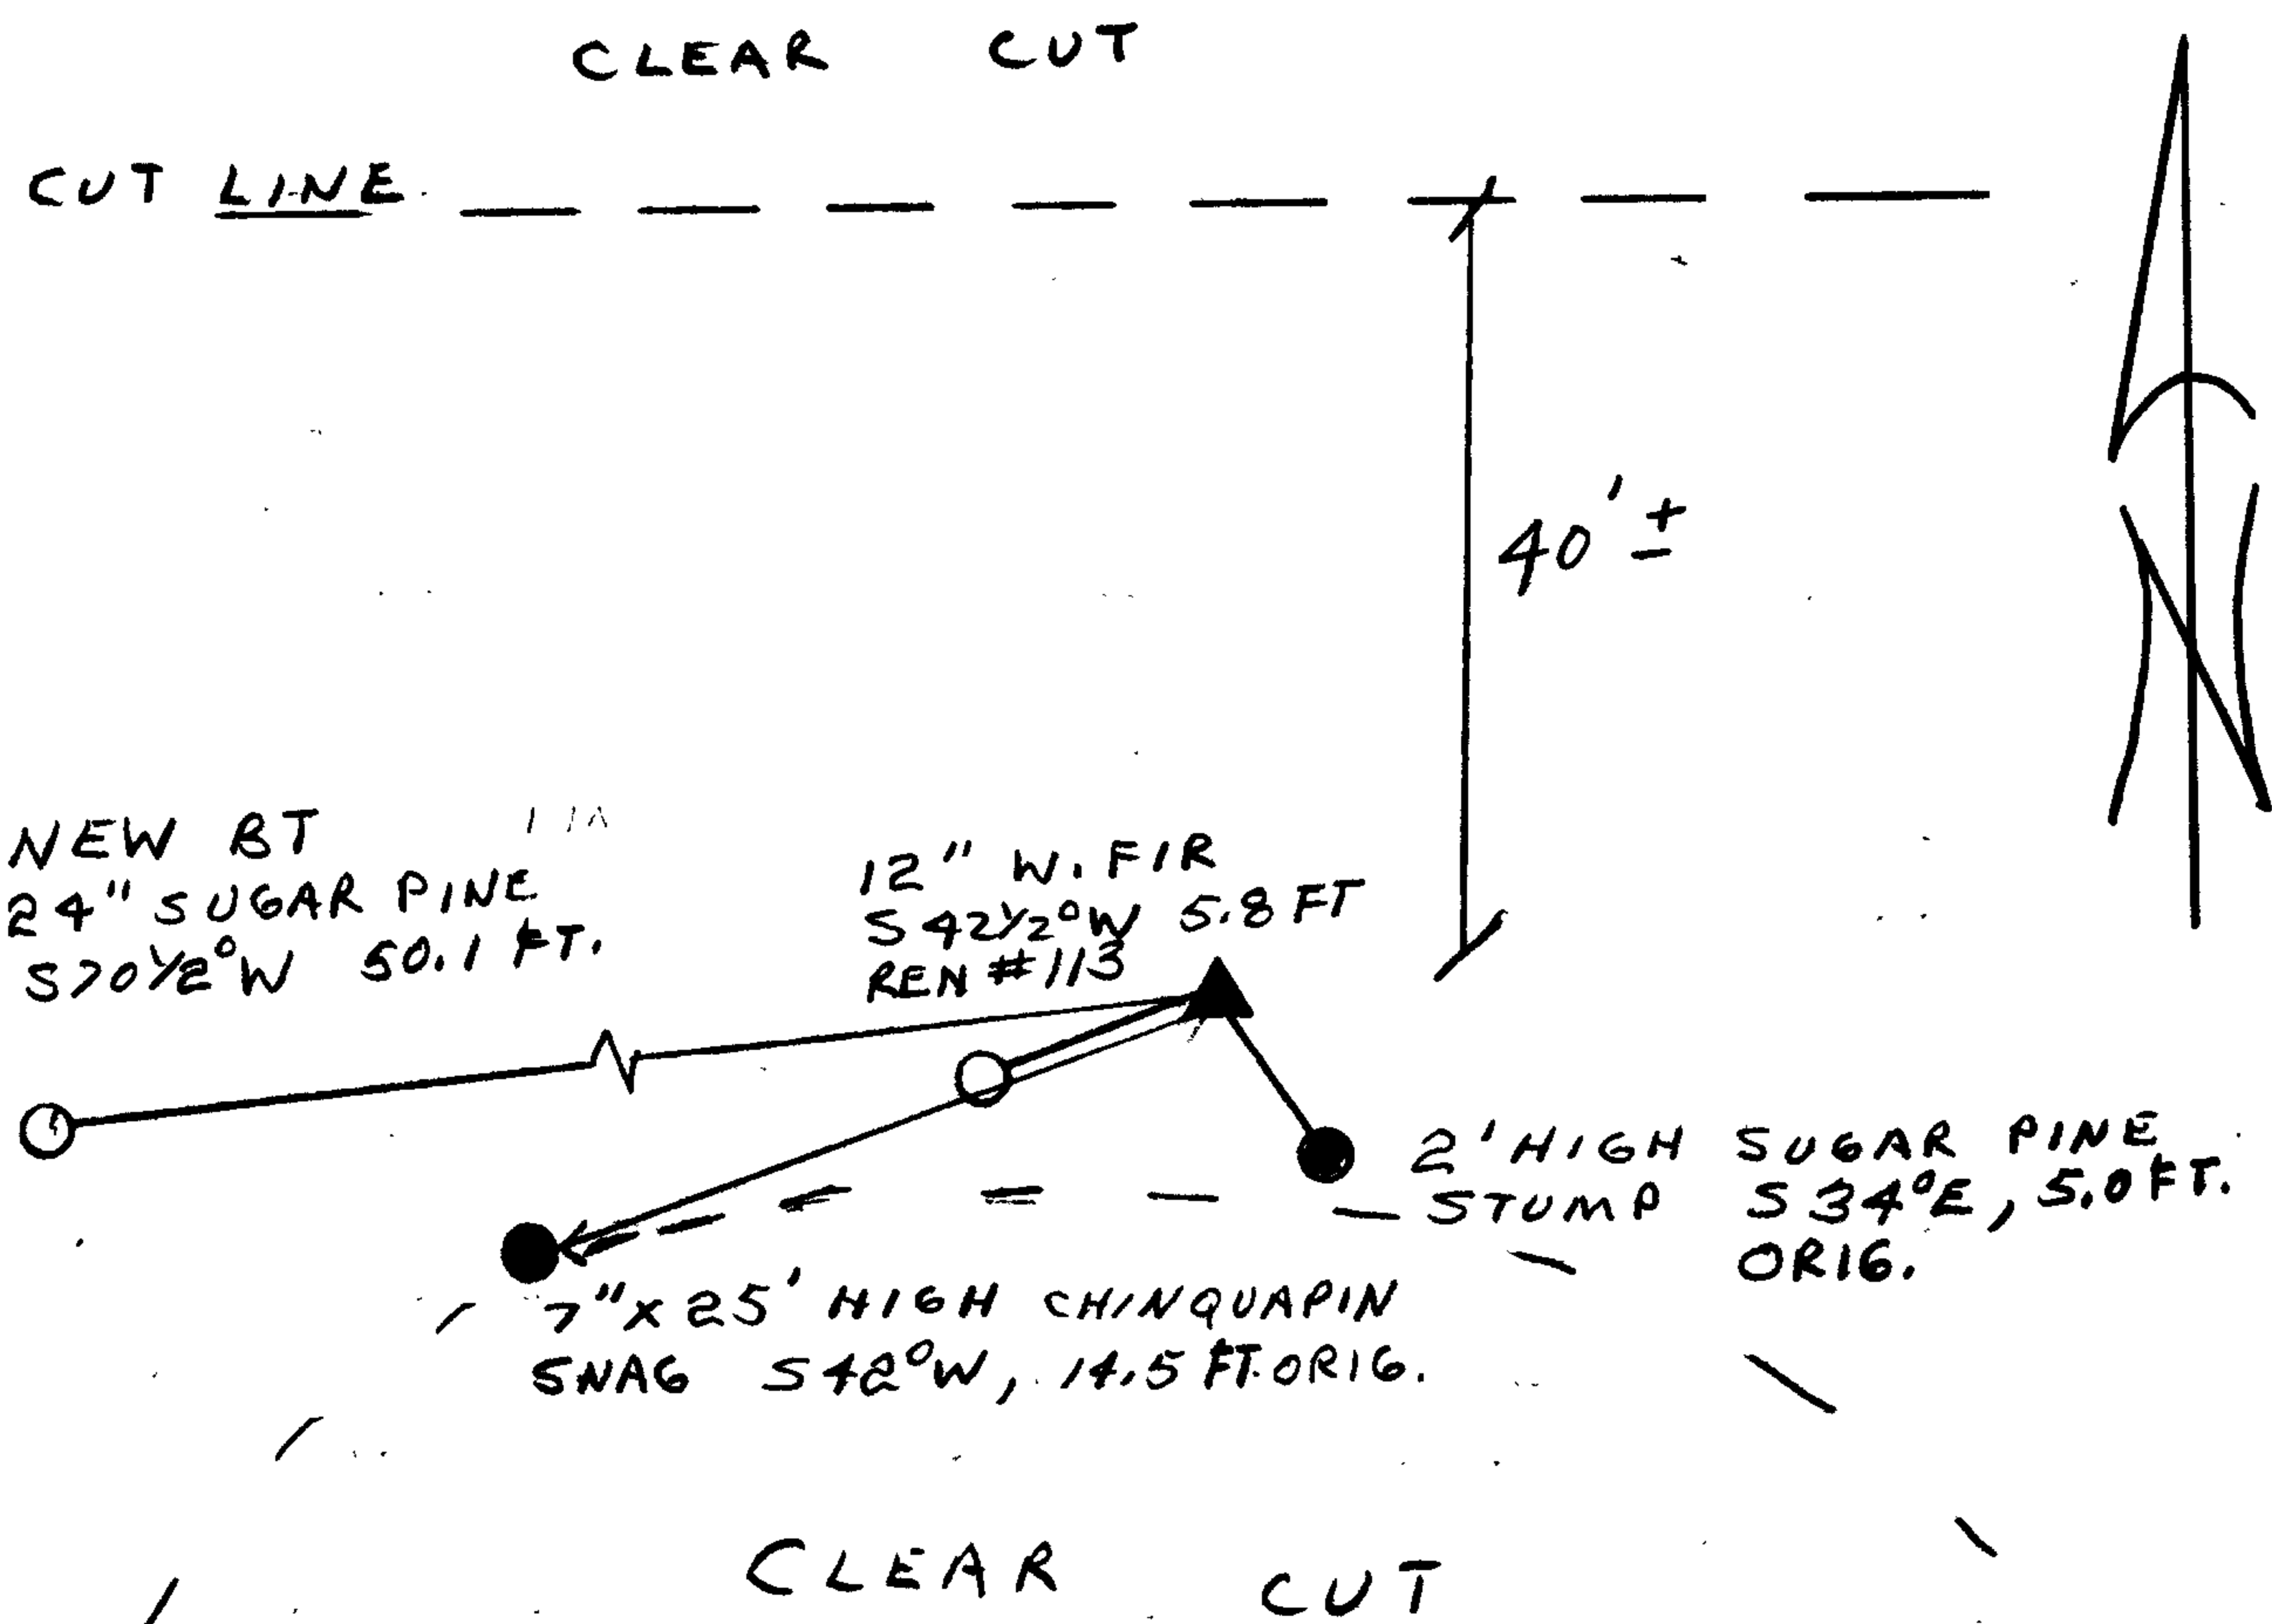

Location & Comments

FROM END OF USES RD
 #2813-607 PROCEED EASTERLY
 600± FT ALONG RIDGE AND
 CUT LINE THEN SOUTH BELOW RIDGE
 40 FT ± TO CORNER.

NO TREES AVAILABLE IN SEC. 3
 TO SCRIB.

Comp. Declin. 18 1/2° E
 Agency DLCSO
 Party Chief RANDALL W SMITH
 Notekeeper STEPHEN J. FLAUSF
 Witnesses _____

Surveyor's Seal

REGISTERED
 PROFESSIONAL
 LAND SURVEYOR

Harry E. Monrean

OREGON
 JULY 13, 1979
 HARRY E. MONREAN
 #1830