

GOVERNMENT CORNER RESTORATION FORM

Township 28S Range 8W Sec. 19 County DOUGLAS

State OR Date 10/8/85 No. _____

Corner Designation

S19	S20
S30	S29

- Condition Report Only
- Not Found
- Renewed
- Unrecorded
- Surveyed In
- Referenced Out

Previous Renewals #117, 1972 BLM DEP. RESURVEY

Monument(s) Found: (Condition and Source)

A DCSD DISK ON A I.P. PROTRUDES
15 IN. ABOVE GROUND, MARKED AS
NOTED (PER REN #117).

MONUMENT DETAIL

COUNTY SURVEYOR'S OFFICE

T 28S

S19	S20
S30	S29

R 5 W

1963

Accessories Found:

ORIG. BT'S

40" NOW A 43" DIA. 5 FT HIGH D. FIR STUMP WITH A FLAT BARK BLAZE
AND AXE MARKS "X" THAT DO NOT APPEAR TO BE ORIG. BEARS N65°E, 24.0' (REC. N65°E, 21.1')

36" NOW A 42" DIA. 4 FT HIGH D. FIR STUMP, NO MARKS VISIBLE
BEARS N20°W, 11.4 FT (REC N30°W, 10.6 FT).

28" NOW A 30" DIA. 25 FT HIGH D. FIR SNAG, PREVIOUSLY OPENED NO MARKS
VISIBLE, BEARS S60°W, 11.9 FT (AGREES WITH REC.).

SE BT GONE

REN #117 BT'S

5" NOW A 10" DIA. D. FIR WITH A FULLY HEALED SINGLE BLAZE
BEARS N32°E, 29.3 FT (REC N35°E, 29.3 FT).

10" NOW A 20" DIA. HEMLOCK WITH A FULLY HEALED SINGLE BLAZE
BEARS S77°W, 55.6 FT (AGREES WITH REC.).

12" NOW A 15" DIA. HEMLOCK WITH A FULLY HEALED DOUBLE BLAZE
BEARS N69°W, 28.8 FT TO CENTER OF ROOT CROWN (REC N69°W, 30.3 FT TO CENTER OF TRUNK)

10" NOW A 21" DIA. I. CEDAR WITH A FULLY HEALED DOUBLE BLAZE
BEARS S2°E, 38.8 FT (AGREES WITH REC.).

#183 X

RENEWAL

Monument Set (Procedure and Description)

"5" IN R5W STAMPED OUT AND REMARKED
WITH AN "8" TO CORRECT RANGE NO.

Monument Detail

COUNTY SURVEYOR'S OFFICE

T 28 S

S 19 | S 20

S 30 | S 29

R 8 W


1963

New Accessories

NONE

Sketch of Monument, Accessories, and General Area

- ▲ DCSO DISK / I.P.
- ORIG. BT'S
- REN #117 BT'S

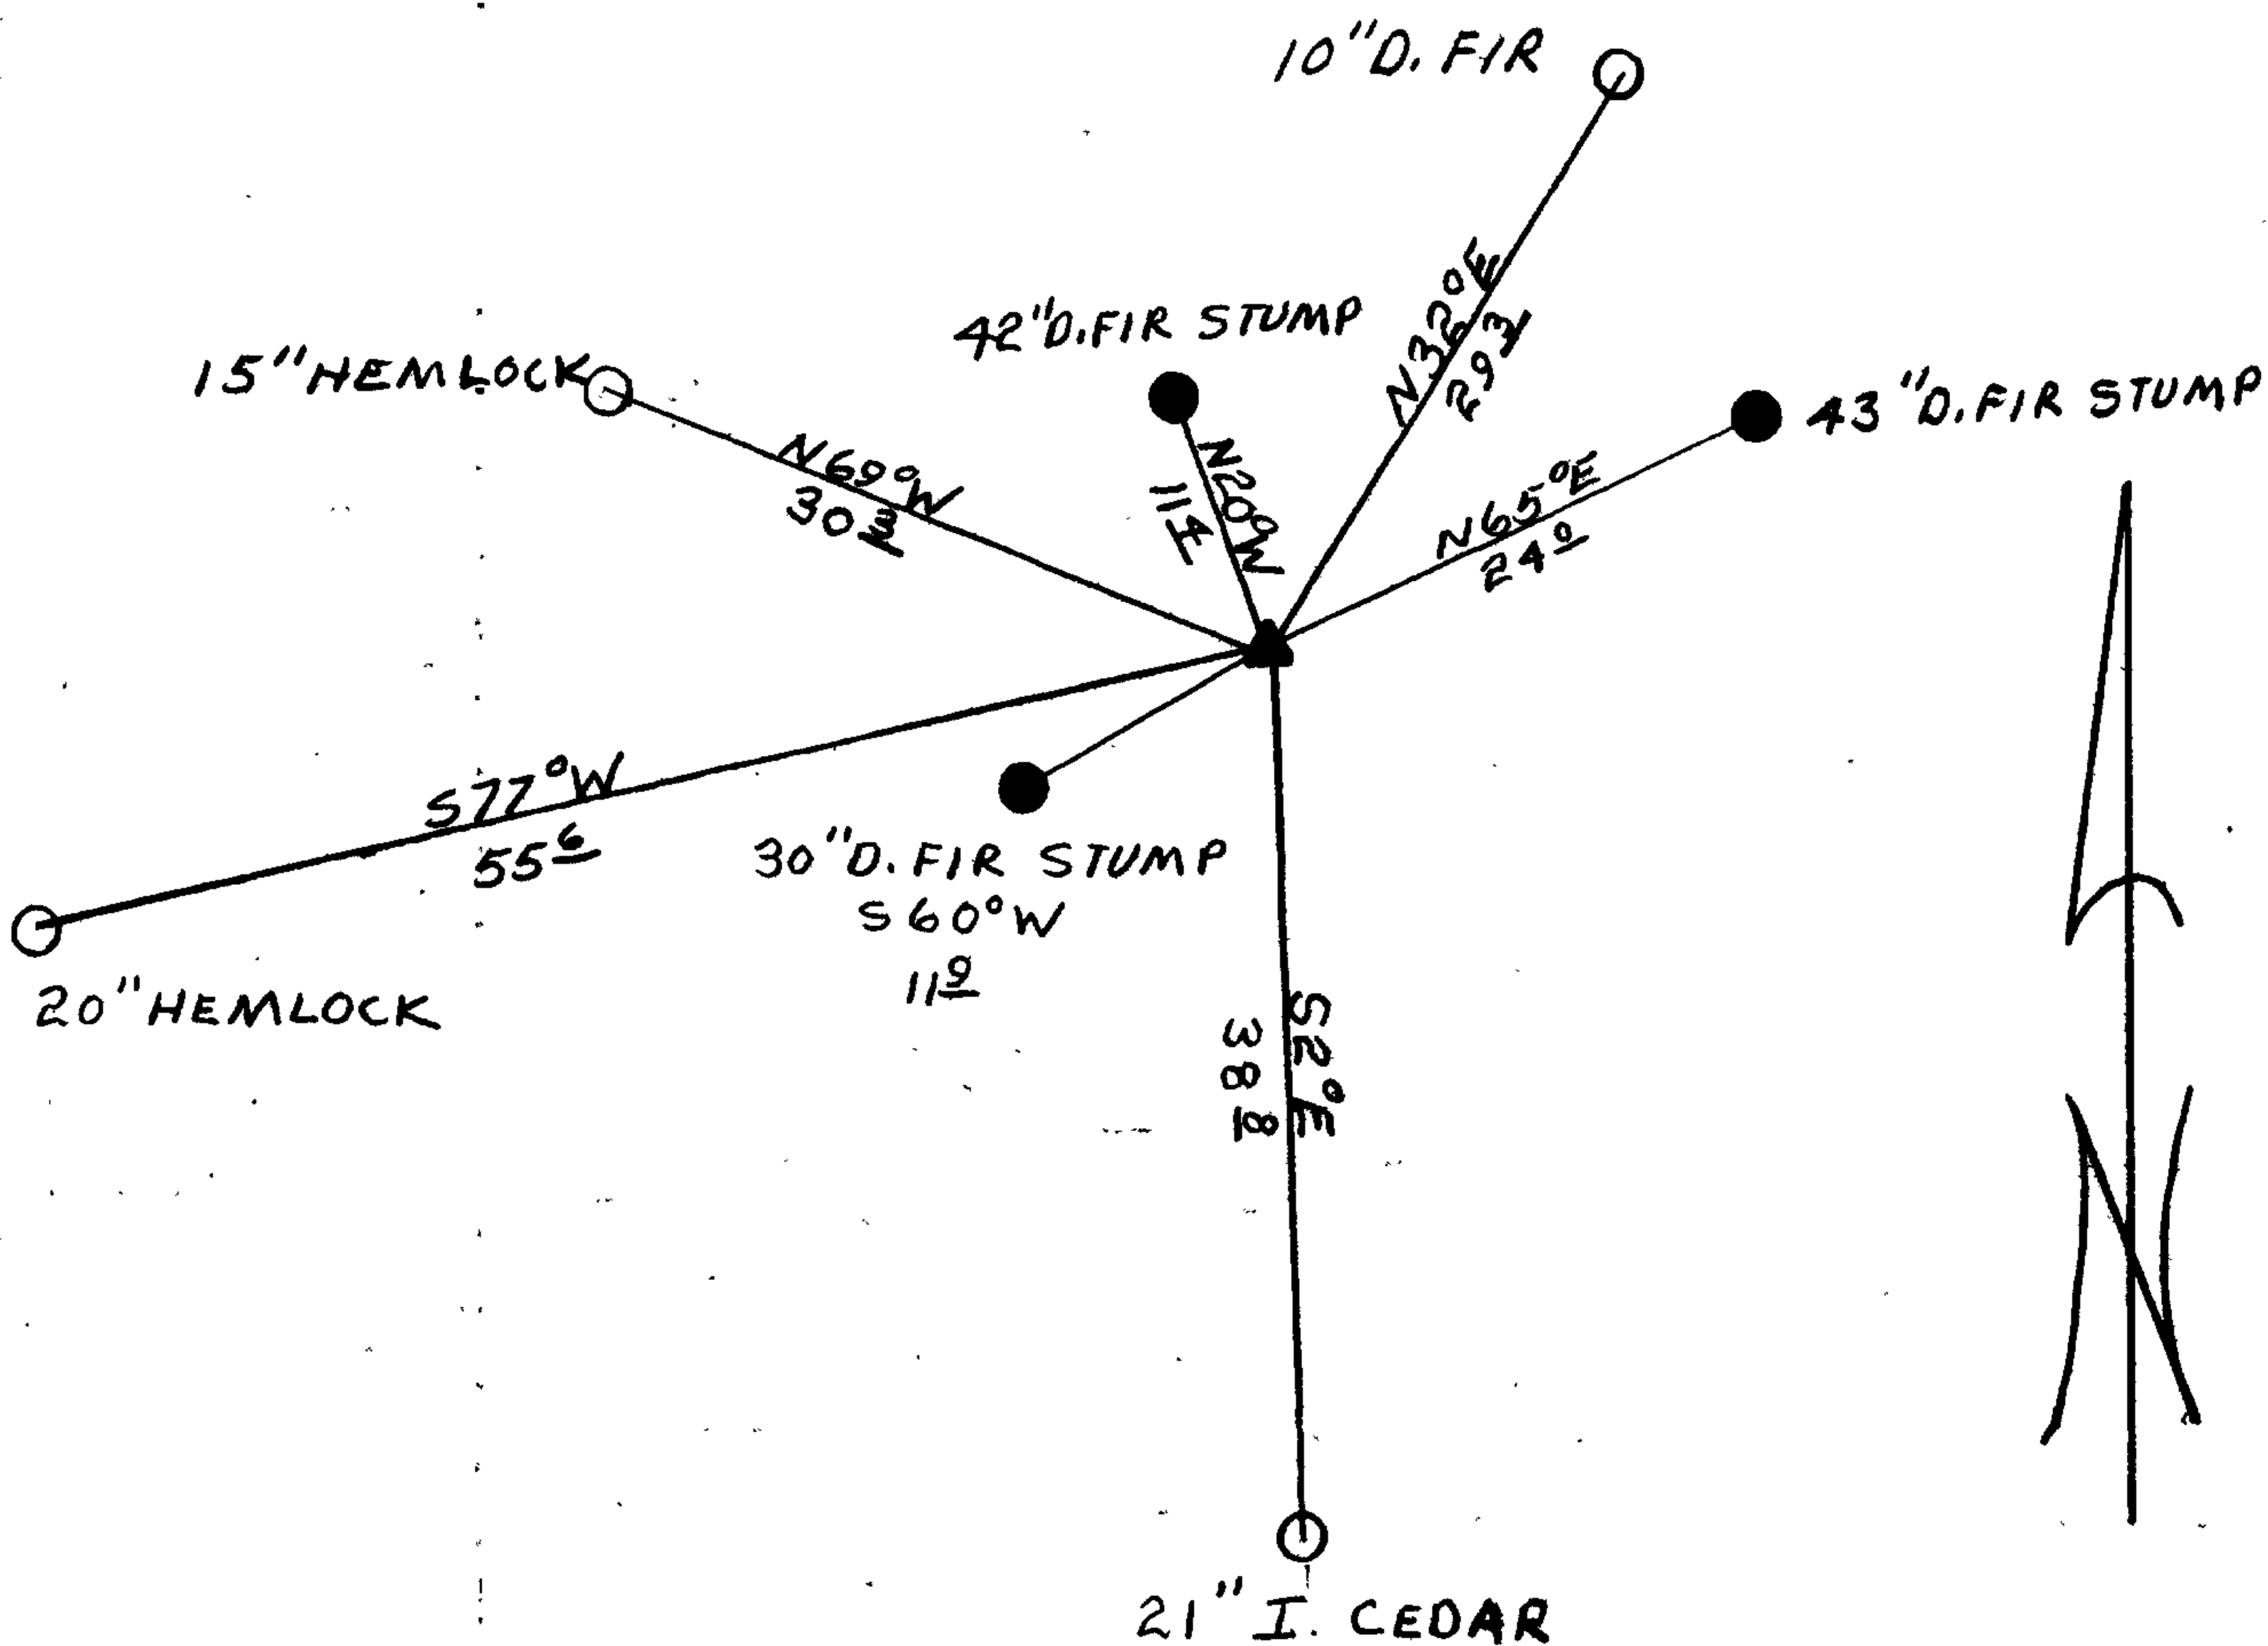

Location & Comments

COR. LIES ON A WEST SLOPE.
USING ORIG. DIST. AS FACE MEASUREMENTS
WOULD MOVE REN #117 CORNER POSITION
APPROX. 15 IN. NE OF PRESENT LOCATION.

I DON'T BELIEVE THE POSSIBLE POSITION
DIFFERENCE IS SIGNIFICANT ENOUGH
TO SET ANOTHER MONUMENT *L.M.*

Comp. Declin. 18 YR °E

Agency DCSO

Party Chief RANDALL W. SMITH

Notekeeper Randall W. Smith

Witnesses STEPHEN T. FLAISE

Surveyor's Seal

REGISTERED
PROFESSIONAL
LAND SURVEYOR

Larry E. Monrean

OREGON
JULY 13, 1979
LARRY E. MONREAN
#1830