

GOVERNMENT CORNER RESTORATION FORM

Township 31S Range 5W Sec. 1 County DOUGLAS

State OR Date 8/21/85 No. _____

RECEIVED
11/12/85
JL

Corner Designation

W.C.	S2	S1
	S11	S12

- Condition Report Only
- Not Found
- Renewed
- Unrecorded
- Surveyed In
- Referenced Out

Previous Renewals ~~#10~~ #105

Monument(s) Found: (Condition and Source)

A DCSD DISK ON A L.P. PROTRUDES
6 IN. ABOVE GROUND MARKED
AS NOTED PER REN #10.

COUNTY SURVEYORS OFFICE
T31S R5W

W.C.	S2	S1
	332' N. TO S11	S12

1969

Accessories Found:

PER REN ~~#10~~ #105
8" NOWA 11" DIA D.FIR. WITH A DOUBLE WELL HEALED BLAZE
BEARS N51°W, 15.9 FT (REC N48°W, 16.9 FT DIST IS A SLOPE
DIST).

10" NOWA 12" DIA. D.FIR WITH A DOUBLE WELL HEALED BLAZE
BEARS S86°E, 29.9 FT. (REC N85°E, 30.4 FT. BRG. IS IN WRONG
QUAD., DIST IS A SLOPE DIST TO FACE OF BLAZE)

5/8" I.R. R/W PIN AT STA. 188+64.57 BEARS S71°E, 26.35 FT
(REC S65°E, 26.35 FT). (A R/W SIGN AND POST IS NORTH
0.5 FT FROM 5/8" I.R.)

#117X

RENEWAL

Monument Set (Procedure and Description)

Monument Detail


NONE

N/A

New Accessories

A DCSO BRASS STEM IN BRIDGE DECK (PTS-18) BEARS $N 76^{\circ} 41' 26'' W, 622.38'$ (grid)

Sketch of Monument, Accessories, and General Area

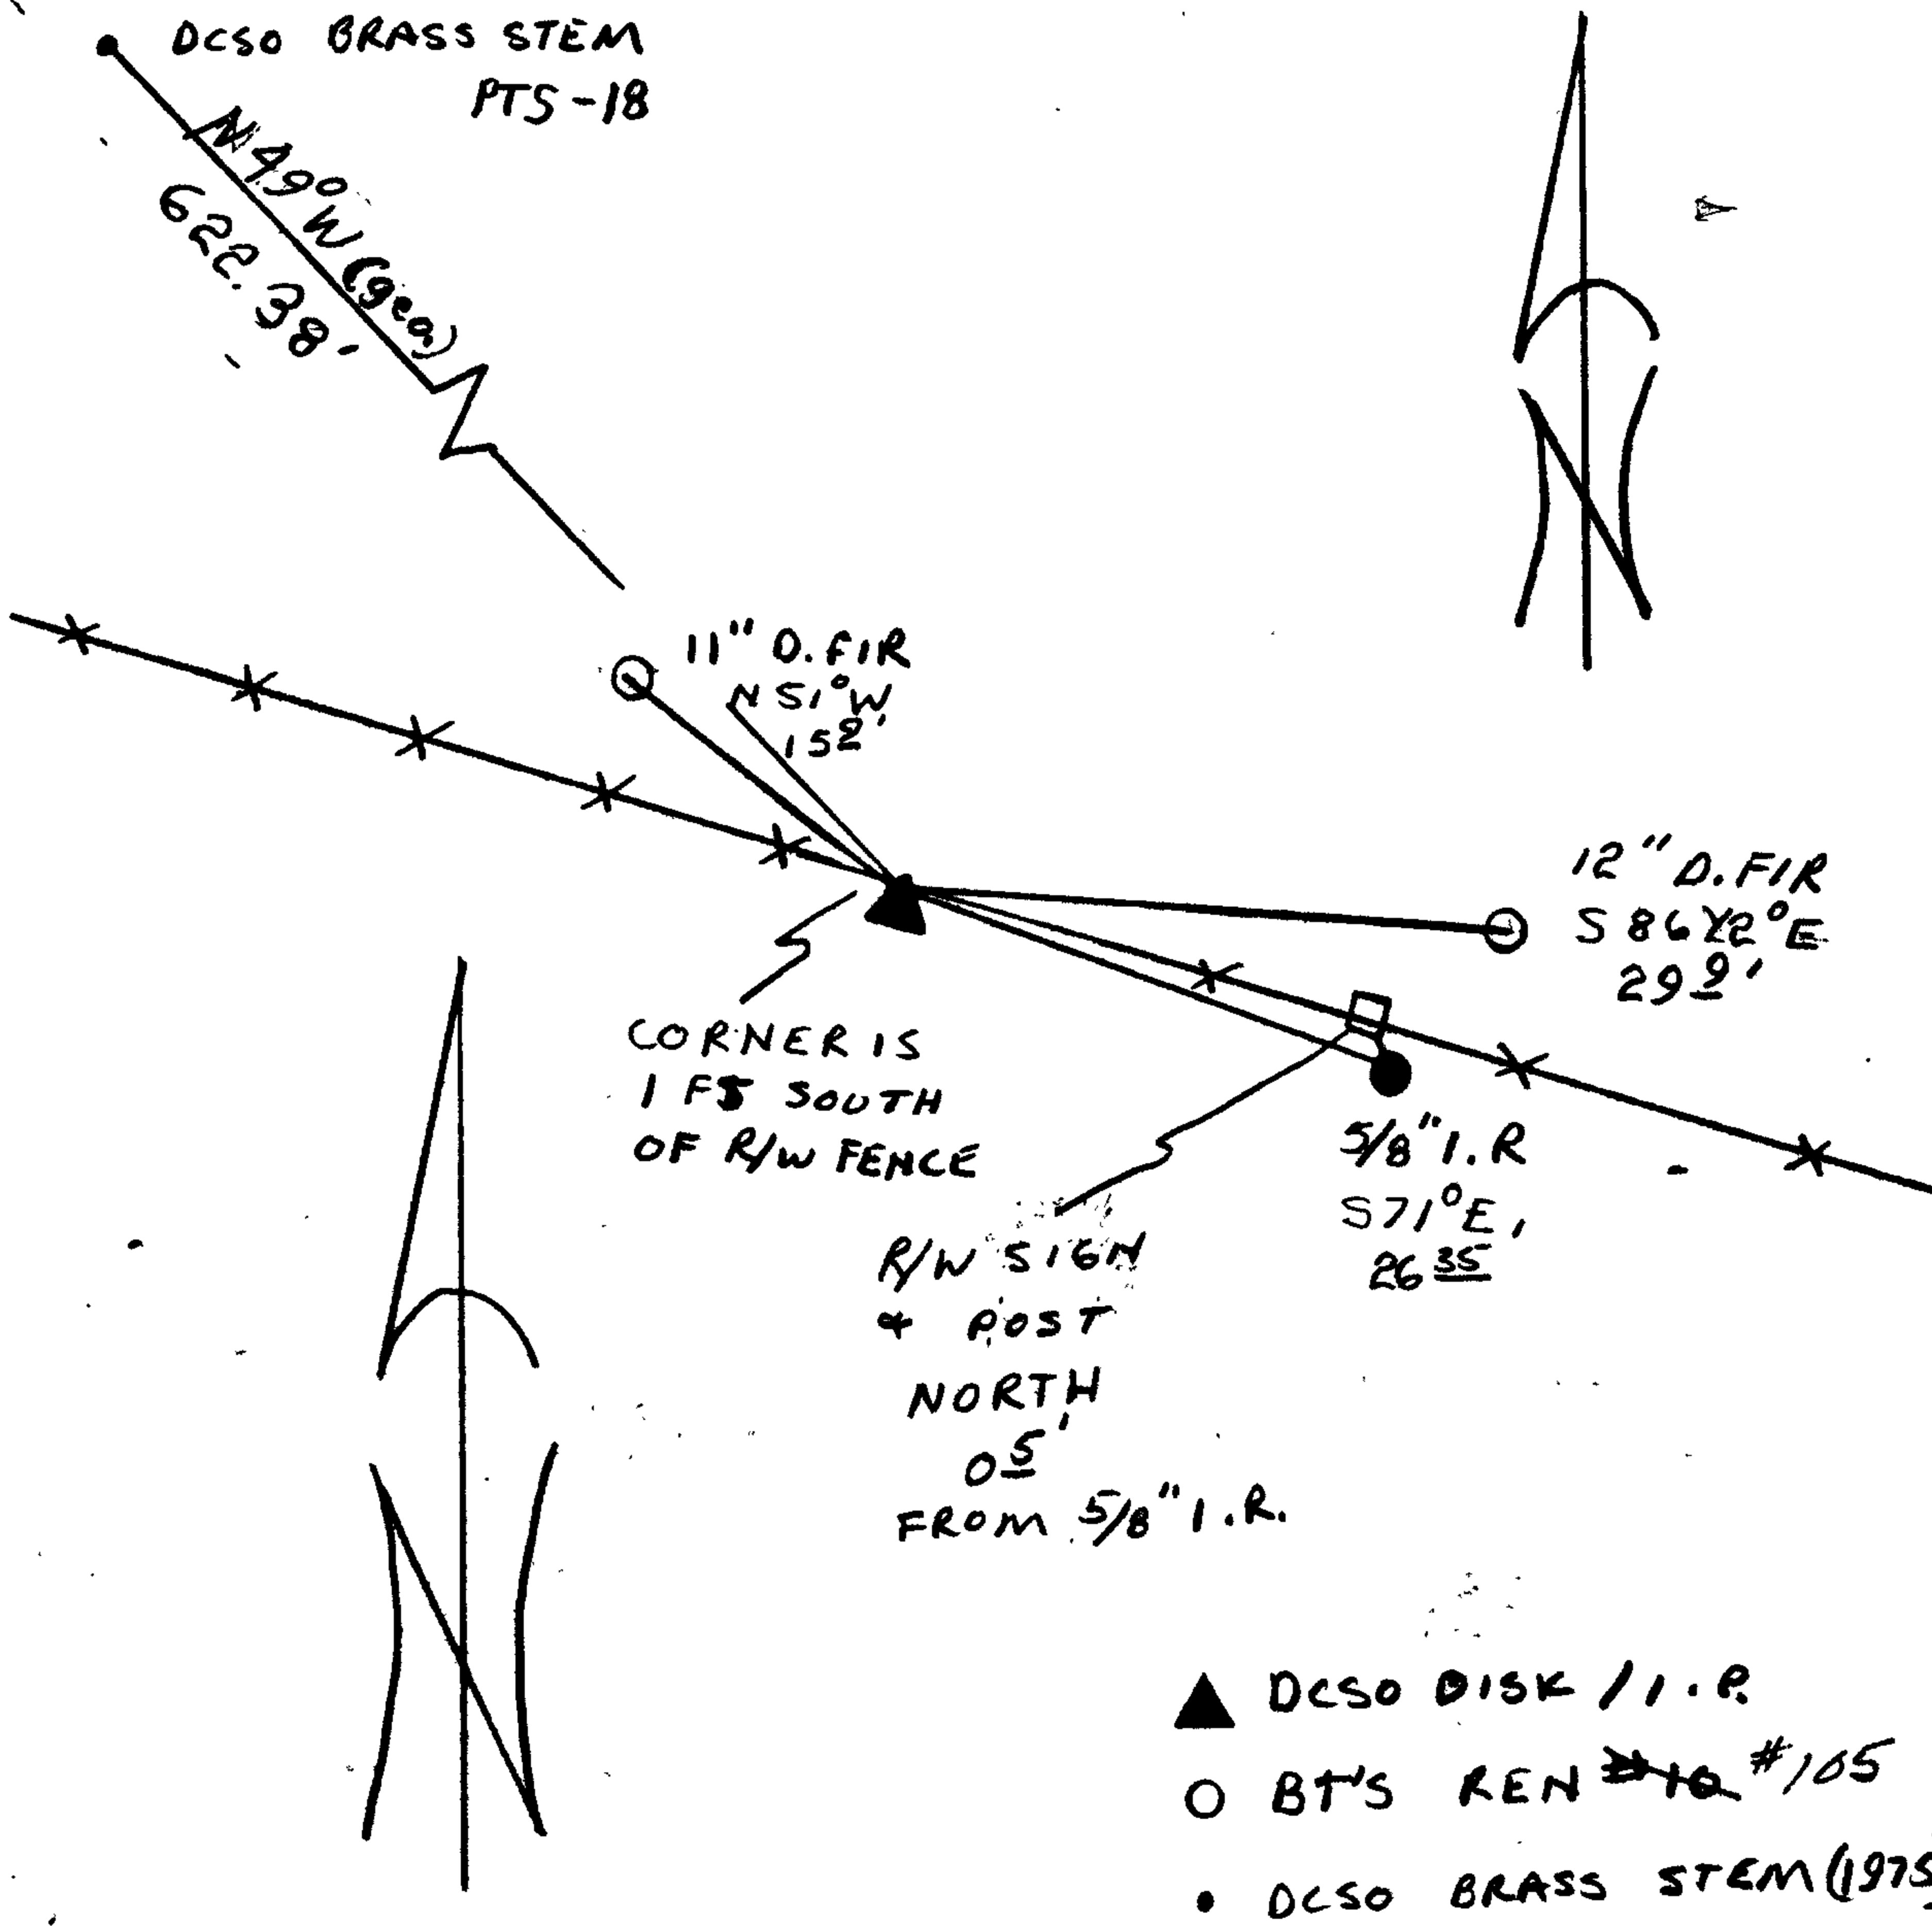

Location & Comments

COR. IS APPROX 250' SOUTH OF THE SOUTH BOUND LANES OF I-5, AND 1 FT SOUTH OF THE SOUTH R/W FENCE OF I-5 ON A STEEP NORTH SLOPE

Comp. Declin. $18^{\circ} 20' E$
Agency DCSO
Party Chief RANDALL W SMITH
Notekeeper Randall W Smith
Witnesses STEPHEN J FLAUSE

Surveyor's Seal

REGISTERED
PROFESSIONAL
LAND SURVEYOR

Larry E. Monrean

OREGON
JULY 13, 1979
LARRY E. MONREAN
#1830