

FILED *JL*

OREGON CORNER RESTORATION FORM

MAY 2 1986

Section 22 Township 19S Range 8W

COUNTY SURVEYOR
DOUGLAS COUNTY, ORE.

County Douglas Date 01-24-85

Corner Designation

West $\frac{1}{4}$ Corner
Section 22

- Condition Report Only
- Not Found
- Renewed
- Unrecorded
- Surveyed In
- Referenced Out

Previous Renewals/Surveys, etc. C.M. Collier's 1891 G.L.O. Survey and 1952 G.L.O. Dependent Resurvey.

Monument(s) & Accessories Found: (Condition and Source)


1952 G.L.O. Brass Cap set firmly in ground.

48" Fir, S55E, 28.4' (Scar Vis.), 1891 BT. Rec. S55E, 28.4'

18" Maple, S29W, 35.3' (Scar Vis.), 1891 BT. Rec. S25W, 34.3'

20" Fir, S83W, 20.3' (Scar Vis.), ? BT.

Monument Detail

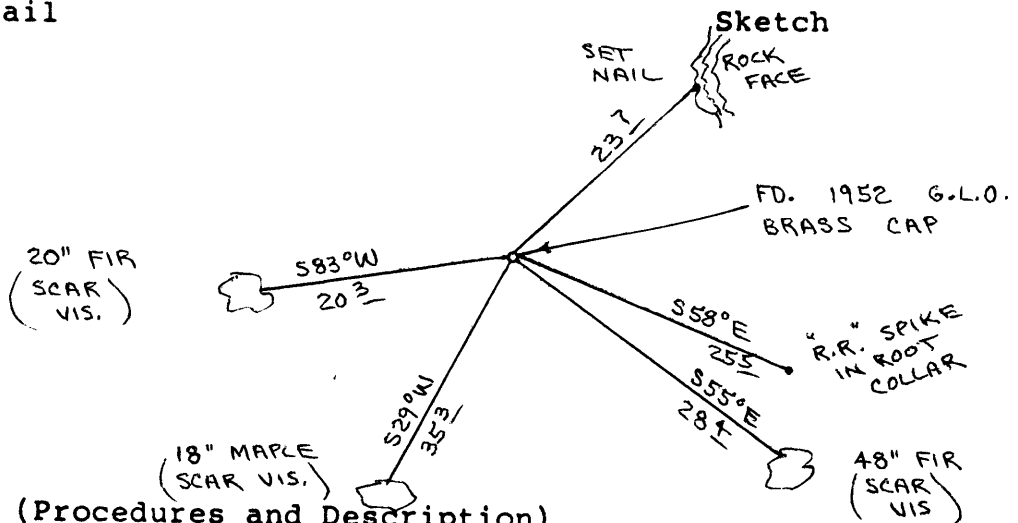

Monument Set (Procedures and Description)

Set additional corner R.P's because of planned logging activity in near future.

New Accessories

Set nail in rock face, 23.7' (Distance tie)

Set "R.R." spike in root collar of 48" Fir, S58E, 25.5'

Location & Comments

Corner lies on steep West slope about 250' West of rock road

Compass Declination $20\frac{1}{2}$

Firm/Agency Roberts Surveying Inc.


Address 29 West 29th Street, Eugene, Oregon

Party Chief Les Roberts

Notes Marion Hunter

Witness

Surveyor's Seal

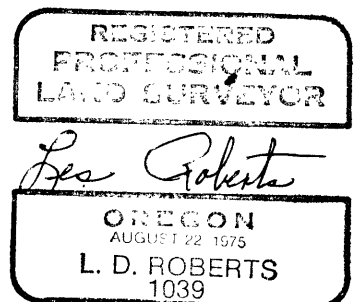

C.S. File No. 62/30-4