

FILED

*JS*

OREGON CORNER RESTORATION FORM

MAY 2 1986

Section 27 Township 20S Range 9W

County Douglas Date 03-13-86

COUNTY SURVEYOR  
DOUGLAS COUNTY, ORE.

Corner Designation

West  $\frac{1}{4}$  Corner  
Section 27


- Condition Report Only
- Not Found
- Renewed
- Unrecorded
- Surveyed In
- Referenced Out

Previous Renewals/Surveys, etc. William Thiel's 1877 G.L.O. Survey; 1953 G.L.O. Survey and Survey by Roberts Surveying Inc. dated September 12, 1983

Monument(s) & Accessories Found: (Condition and Source)

Found 1953 G.L.O. Brass Cap set firmly in ground.  
32" Maple, S46E, 21.3' (Scar Vis.), 1953 BT. Rec. S43 $\frac{1}{4}$ E, 19.8'  
48" Cedar, N46W, 22.7' (No Marks), 1953 BT. Rec. N46W, 21.8'

Monument Detail

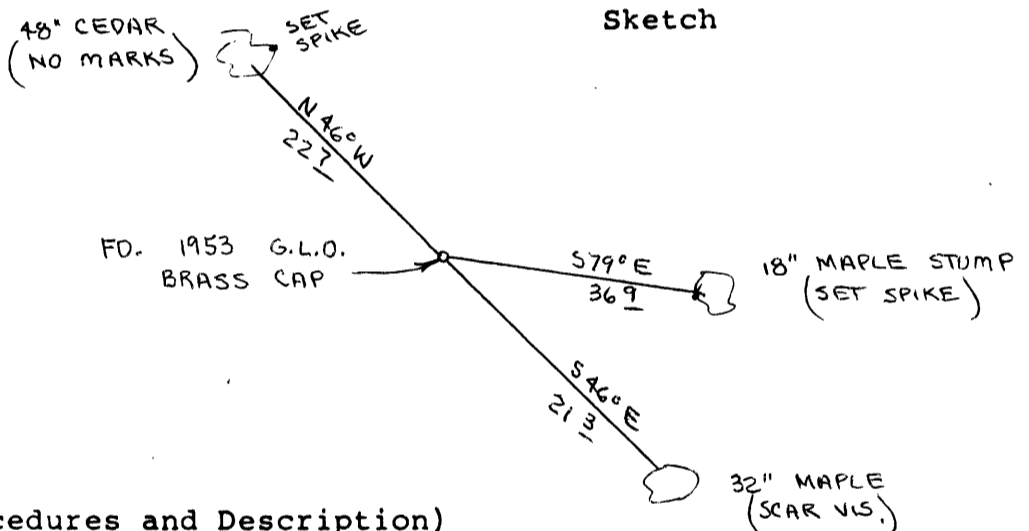

Monument Set (Procedures and Description)

Set additional corner R.P's because of planned logging activity in near future.


New Accessories

Set 8" spike in base of 48" Cedar. Cedar bears N45W, 21.3'  
Set 8" spike in side of 18" Maple Stump. Spike bears S79E, 36.9'

Location & Comments

Corner lies on steep East slope about 350' West of West Branch Road  
Compass Declination 20 $\frac{1}{2}$   
Firm/Agency Roberts Surveying Inc.  
Address 29 West 29th St. Eugene, Oregon 97405  
Party Chief Les Roberts  
Notes Ted Baker  
Witness \_\_\_\_\_

Surveyor's Seal

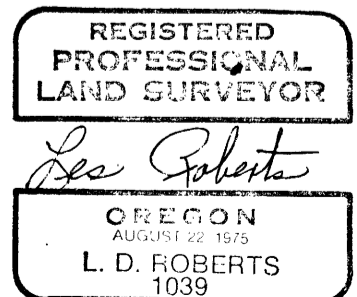

C.S. File No. 62/30-6