

FILED

MAY 2 1986

OREGON CORNER RESTORATION FORM

Section 27 Township 20S Range 9W

County Douglas Date 03-13-86

COUNTY SURVEYOR  
DOUGLAS COUNTY, ORE.

Corner Designation

South  $\frac{1}{4}$  Corner  
Section 27

- Condition Report Only
- Not Found
- Renewed
- Unrecorded
- Surveyed In
- Referenced Out

Previous Renewals/Surveys, etc. Wm. Thiel's 1877 G.L.O. Survey;  
Tillman and Gawron's 1953-1954 G.L.O. Survey; Glenn and Jelley's  
1967 B.L.M. Survey and Survey by Roberts Surveying Dated 03-15-84

Monument(s) & Accessories Found: (Condition and Source)


Found 1953 G.L.O. Brass Cap set firmly in ground.

50" Fir, S59W, 76.4' (Scar Vis.), 1953 BT. Rec. S59W, 72.6'

N.E. Maple BT set in 1953 is gone.

6" Alder, N16E, 13.6' (Scribe Vis.), 1967 BT. Rec. N18E, 13.9'

Monument Detail

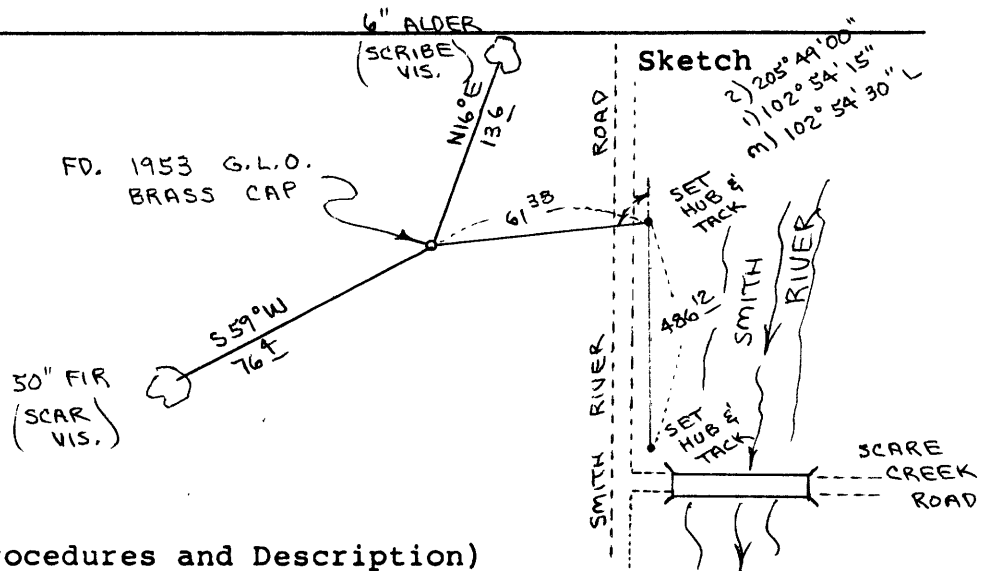

Monument Set (Procedures and Description)

Set additional corner R.P.'s because of planned logging activity  
in near future.

New Accessories

Set hub and tack R.P.'s with transit, see sketch.

Location & Comments

Corner lies on steep East slope about 50' West of Smith River Road. Corner is also about 500' North of Scare Creek Bridge.

Compass Declination 20 $\frac{1}{2}$   
Firm/Agency Roberts Surveying Inc.  
Address 29 West 29th St. Eugene, Oregon 97405  
Party Chief Les Roberts  
Notes Ted Baker  
Witness \_\_\_\_\_

Surveyor's Seal

REGISTERED  
PROFESSIONAL  
LAND SURVEYOR

*Les Roberts*  
OREGON  
AUGUST 22 1975  
L. D. ROBERTS  
1039

C.S. File No. 62/30-7