


CERTIFIED RECORD OF LAND CORNER MONUMENTATION

History of original corner establishment:

THIS CORNER WAS SET IN 1966 BY THE COUNTY SURVEYOR'S OFFICE.

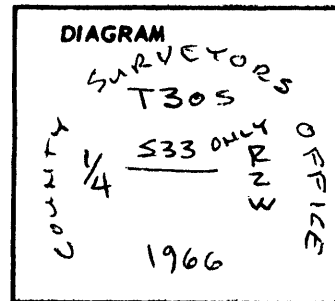

FILED

[Signature]
NOV 14 1986

COUNTY SURVEYOR
DOUGLAS COUNTY, ORE.


Description of corner evidence found:

Found A 2 1/2" BRASS CAP ON A 1" IRON PIPE IN A MOUND OF ROCK.

Description of monument and accessories I established to perpetuate the original location of this corner

Found A 8" HEMLOCK (SNAG) WHICH BEARS N 29 3/4° E 26.2', SCRIBE VISIBLE.
Found A 28" FIR STUMP WHICH BEARS S 01 3/4° W 6.6', SCAR VISIBLE.
Found A 22" CEDAR (DEAD) WHICH BEARS N 21 1/2° W 12.4', SCRIBE VISIBLE.
I MARKED A 28" FIR WHICH BEARS N 31° E 96.4', SCRIBED 1/4 S33 BT.
I MARKED A 24" FIR WHICH BEARS N 43° W 60.6', SCRIBED 1/4 S33 BT.
BOTH NEW BTS HAVE LS ⁹⁴⁴ BRASS WASHER NAILED TO BT SCRIBE.

DATE: OCT., 1986

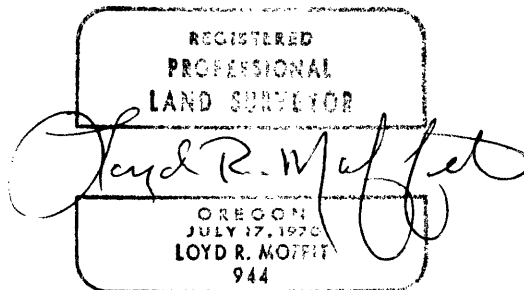

Office of... Surveyor..... County of... Douglas.....
State of Oregon....., I hereby certify that the within instrument was filed in this office
for record on the 14 day of November, 1986.
Fritz Ingram by *[Signature]*
(COUNTY OFFICIAL) (DEPUTY)

269 T.30-2 X
225 T.31-2 X
Form R6-7100-57 (9/71)

C.S. File No. 62/30-9
☆ GPO 796-333