


CERTIFIED RECORD OF LAND CORNER MONUMENTATION

History of original corner establishment:

THIS CORNER WAS SET IN 1966 BY THE COUNTY SURVEYOR'S OFFICE

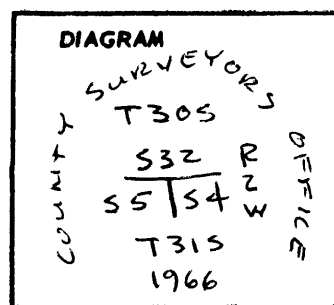

FILED

JR

NOV 14 1986

COUNTY SURVEYOR
DOUGLAS COUNTY, ORE.


Description of corner evidence found:

FOUND A 42" FIR CORNER TREE WITH SCRIBE VISIBLE. A 2 1/2" BRASS CAP ON A 1" IRON PIPE IS ON SOUTH SIDE OF TREE.

Description of monument and accessories established to perpetuate the original location of this corner

FOUND REMAINS OF FIR BT S 70 3/4° E 17.8' (STEEL FENCE POST WITH SIGNS STAND WHERE TREE WAS).
FOUND 24" MADRONE WHICH BEARS S 05 1/2° W 18.7', SCRIBE VISIBLE.
I SCRIBED A 8" FIR WHICH BEARS S 25° E 20.1', MARKED T315 R2W S4 BT WITH A L.S. BRASS WASHER NAILED TO BT SCRIBE.

DATE: OCT., 1986

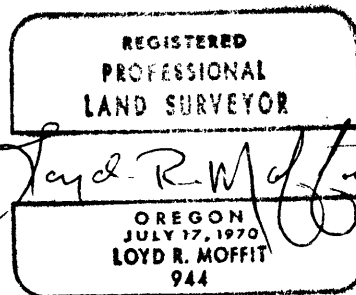

Office of Surveyor County of Douglas
State of Oregon , I hereby certify that the within instrument was filed in this office for record on the ..14.. day of ..November,....1986..
.....Fritz Ingram..... by *Virginia Sargent*.....
(COUNTY OFFICIAL) (DEPUTY)

270 T30-2 X
226 T31-2 X
Form R6-7100-57 (9/71)

C.S. File No. 62/30-11
☆ GPO 796-333

e