


CERTIFIED RECORD OF LAND CORNER MONUMENTATION

History of original corner establishment:

THIS CORNER WAS SET IN 1963
BY THE B.L.M.

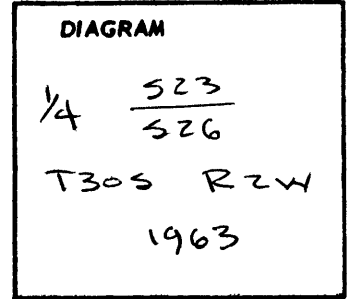

FILED

JL

NOV 14 1986

COUNTY SURVEYOR
DOUGLAS COUNTY, ORE.


Description of corner evidence found:

Found 2" GAL. IRON PIPE WITH A 3" BRASS CAP

Description of monument and accessories established to perpetuate the original location of this corner

Found A 32" FIR STUMP N06°E 16.5', SCRIBE VISIBLE.
Found A 16" FIR WHICH BEARS S44 1/4°E 99.6', SCAR VISIBLE.
I SCRIBED A 8" FIR BT WHICH BEARS N17°W 30.8',
MARKED 1/4 S 23 BT, WITH LS 944 BRASS WASHER
NAILED TO BT SCRIBE.

DATE: OCT., 1986

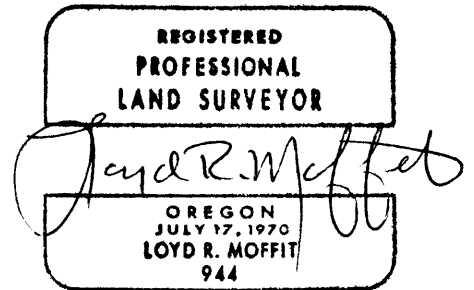

Office of.....Surveyor..... County of.....Douglas.....
State of.....Oregon....., I hereby certify that the within instrument was filed in this office
for record on the 14 day of November 1986
Fritz Ingram by *Virginia Saenger*
(COUNTY OFFICIAL) (DEPUTY)

#268X