


CERTIFIED RECORD OF LAND CORNER MONUMENTATION

History of original corner establishment:

THIS CORNER WAS SET IN 1917 BY THE G.L.O. IT IS IN T295, R²W, W.M.

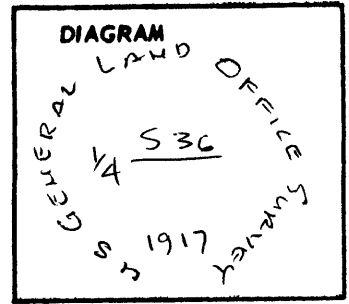

FILED

JL
NOV 14 1986

COUNTY SURVEYOR
DOUGLAS COUNTY, ORE.


Description of corner evidence found:

Found A 2 1/2" BRASS CAP ON A 1" IRON PIPE.

Description of monument and accessories I established to perpetuate the original location of this corner

Found A FIR STUMP WHICH BEARS N37°W 31.7' (TO CTR OF TREE), SCAR VISIBLE.
Found A 17" FIR WHICH BEARS N45°E 11.9', SCARS VISIBLE.
Found A ROTTED FIR STUMP WHICH BEARS N51°E 23.1', OLD FACE VISIBLE.
I MARKED A 12" FIR WHICH BEARS N38°E 31.9', SCRIBED
1/4 S36 BT WITH L.S. WASHER #944 MALLED TO BT SCRIBE.

DATE: OCT., 1986

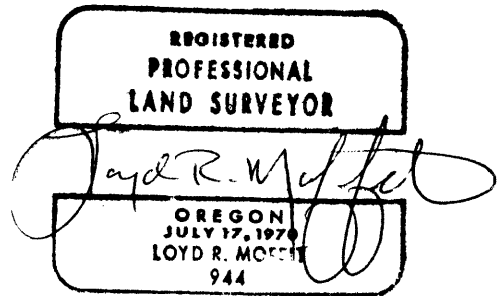

Office of.....Surveyor..... County of.....Douglas.....
State of.....Oregon....., I hereby certify that the within instrument was filed in this office
for record on the ...14... day of ..November,....1986....
.....Fritz Ingram..... byVirginia Lagan.....
(COUNTY OFFICIAL) (DEPUTY)

#121 T.29-2 X
#267 T30-2 X