


CERTIFIED RECORD OF LAND CORNER MONUMENTATION

History of original corner establishment:

THIS CORNER WAS SET IN 1967 BY
O.R.E. 4906 FOR THE U.S.D.A.
CORNER IS IN T.30S., R.2W., W.M.

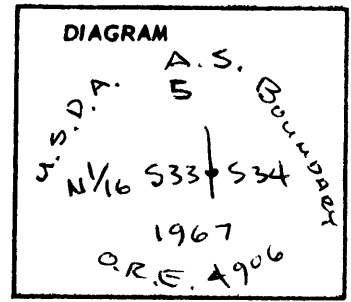

FILED

LL
NOV 14 1986

COUNTY SURVEYOR
DOUGLAS COUNTY, ORE

Description of corner evidence found:

FOUND 2 1/2" BRASS CAP IN CONCRETE


Description of monument and accessories I established to perpetuate the original location of this corner

FOUND 17" PINE BT STUMP WHICH BEARS N 17° E 36.3', SCRIBE VISIBLE.
I SCRIBED A 8" FIR WHICH BEARS S 28 1/2° E 43.3', MARKED N 1/16
S 34 BT

I MARKED A 6" MADROUE BT WHICH BEARS S 78° W 16.5',
MARKED N 1/16 S 33 BT

BOTH BTs HAVE LS 944 BRASS WASHER NALLED TO BT SCRIBE.

DATE: OCT., 1986

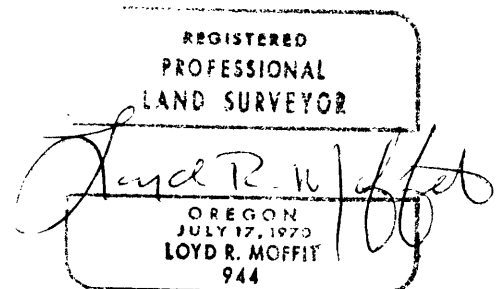

Office of Surveyor..... County of Douglas
State of Oregon....., I hereby certify that the within instrument was filed in this office
for record on the 14 day of November, 1986.
Fritz Ingram..... by *Virginia P. Ingram*
(COUNTY OFFICIAL) (DEPUTY)